 
CITY OF NEW BEDFORD

APPLICATION FOR LAYING DRAIN

Permit #2142	6
Application N: 19131 08/19/1987	Board of Health Permit No.
To the Movement City Council.	New Bedford, Mass., April 17, 1970
To the Mayor and City Council: I hereby request that a drain be laid from the	e premises of Therese Cote
ss Mc Dee St. 150'e of	Acustnet Avenue
982 miger	
CIPLANCE AS SCIENCES	Zee street,
the same to be laid in the street and the surface Works.	e repaired as directed by the Commissioner of Public
I hereby agree to pay at the office of the Cit the manner specified, in excess of the deposit m the work.	y Treasurer all cost of performing the above work in ade herewith, within 10 days after the completion of
payment of the cost of performing the work dor be returned to me by the City Treasurer.	it made with this application shall be applied to the ne, and that any excess of deposit over the cost shall
Witness L. Bruant Min	Dherese Cate Property owner
26	Property owner 54 auchnet and.
	Sland Limiting
By	
Requires separate entrance for roof water	22 8 9 acushnet Ceve, Address
Consent of Own	ner of Private Drain
To the Mayor and City Council:	New Bedford, Mass.,
I hereby grant to	
the privilege of draining premises	
through the private drain owned by me connecti-	ng with sewer in
	street.
	Owner
Estimate and D	eposit Requirement
	nissioner of Public Works,
	300 00 00 00 00 00 00 00 00 00 00 00 00
My estimate of the cost of laying the drain of	described in the above application is
•	1201100
Entrance_charges	Total deposit required 274.00
	Commissioner of Public Works
Certifico	ate of Issue
	Office of City Clerk,
The above application, accompanied by Cit-	y Treasurer's receipt presented this day; whereupon
Permit No. 19131 was issued,	and the Commissioner of Public Works notified of the
same.	Eller M. Laughar RB. City Clerk
Laid from main in street to iron pipe in property.	RB. City Clerk
Owner agrees to supply all necessary	
Viansile pipe.	



	NOTICE TO COMMISSIONER OF PUBLIC WORKS
	Length of drain 85 R3
	Sewer depth 5 pipe system
	Surf. drain
	Drain Permit Nº 19131 City of New Bedford,
	Office of City Clerk, April 17,1970
	To Commissioner of Public Works. Permission has this day been issued to
	Therese Cole 2654 Houshnet Avenue
PAID	By Lenveux Plumbing & Heating 2283 Plushnet Avenue Address Address
	to lay drain from the premises of Kerese Cote
	2 s. Mc Lee St. 150'e of Acushnet Avenue
	to connect with the sewer in Mc Zel street.
	Laid from main in street to iron pipe in property. Owner agrees to supply all necessary Liansite pipe. Clerk.
9	Liansite pipe. Requires separate entrance for sewage and roof water Jain to stay at least 10 west of e propline

RETURN OF FOREMAN

Entered APRIL - 22 ND	19 70
Time	
By So for &	au
COST	
Labor hours @	1
Joseph Alfonso llhrs.@2000	27.50
idgio Botelho llhrs @1920	26,40
bert St.Pierrellhrs @1880	25.85
sse Tavares 11hrs.@2120	29.15
hn Ambra 11hrs.@1960	26,95
	135.85
Stock / BAR-CEMENT 165	83
YOCKBS-SAND @ D99	18
REPLACE-1287 X21/2 PT-B.C.ON ROAD	
@ Xxx +57	3164
-	
Trucking	
MESIO TRUCK @ 300	60
WEST 44 COMPRÉSSOR	333
MIL 35-BACKAOE @ 6,50	45 85
Total Cost	223,7
Estimate-cost of laying drain 274 00	
Entrance charges ASSESSED	
Total deposit	
Balance due Limeur	50 30
Pieces pipe to curb /-/ofT-/-2fT	-6-IN
" curb to house 8 10FT-1-2	FT-6-10
Cut at sewer 51/2 FT	
Cut at curb 3 ft	
Size of pipe & - YN-TRANSITE - PIPE	
Correct	
10/1	0
That o	Form
	Foreman