 
CITY OF NEW BEDFORD

APPLICATION FOR LAYING DRAIN

Application 19141	Board of Health Permit No.
	New Bedford, Mass., May 18 1970
	re premises of Theo Mach & Cenest Theoriesal
82 Belair St. 330'e	of Wildwood Rd.
342	e e e e e e e e e e e e e e e e e e e
to connect with the sewer in	relair St. street,
the same to be laid in the street and the surface Works.	e repaired as directed by the Commissioner of Public
I hereby agree to pay at the office of the Cit the manner specified, in excess of the deposit m the work.	ty Treasurer all cost of performing the above work in ade herewith, within 10 days after the completion of
payment of the cost of performing the work do be returned to me by the City Treasurer.	it made with this application shall be applied to the ne, and that any excess of deposit over the cost shall
Witness & Bryant	Theodore Mack Court Seirouvel
	Theodore Mack Emit Hirowood Property owner 1- Ona- Vill Ad Mallapared
	Address
Ву	same
Paradian annual antonia	
Requires separate entrance for roof water	Address
Consent of Owr	ner of Private Drain
	New Bedford, Mass.,
To the Mayor and City Council:	New Bedford, Mass.,
I hereby grant to	
the privilege of draining premises	
through the private drain owned by me connecti	ing with sewer in
	street.
	Owner
Estimate and D	Deposit Requirement
Office of Comm	nissioner of Public Works,
My estimate of the cost of laying the drain of	described in the above application is
8,59,00	
Assessed	
Entrance charges	Total deposit required 159.00
	A C Anderson for Commissioner of Public Works
Cartifica	ate of Issue
Comme	
The above application accompanied by Cit	Office of City Clerk,
	and the Commissioner of Public Works notified of the
same.	Eller M. Gauglan City Clerk
Laid from main in street to iron pipe in property.	City Clerk
Owner agrees to supply all necessary	
Cansil.	



NOTICE TO COMMISSIONER OF PU	BLIC WORKS
Length of drain 32' Billed 7/23/7	. 69
Sewer depth8	pipe system
Surf. drain	
Drain Permit Nº 19141 City of New Bedford,	
Office of City	Clerk, May 18, 1970
To Commissioner of Public Works.	
Permission has this day been issued to	1
Theo Mach & Ernest Gerouard	1051 Joyce Street
Property owner	Address
By Same	same
	Address
to lay drain from the premises of Theo Mach & Co	nest Terouard
20 Belair It 330 w of Wilder	
to connect with the sewer in Belair S	treet street.
Laid from main in street to iron pipe in property. Owner agrees to supply all necessary	m Saushan
Transite	Ge BCity Clerk.

Requires separate entrance for sewage and roof water

Iransile pipe.

RETURN OF FOREMAN

Entered	JUNE-3 BD	1970
Time	, ,	Α
Ву	COST G.TA	WARES)
Labor	hours @	
Tavares, J. Alfonso, Jos. St. Pierre. N.	- 8 " 3.00 - 8 " 2.90 - 8 " 2.70	\$24.00 23.20
Jardin. Jos.	= 8 " 2.70 = 8 " 2.75 = 8 " 3.00	21.60 22.00 24.00
Burke, Thos. Braga, R.	- 8 " 3.15	25.20
Stock / BACK	CEMENT @ 165	83
REPLACE - 125-TXD	NOTTOIL-ROND	15 68
Trucking 1 HOW 21-COMPR 1 HOW G7-TRUCK WASH G5-BACKH		335
Estimate-cost of Entrance charg Total deposit		202,40
Balance due (City .	4340
" " cur	b to house 2-10 FT-1-4	
Cut at sewer Cut at curb Size of pipe		Ž.
Correct	John a.	Lun
	1 6	Foreman