NOTICE TO COMMISSIONER OF PUBLIC WORKS
Length of drain 38 Queles cos 29/20 0
Sewer depth pipe system
Surf. drain
Drain Permit Nº 19165 City of New Bedford,
To Commissioner of Public Works
To Commissioner of Public Works.
Permission has this day been issued to
Property owner 2 Darkela Hell Address
By Jame Kay Collarce same
to lay drain from the premises of Realty
no Chaffer It 230: of Agaley Block
to connect with the sewer in Chaffel St. street.
Owner agrees to supply all necessary City Clerk.
pipe.
Requires separate entrance for sewage and roof water

RETURN OF FOREMAN

 
	SEPT: 15 THE	19 70
me	100	
y	John W Jow	
	COSTCT-THUMA	es)
Labor	hours @	
avares y.	18 " 33	9 27 12
Alfondo, g	- 8 " 31.	2 24 96
arding	- 6/ " 31	2 2496
It Pierce	- 8 " 28	6 2288
gurler,	0 8 " 33	7 2696
macedo	17-8 " 35	8 2864
6. 1./	"	17777
Stock //2BAC.	- CEMENT	62
OLBS-SAND		10
MEE-12FTX3	FT-B-C-ON-ROAD	3/64
	6200+2	0/01
Trucking		
#21-COMPRE		335
#21-compre G7-truck G7-brekite		3930
2/-compre 67-truck 35-bnckife Total Cost	0 6.JJ	3930
2/-Compre 67-TRUCK 35-BACKIFO Total Cost Estimate-cost	of laying drain 190	3930
2/-Compre 67-TRUCK 35-BACKIFO Total Cost Estimate-cost	of laying drain 196 rges ASSESED	3930
2/-Compre 67-TRUCK 35-BNCKIFE Total Cost Estimate-cost Entrance cha	of laying drain 196 rges ASSESED	335 300 3930 2358
2/-COMPRE 67-TRUCK 35-BNCKIFE Total Cost Estimate-cost Entrance cha Total deposit Balance due Pieces pipe to	of laying drain 90 1	335 300 3930 2358 4382 -6-IN 267-6-IN
2/-Compre 67-TRUCK 35-BNCKIFE Total Cost Estimate-cost Entrance cha Total deposit Balance due Pieces pipe to " " cu Cut at sewer	of laying drain 90 rges 155/55(1) 190	335 300 3930 2338 4382 -4-IN 167-4-IN 267-6-IN
2/-Compre 67-TRUCK 35-BNCKIFE Total Cost Estimate-cost Entrance cha Total deposit Balance due Pieces pipe to " " cu Cut at sewer	of laying drain 90 1	335 300 3930 2358 4382 -4-1N -6-1N 267-6-1N
7/-Compres 67-TRUCK 35-BNCKIFE Total Cost Estimate-cost Entrance cha Total deposit Balance due Pieces pipe to "" cu Cut at sewer Cut at curb	of laying drain 90 rges 155/55(1) 190	
2/-compre 67-TRUCK 35-BNCKIFE Total Cost Estimate-cost Entrance cha Total deposit Balance due Pieces pipe to "" cu Cut at sewer Cut at curb	of laying drain 90 1	
2/-compression of the contract	of laying drain 90 1	

CWNER- SUPPRIFO-PIPE

CITY OF NEW BEDFORD

APPLICATION FOR LAYING DRAIN

	Application Nº 19165	Board of Health Permit No	(215%
		New Bedford, Mass., Pug 7, 19	70
	To the Mayor and City Council: I hereby request that a drain be la	New Bedford, Mass., Aug 7, 19	c p
1025	no Chaffin S	t 220 e of Ashlug Blue	2
		PP 10	
	to connect with the sewer inthe same to be laid in the street and tworks.	the surface repaired as directed by the Commissioner	of Public
	I hereby agree to pay at the office the manner specified, in excess of the the work.	of the City Treasurer all cost of performing the above deposit made herewith, within 10 days after the com-	work in pletion of
	It is understood and agreed that payment of the cost of performing the be returned to me by the City Treasur	the deposit made with this application shall be application work done, and that any excess of deposit over the	ed to the cost shall
	Witness & Bryant.	A I II OF THE TOTAL OF THE PARTY OF THE PART	<i>e</i>
		32 Carpila Hilfight 1/5	2
		By	
	Requires separate entrance for roof water	Address	
	Consent	of Owner of Private Drain	
	To the Mayor and City Council:	New Bedford, Mass.,	
	, 0		
		e connecting with sewer in	
			street.
		C	Owner
	Estimate	e and Deposit Requirement	
	Office	e of Commissioner of Public Works,	******
	My estimate of the cost of laying t	he drain described in the above application is	
	And the set of Control and Control and Control and Control and Control and Control and Control		
	Entrance charges	Total deposit required 1900	
		Commissioner of Public V	Y & Works
		Certificate of Issue	
		Office of City Clerk,	
	The above application, accompanie	ed by City Treasurer's receipt presented this day; v	vhereupon
	Permit No. 19/65 w	as issued, and the Commissioner of Public Works notif	ied of the
	same.		
		Ellen va Zan	Clerk
5	Laid from main in street to iron pipe in proper Owner agrees to supply all necessary		CICIK



MATERIAL DISBURSED

Sept. 15 19 70

Drain permit Roll No.19165

FORM 72 BAKER

DELIVERED TO N.S. Chaffee St., -220' E. of Ashley Blvd.

Spready

Material	Amount	Unit Price	Total	
Install new drain				
Bags of Regular Cement Cwt. Brick Sand	rilo Q	1 65 09	83	
Charge: D.J. Realty Corp. 22 Tarkiln Hill Road				

					C.	
	100					
					TO MAKE	
					ED-L	
					The state of	
					100	
10					Section 1	
					110	
					100	
				the state of the s		
20 g						
				3		
				3 - 17 0		
				3		
* · · · · · · · · · · · · · · · · · · ·						
				1537		
				100/1		
			. 18 1 - 18 1 - 18			
				1924-		
				1000		
				100012 (. + 100		
				10 - 10 - 10 - 10 - 10 - 10 - 10 - 10 -		
				1		
	note:					
	Dord to the				ā	
				1934		
	David This is			10 - 10 - 10 - 10 - 10 - 10 - 10 - 10 -		
				1001		
	La Control					
				1		
				10001		