5/2/8	NOTICE TO COMMISS			ئ
Length of drain	40	eled 15/29/7"	(20)	4
Sewer depth				e system
Surf. drain	(4)			
Drain Permit No	le to lover oun	New Bedford, Office of City Clerk	, Aug 19.1	910
To Commissioner of I	Public Works.			
Permission has the	is day been issued to	100 11	1. 24 1.	+ 1101
Berly of Illu	Berty owner	133 Wil	Address	tyball
By Cety Pl	anner	<u>.</u>	Lame	U
EJ.	D+	1-20 /	Address	
to lay drain from the	. / _ / . /	9 / CALL X	lafora	
e & Son	my St 2300.	ng Joure	the St	
to connect with the se	ewer in X30	nney		street.
Laid from-main in street t		Eller 7	x Saugha	LAB.
A Liansite	pipe,		City	Clerk.
	ance for sewage and roof	water		
supe	rmet 19169			

 
RETURN OF FOREMAN

•	Entered SEPT= / EL	1970	
	Time	0	
	By Shull To	luc-	
	COST		
	/ 6001		
	Labor Low, g // hours @ 339	3729	
	Ferreira 13 " 286	37 18	
	Orlowski- 13 " 3/2	4056	
	Travers, - 11 " 301	33 11	
	St. Merre, N. 13 " 312	40 56	-
9	Burke, T- 13 " 337	43 81	
	Macedo, 9 - 13 " 358	4656	1
	Reedy 9 - 8 " 312	24 96	
	Stock /2 BAG-CEMENT @ (6)	83	
-	GOLBSSAND @ 099	18	
RE	PLACE-12FTX3FT-13-C-ON-ROAD	3 / 1/	
	0222471	3164	2
			2
, .	The Holes	141	
1.	Trucking 2/-compressor	335	
/	125-TRUCK (3his. 630)	1007	00
2	GT-TRUCK)	Un de	
7	ST#35 BACKHOE @ 657	20179	-,
	Total Cost	3948	r
	Estimate-cost of laying drain		
-	Entrance charges		
3 -	Total deposit		
3	Balance due		
4	Pieces pipe to curb /-/oFT-1-2F	1-6-IN	
30	" curb to house the FT-1-5-F	T-6-101	
7	Cut at sewer 5/2 FT		
3	Cut at curb 5 FT	N.	
8	Size of pipe 6 IN-TRANSITE - PIPE	5	
3		. 1	
35	Correct	7//	
3	Solder le	· Hour	
5	/	Foreman *	7

CITY OF NEW BEDFORD

APPLICATION FOR LAYING DRAIN

Application Nº 19170	Board of Health Permit No.
	New Bedford, Mass., Hug 19, 19, 70
To the Mayor and City Council: I hereby request that a drain be laid from th	e premises of Caty of New Bedford
e a Bonney St 230	
320	
/2	
to connect with the sewer in the same to be laid in the street and the surface Works.	e repaired as directed by the Commissioner of Public
I hereby agree to pay at the office of the Cit the manner specified, in excess of the deposit m the work.	y Treasurer all cost of performing the above work in ade herewith, within 10 days after the completion of
It is understood and agreed that the deposit payment of the cost of performing the work don be returned to me by the City Treasurer.	it made with this application shall be applied to the ne, and that any excess of deposit over the cost shall
Witness L Buyant C	ITY OF NEW BEDFORD
	Property owner
	Day Ac Boddiess A Sixta A Cit
By .(The state of the s
Requires separate entrance for roof water	Address
Consent of Own	ner of Private Drain
	New Bedford, Mass.,
To the Mayor and City Council:	
I hereby grant to the privilege of draining premises	
the privilege of training premises	
through the private drain owned by me connecti	ng with sewer in
	street.
	Owner
Estimate and D	eposit Requirement
	nissioner of Public Works,
My estimate of the cost of laying the drain of	described in the above application is
Assessed	Total deposit required \$140.00
Entrance charges	Total deposit required
	Commissioner of Public Works
Certifico	ate of Issue
	Office of City Clerk,
The above application, accompanied by Cit	y Treasurer's receipt presented this day; whereupon
	and the Commissioner of Public Works notified of the
same.	O Tubic Trong notified of the
an III	Ellen M. Daughan B. City Clerk
Laid from main in street to iron pipe in property.	City Clerk 15
Owner agrees to supply all necessary	



MATERIAL DISBURSED

Sept. 1 19 70 Roll No. #19170

DELIVERED TO ES Bonney St., -- 230' N. of Jouvette St.

Material	Amount	Unit Price	Total	
Install new drain				
Bags of Regular Cement	12	1 65	83	
Cwt. Brick Sand	2	09	18	

