

NOTICE TO COMMISSIONER OF PUBLIC WORKS

41 ✓

Billed 10/29/20 *BB*

Length of drain.....30'

Sewer depth.....8'

Surf. drain.....6'

.....2 pipe system

Drain Permit **N^o 19181**

City of New Bedford,

Office of City Clerk, September 4, 1970

To Commissioner of Public Works.

Permission has this day been issued to

Adolph Thosz
.....
Property owner

628 Summer St.
.....
Address

By *same*.....

same
.....
Address

to lay drain from the premises of *Adolph Thosz*.....

n.s Coggeshall St. 320' w of Highland St.
.....

to connect with the sewer in *Coggeshall St.*.....street.

Laid from main in street to iron pipe in property.

Owner agrees to supply all necessary
Transite.....pipe.

Ellis M. Gaugher, Jr.
.....
City Clerk.

Requires separate entrance for sewage and roof water

(D)

RETURN OF FOREMAN

Entered ~~Sept 27~~ OCT. 8 1970

Time 2:30 P.M.

By ~~John L. Jones~~ *John L. Jones*
COST (J. ~~Jones~~)

Labor	hours @		
Jesse Tavares 8 Hr. "	339	27	12
Joseph Jardim 8 Hr. Skill 3/2		24	96
NORBERT ST. PIERRE 8 " "	312	24	96
Joseph Almeida 7 " Skill 3/2		21	84
Joseph Macedo 7 " "	358	25	06
Rodman Braga 1 " "	358	3	58
Thomas Burk 8 " "	339	26	96
Stock 1/2 BAG-CEMENT @ 165		83	
100 LBS-SAND 222 1/2		19	
REPLACE 12 FT 3 FT. B-C-ON-ROAD		31	64
" 4 X 4 Grano. Square		9	60
179 sq ft @ 540			
Trucking			
1 1/2 hr 21-COMPRESSOR		3	35
1 1/2 hr 67-TRUCK		3	00
4 1/2 hr 65-1 HR.		6	55
Total Cost	35.7 HR @ 65	45	85
Estimate-cost of laying drain	180	-	
Entrance charges	ASSESSED	-	
Total deposit	180	-	
Balance due		75	39

Pieces pipe to curb 1-10 FT-1-2 FT- ~~6~~

" " curb to house ~~1-10 FT-6~~ (2) 1-10 ft.

Cut at sewer ~~8 1/2~~ ft. 1-8 ft.

Cut at curb 7 1/2 FT

Size of pipe 4" + 6" Transito

Correct

John L. Jones

John L. Jones
Foreman

OWNER-SUPPLIED-PIPE

19293

CITY OF NEW BEDFORD
APPLICATION FOR LAYING DRAIN

Application **Nº 19181** permit # 19293
07/15/71 Board of Health Permit No.
New Bedford, Mass., Sept 4, 1970

To the Mayor and City Council:

I hereby request that a drain be laid from the premises of Adolph Thazy
on Coggeshall St 320' ew of Highland St.

to connect with the sewer in Coggeshall street,
the same to be laid in the street and the surface repaired as directed by the Commissioner of Public Works.

I hereby agree to pay at the office of the City Treasurer all cost of performing the above work in the manner specified, in excess of the deposit made herewith, within 10 days after the completion of the work.

It is understood and agreed that the deposit made with this application shall be applied to the payment of the cost of performing the work done, and that any excess of deposit over the cost shall be returned to me by the City Treasurer.

Witness H. Comanick Adolph Thazy
Property owner

By 628 Sumner St
Address

Requires separate entrance
for roof water

Address

Consent of Owner of Private Drain

To the Mayor and City Council:
New Bedford, Mass.,

I hereby grant to
the privilege of draining premises

through the private drain owned by me, connecting with sewer in
street.

Owner

Estimate and Deposit Requirement

Office of Commissioner of Public Works,

My estimate of the cost of laying the drain described in the above application is

\$ 180.00

Assessed

Entrance charges Total deposit required \$180.00

A.C. Anderson
Commissioner of Public Works

Certificate of Issue


Office of City Clerk,

The above application, accompanied by City Treasurer's receipt presented this day; whereupon
Permit No. 19181 was issued, and the Commissioner of Public Works notified of the same.

Ellen M. Saughan
City Clerk

Laid from main in street to iron pipe in property.
Owner agrees to supply all necessary

Transit pipe.

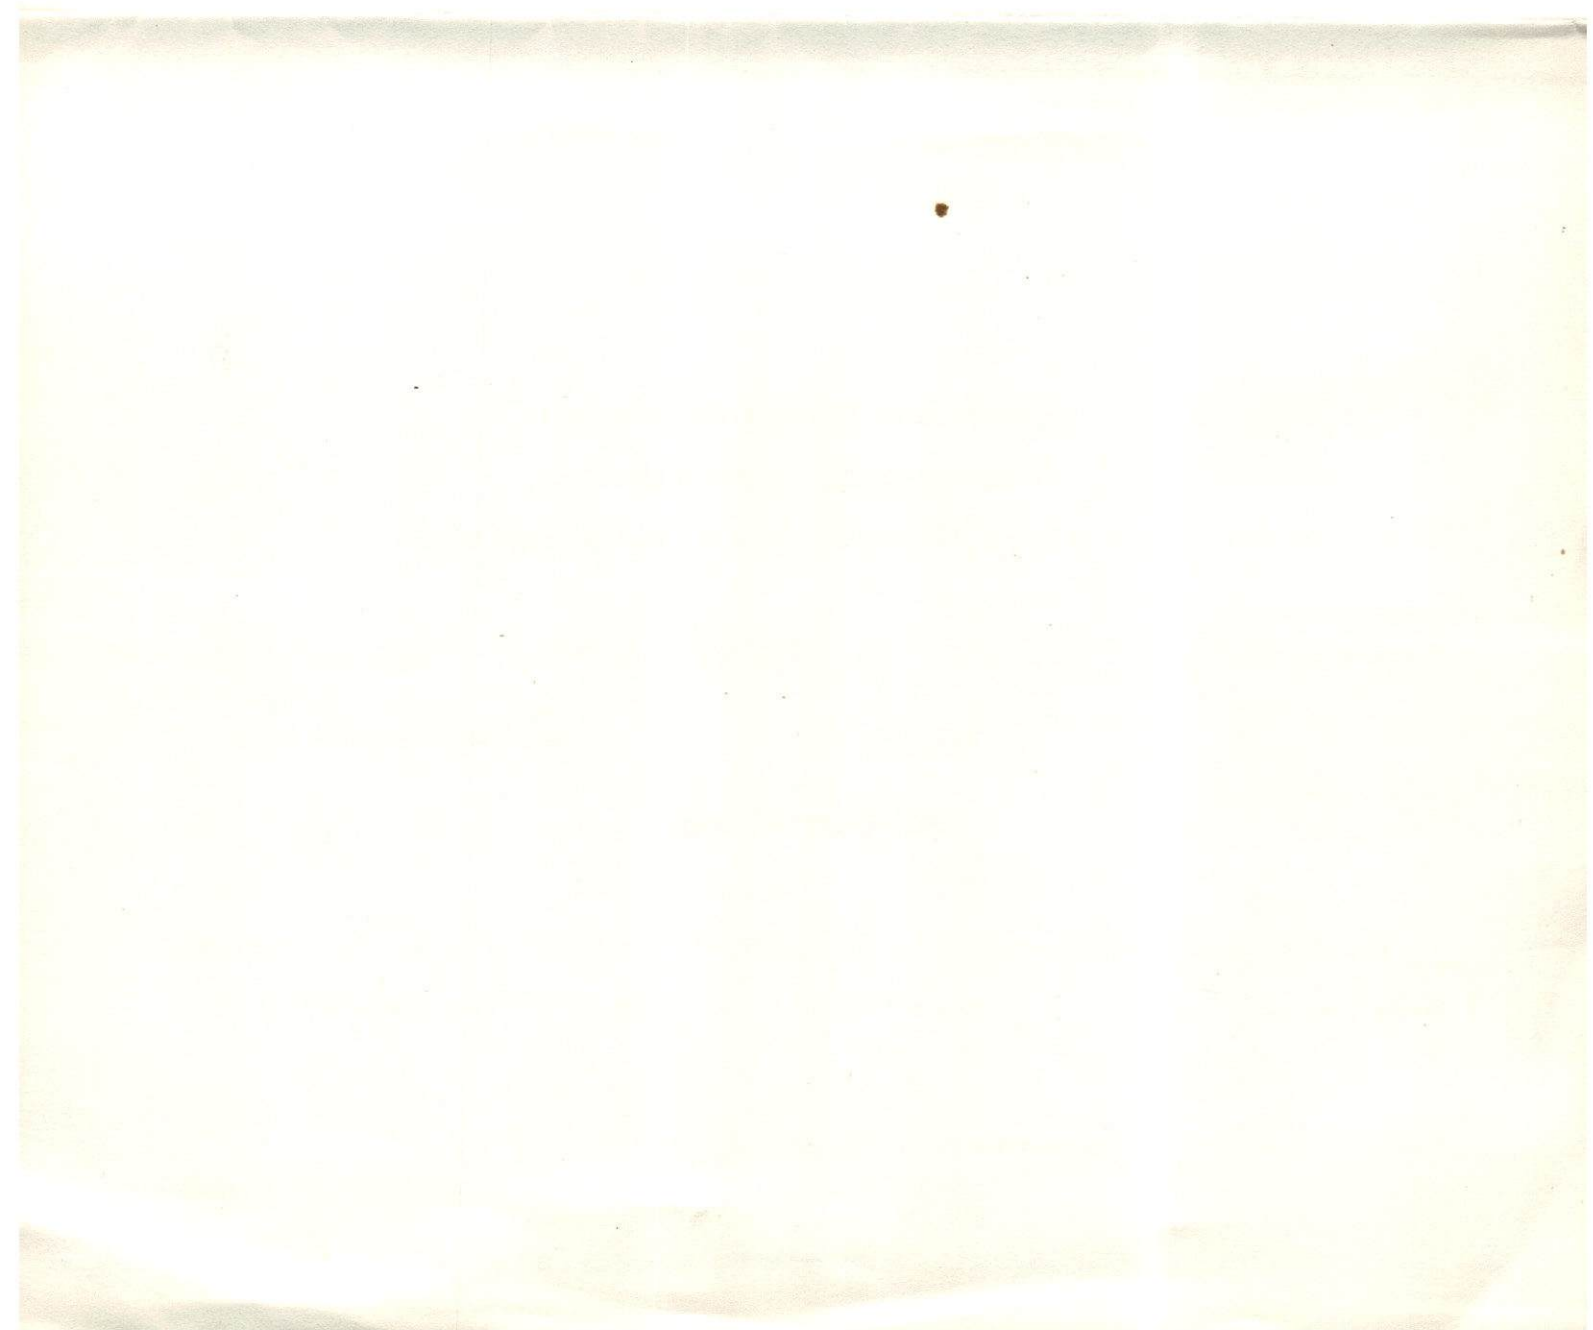

MATERIAL DISBURSED

October 8 1970

Drain permit
Roll No. WO#-19181

A. Thooz

DELIVERED TO N.S. Coggeshall St.--320' W. of Highland St.

	Material	Amount	Unit Price		Total	
	Install New Drain					
	Bags of Regular Cement	$\frac{1}{2}$	1	65	83	✓
	Cwt. Brick Sand	1		09	09	—

11-11-11

11-11-11

