	ER OF PUBLIC WORKS
Length of drain	ed 10/29/10 82
Sewer depth	pipe system
Surf. drain	
Drain Permit Nº 19184 City of New	Bedford,
Of	ffice of City Clerk, September 14, 1970
To Commissioner of Public Works. Permission has this day been issued to	
	16 Vernon St.
Sonald Lawmonters	Address
By Sanl	same
	Address
to lay drain from the premises of	
ws. Lowell St. 60'n	of Scockton St.
to connect with the sewer in Louis	£ street.
Laid from main in street to iron pipe in property. Owner agrees to supply all necessary	Ellen m Laughan City Clerk.
Liansell pipe.	8 + land or it morne
Requires separate entrance for sewage and roof water	Est. based on st. parry existing 7/28/10.

 
RETURN OF FOREMAN

Entered Oct. 6 1970	19 70
Time 3,30 P, M. By Jesse M. Jours	ns.
COST	
Labor hours @	2017
200000	21/01
Joseph Jardin 8" 3/2	1496
Norbort St. Prorros" 786	2288
Joseph Macedo 8" 358	2864
Thomas Burk 8" 337	26 96
"	いない
Stock	
13 bag Coment @ 165	83
10016s Sand	09
CP 13 X3 BlackTop Road	3380
	220
Trucking	
#35 - 6-HR. C655	39 30
67. 1-HRI@300	300
21 1- HR. @335	335
Total Cost	235.9
Estimate-cost of laying drain	
Entrance charges	
Total deposit Balance due	499
th	216
Pieces pipe to curb	
" " curb to house (2) 1-10 ft.	-1-10P
Cut at sewer 9 3 ft.	
Cut at curb8	
Size of pipe 4" + 6" Tra	msite
Correct	
Jose In Jorns	

CITY OF NEW BEDFORD

APPLICATION FOR LAYING DRAIN

Application Nº	1918 4	Board of Health Permit No.
		New Bedford, Mass., September 14 1970
To the Mayor and Ci I hereby request	ty Council: that a drain be laid from th	e premises of Osnald Kairmoniere
		of Brockton St
to connect with the set the same to be laid Works.	ewer in	street, repaired as directed by the Commissioner of Public
I hereby agree to the manner specified, the work.	pay at the office of the Cit in excess of the deposit ma	y Treasurer all cost of performing the above work in ade herewith, within 10 days after the completion of
payment of the cost be returned to me by	of performing the work dor the City Treasurer.	t made with this application shall be applied to the ne, and that any excess of deposit over the cost shall
Witness Z. Z.	part	Property owner
0		
	By	Jacobu Lavemeneri
Requires separate enter	rance 16	UERNON ST Now Rooford
	Consent of Own	er of Private Drain
To the Mayor and Cit	ty Council:	New Bedford, Mass.,
I hereby grant to)	
the privilege of drain	ing premises	
through the private of	Irain owned by me connecting	ng with sewer in
		street.
		Owner
	Estimate and D	eposit Requirement
		issioner of Public Works,
My estimate of the	ne cost of laying the drain d	escribed in the above application is
_		Total deposit required 4/86.00
Entrance enarges		AC. Anderson RB
		Commissioner of Public Works
	ContiGoo	to of lowe
	Certifica	te of Issue
		Office of City Clerk,
F-0-F-0		Treasurer's receipt presented this day; whereupon
	was issued, a	and the Commissioner of Public Works notified of the
same.		Eller M. Maughan p. B. City Clerk
Laid from main in street		City Clerk
Owner agrees to su	pply all necessary	



MATERIAL DISBURSED

october 6 19 70

Drain permit
Roll No. WO#-19184

DELIVERED TO W.S. Lowell St., 60' N. of Brockton St.

Material	Amount	Unit Price	Total
Install New Drain Bags of Regular Cement Cwt. Brick Sand	1 2	l 65 09	83

