NOTICE TO	COMMISSIONER OF PU	BLIC WORKS	great 46
Length of drain	Belled (78)	20 00	10
Sewer depth	A A		e system
Surf. drain 41/2			
Drain Permit Nº 19192	City of New Bedford,	P + 22 2	
	Office of City	Clerk, Sept 30 19'	70
To Commissioner of Public Works.  Permission has this day been issued.	ued to	21 1 1 01	
Property owner	280 QL	dulestport Kd.	Mr. Carl
By Meren I Sylva	san	ne :	
	I want PP	Address	
to lay drain from the premises of	AlfMande Shifted		
Wa Hathaway Dlvo	130 s of he	Refella She	
to connect with the sewer in	Hathaway Blir	d.	street.
Laid from main in street to iron pipe in pro	operty.	m 11 10	00
Owner agrees to supply all necessary		n // Janghan	agi B.
JAMASALL.	pipe.	City	Clerk.
Requires separate entrance for seway	ge and roof water	no storm dra	in connection

 
## RETURN OF FOREMAN

F	Entered NOV. 10 Time 10. A.M.  By Case M Nov.	19		
02 02	Jabor hours @  Joseph Al Conso 3" 339  Joseph Jard, 3" 312  Norbert SI. Pierro 3 286  John Ambra 3" 337  Joseph Macdo 3" 358  Stock  Stock  Jobag Comont  100/65 Sand	99 99 8 10 10 58	17 36 36 58 11 74 32 83	- //
S o mer skep!	Trucking 3 2 - HR. 2653 67 /- HR.  Total Cost Estimate-cost of laying drain 50 - Entrance charges Total deposit 50 - Balance due Pieces pipe to curb	75	34	7
	Cut at sewer 7 3 Cut at curb 7 2 1 None Size of pipe 6 1 2 n S. 1.  Correct			

## CITY OF NEW BEDFORD

## APPLICATION FOR LAYING DRAIN

Application N. 19192	Board of Health Permit No.
	New Bedford, Mass., Sept. 30, 1970
To the Mayor and City Council:	om the premises of Raymond Lylina
	A 130 's of Ourfee It
. /	01
to connect with the sewer in the same to be laid in the street and the su Works.	street, urface repaired as directed by the Commissioner of Public
I hereby agree to pay at the office of the the manner specified, in excess of the deposithe work.	e City Treasurer all cost of performing the above work in sit made herewith, within 10 days after the completion of
It is understood and agreed that the d payment of the cost of performing the work be returned to me by the City Treasurer.	leposit made with this application shall be applied to the k done, and that any excess of deposit over the cost shall
Witness L Brigant	Caymond L. Sylin
	Property owner
	280 Old Wistomord, no. Da
By	Thurs & Sylvin
Requires separate entrance	290 Old Westport AS, 410 Da
for roof water	Address
Consent of (	Owner of Private Drain
To the Mayor and City Council:	New Bedford, Mass.,
I hereby grant to	
the privilege of draining premises	
through the private drain owned by me con	necting with sewer in
22.7	street.
	Owner
Estimate an	d Deposit Requirement
Office of C	Commissioner of Public Works,
	,
My estimate of the cost of laying the dra	ain described in the above application is
Assessed Entrance charges	Total deposit required 850.00
Entrance charges	Total deposit required.
	Commissioner of Public Works
Cort	rificate of Issue
Cerr	
	Office of City Clerk,
	City Treasurer's receipt presented this day; whereupon
Permit No. 19192 was issuesame.	ued, and the Commissioner of Public Works notified of the
	Eller M. Janha
Laid from main in street to iron pipe in property.  Owner agrees to supply all necessary	City Clerk
Lauret pipe.	



## MATERIAL DISBURSED

November 10 19 70

WS Hathaway Blvd .-- 130' S. of Durfee St. DELIVERED TO

Material	Amount	Unit Price	Total
Install New Drain			
Bags of Regular Cement	100	1 65	83 V
Cwt. Brick Sand	1	09	09

