
## CITY OF NEW BEDFORD

## APPLICATION FOR LAYING DRAIN

Application N. 19232	Board of Health Permit No.				
	New Bedford, Mass. Lebruary 26, 1971				
To the Mayor and City Council:  I hereby request that a drain be laid from the	premises of A. Fournier & Callec Realty				
on Acustnot Are un'	not Ellot St.				
	a september of the sept				
(2198)					
Works.	repaired as directed by the Commissioner of Public				
I hereby agree to pay at the office of the City the manner specified, in excess of the deposit ma the work.	Treasurer all cost of performing the above work in de herewith, within 10 days after the completion of				
It is understood and agreed that the deposit payment of the cost of performing the work done be returned to me by the City Treasurer.	made with this application shall be applied to the e, and that any excess of deposit over the cost shall				
Witness & Bryant	a 4 Fourner				
	Property owner				
	Address				
Ву	10 111 1				
Bauring assessed automas					
Requires separate entrance for roof water	Address				
•					
Consent of Owner	er of Private Drain				
	New Bedford, Mass.,				
To the Mayor and City Council:	New Bedford, Mass.,				
I hereby grant to					
the privilege of draining premises					
through the private drain owned by me connectin	g with sewer in				
	street.				
	Owner				
Estimate and Do	anasit Paguirament				
	eposit Requirement				
Office of Commi	issioner of Public Works,				
My estimate of the cost of laying the drain de	escribed in the above application is				
370700	Al .				
Assessed Entrance charges	Total deposit required 307.00				
	AC Andrew Do				
	Commissioner of Public Works				
Certificate of Issue					
	Office of City Clerk,				
The above application, accompanied by City	Treasurer's receipt presented this day; whereupon				
Permit No. 19232 was issued, a	and the Commissioner of Public Works notified of the				
same.					
	Ellen M Daughan				
Laid from main in street to iron pipe in property.  Owner agrees to supply all necessary	City Clerk				
Transite pipe.					

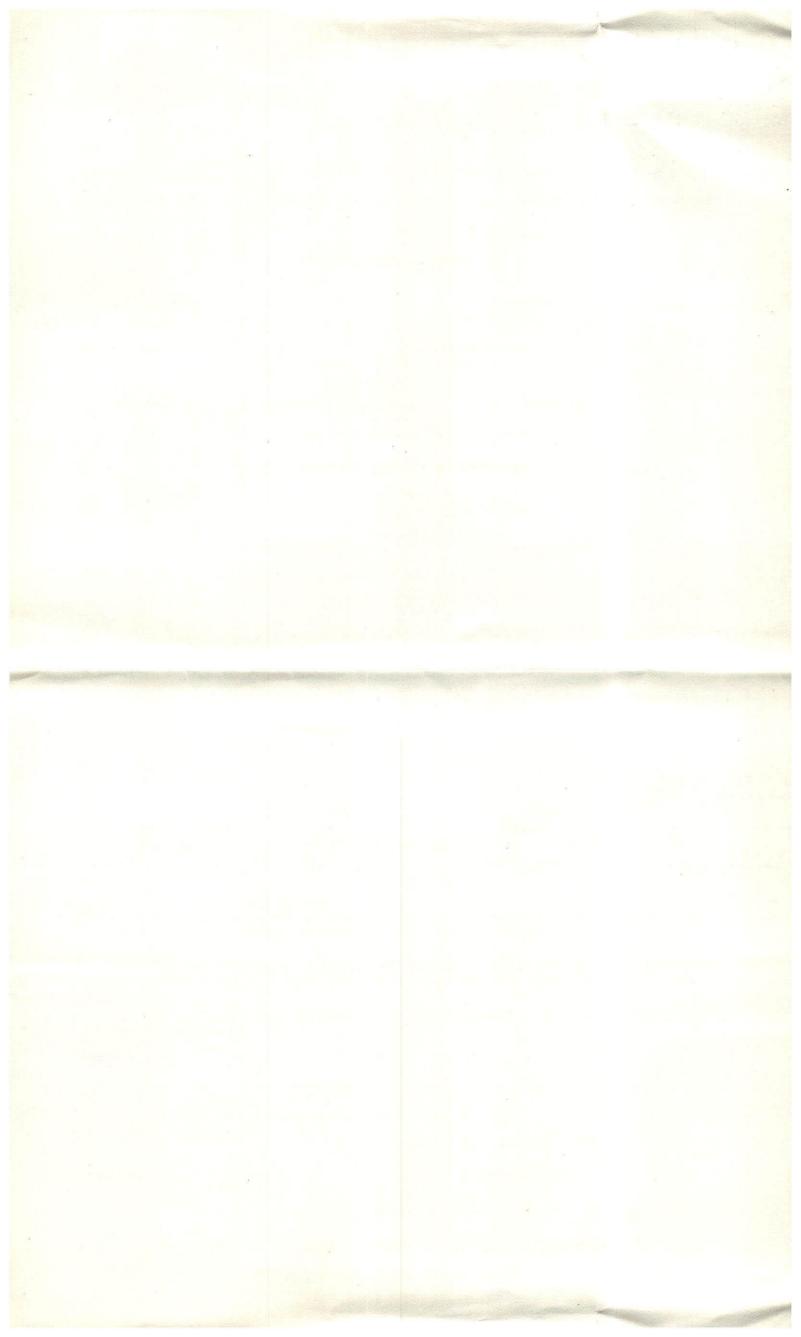

	NOTICE TO COMMISSIONER OF PUBLIC WORKS
	Length of drain 38 billed 6/3/71 @
1	Sewer depth 2 pipe system
	Surf. drain
	NO 10222
	City of New Bettlord,
	Office of City Clerk, Lebourary 26, 1971
	To Commissioner of Public Works.
	Permission has this day been issued to
	A tourner to Calber Kenty Inc. 1934 Acrishnet Hoe.
	Property owner Address
	By Horman Gendion same
	to lay drain from the premises of A. J. Fournier To Calber Realty Inc
	es Acushnit Ave 41'n of Ellist St.
	to connect with the sewer in Acushnet Avenue street.
,	Laid from main in street to iron pipe in property.  Owner agrees to supply all necessary  Light M. Laugh M. City Clerk.
V	Requires separate entrance for sewage and roof water
	requires separate chiralize for sewage und roof water

## RETURN OF FOREMAN

RETU	RN OF FOREMAI	1	
Entered 4	115	19	7/
	9 M.		
	el sm Jo		65
	COST	and the same	
		11	
Labor	hours @		W9 1
" Jesse Tay		30	51 /
) - 1 00	pago 4 "3.12	12	
Joseph Ja	NOM 9 ).TE	28	08
	Pierrey"	27	
	13 urk 7 3.31	30	-
Rod Bra	93 9"3.58	32	30 V
Step Progr	3m 4 2.00	144	96
	Chamant	111	00
12 009	Comont		11
100/65	Sand		11
eplace 25 x 3 bla	8 2 CI - 10 1 2 CI	71	51
	5 785	71	16
Trucking		1	
#65-3-	- HRS- (2,63)	19	65
100-0	116	17	00
6/-/	- 110	3	35
Total Cont	- AKI CATE	202	25
Total Cost	Classica desire 1207 a	hwh	71
	f laying drain 307 -	273	d'd
Entrance charg	(es/3/2/2/2/)	-	
Total deposit  Balance due	maryan	33	70
		1	10
Pieces pipe to o	curb 3 1-10-17-17	OH	1-57
	b to house 1 /- /of		
Cut at sewer.			*
Cut at curb			
Size of pipe	9	15.	tu
	to and the state of the state o		
Correct			
de	e m Joins	0	
And	7	Foren	nan