

CITY OF NEW BEDFORD  
APPLICATION FOR LAYING DRAIN

Application **Nº 19244**

Board of Health Permit No. ....

New Bedford, Mass., March 24, 1971

To the Mayor and City Council:

I hereby request that a drain be laid from the premises of James Bento  
Raymond St w.s. 50's of York St

to connect with the sewer in Raymond street,  
the same to be laid in the street and the surface repaired as directed by the Commissioner of Public Works.

I hereby agree to pay at the office of the City Treasurer all cost of performing the above work in the manner specified, in excess of the deposit made herewith, within 10 days after the completion of the work.

It is understood and agreed that the deposit made with this application shall be applied to the payment of the cost of performing the work done, and that any excess of deposit over the cost shall be returned to me by the City Treasurer.

Witness L Bryant James Bento Property owner  
118 Nash Rd. New Bedford Mass Address  
By John De Terra  
146 Milford St New Bedford Address

Requires separate entrance  
for roof water

Consent of Owner of Private Drain

New Bedford, Mass., .....

To the Mayor and City Council:

I hereby grant to .....  
the privilege of draining premises .....  
through the private drain owned by me connecting with sewer in .....  
..... street.

Owner

Estimate and Deposit Requirement

Office of Commissioner of Public Works, .....

My estimate of the cost of laying the drain described in the above application is

\$268.00

~~Assessed~~

~~Entrance charges~~

Total deposit required \$268.00

AC Anderson  
Commissioner of Public Works

Certificate of Issue

Office of City Clerk, .....

The above application, accompanied by City Treasurer's receipt presented this day; whereupon  
Permit No. 19244 was issued, and the Commissioner of Public Works notified of the same.


Ellen M. Taylor  
City Clerk

~~Laid from main in street to iron pipe in property.~~

~~Owner agrees to supply all necessary~~

Saniti

pipe.

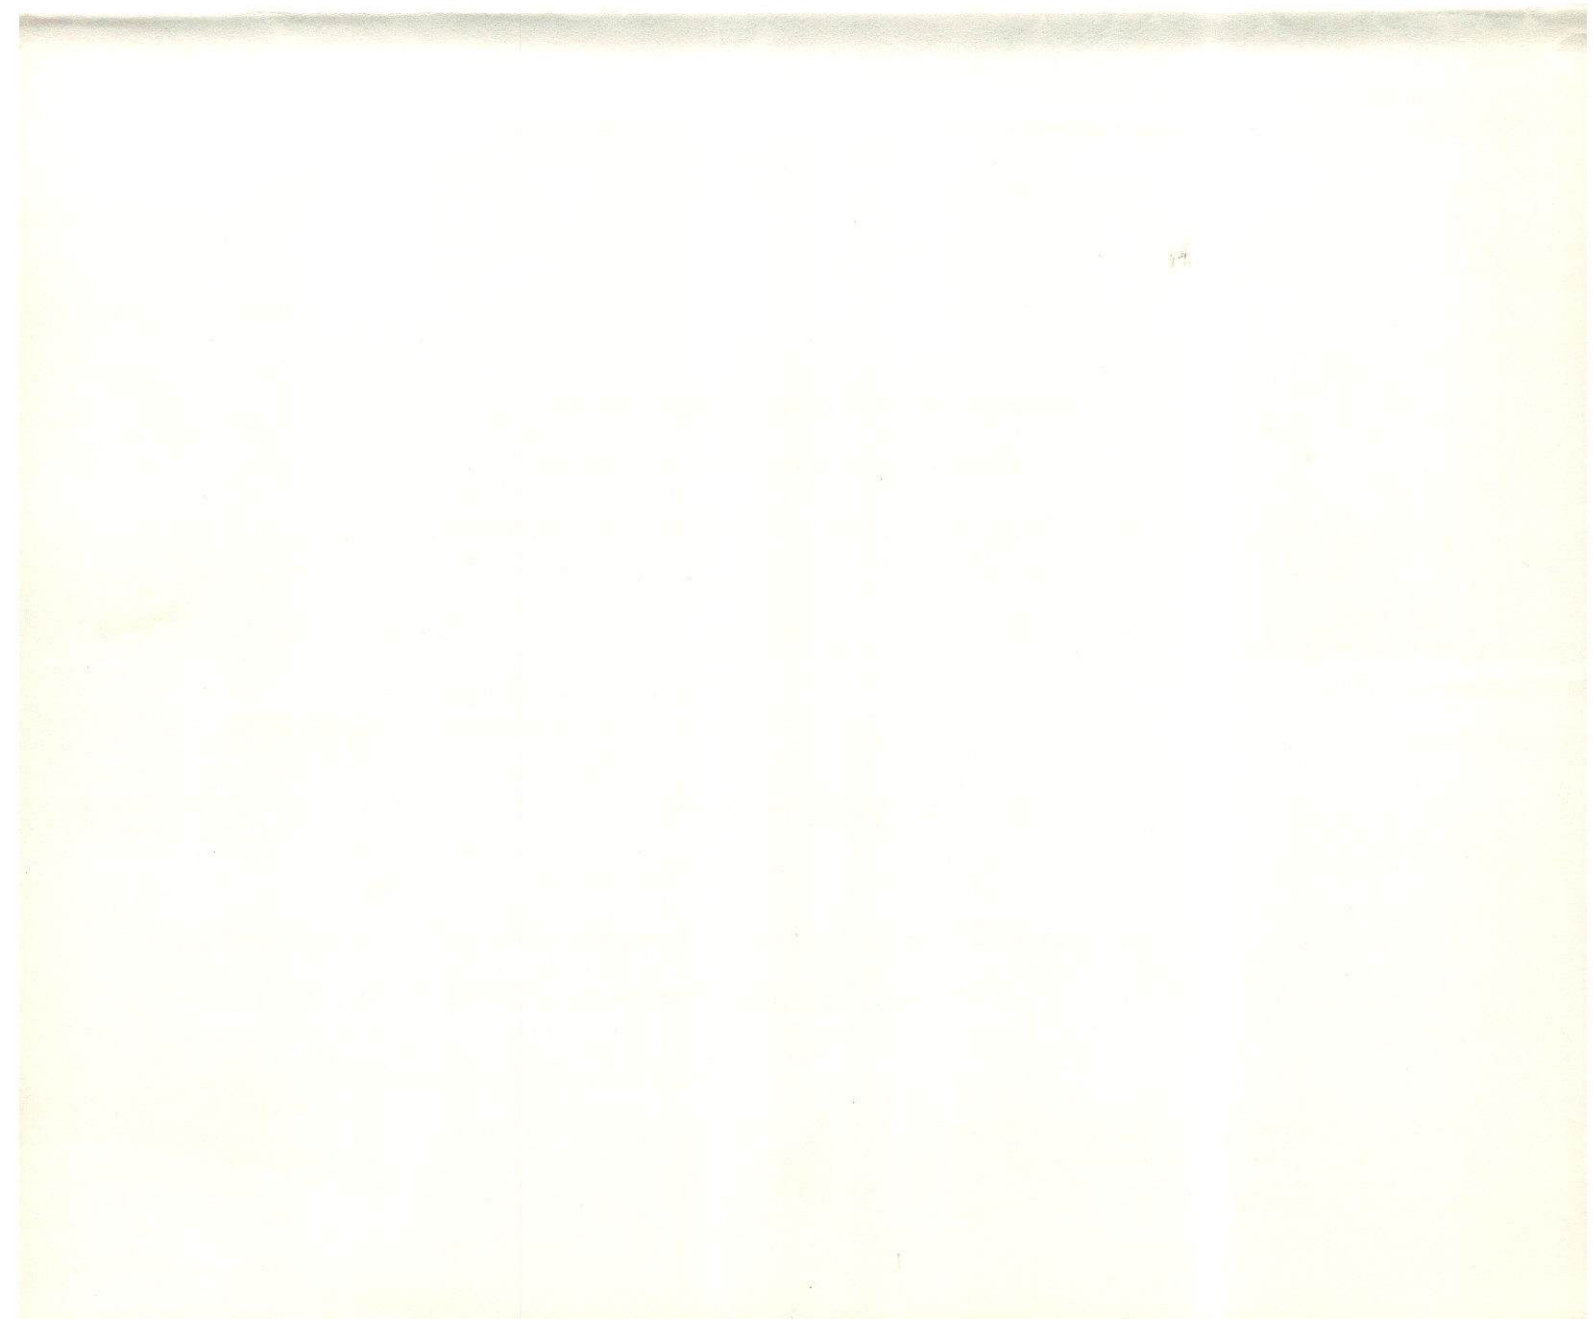

# NOTICE TO COMMISSIONER OF PUBLIC WORKS

16  
23

Length of drain.....38'  
Sewer depth.....8'  
Surf. drain.....6'

.....2 pipe system

Drain Permit **Nº 19244**

City of New Bedford,

Office of City Clerk, *March 24, 1971*

To Commissioner of Public Works.

Permission has this day been issued to

*James Bento*  
.....  
Property owner

*118 Nash Rd., NB.*  
.....  
Address

PAID By *John DeTerra*  
.....

*146 Milford St., NB.*  
.....  
Address

to lay drain from the premises of *James Bento*  
*Raymond St. w/s 50' s of York St.*  
.....  
to connect with the sewer in *Raymond*.....street.

Laid from main in street to iron pipe in property.

Owner agrees to supply all necessary

*Transite*.....pipe.

*Ellen M. Gougher sp*  
.....  
City Clerk.

Requires separate entrance for sewage and roof water

*OK*



## RETURN OF FOREMAN

Entered. 10 A.M., Apr. 14 19 76

Time 10-AM.

By Leola M. Jones

## COST

## Labor

hours @

Jesse Taudres	"	3.39	27	12
---------------	---	------	----	----

Joseph Alfonso	5"	312	15	60
----------------	----	-----	----	----

Robert St. Pierre 8" 2.96	23	66
---------------------------	----	----

Joseph Jardin 8 " 3.17	24	96
------------------------	----	----

Thomas Burk 8"	3.37	26	96
----------------	------	----	----

Rod Bragg	8" 3.58	28	64
-----------	---------	----	----

Step 12 bor	3 "	8 58
-------------	-----	------

Stock	15352
-------	-------

1/2 bag Cement @ 1.8	90
----------------------	----

100 lbs. sand	11
---------------	----

13 x 3 Black-top Street

@ 2.85	3200
--------	------

	380
--	-----

## Trucking

# 65-3-HRS. @ 655	19 65
-------------------	-------

67 - 1-HR, ✓	3	00
--------------	---	----

21 - 1-HR Longen	3	35
------------------	---	----

Total Cost

Estimate-cost of laying drain	268 - 219.58
-------------------------------	--------------

Entrance charges	ASSESSED		
------------------	----------	--	--

Total deposit				
---------------	--	--	--	--

Balance due	De Luna	48	42
-------------	---------	----	----

Pieces pipe to curb (2) 1-10 ft. 1-5 ft.

" " curb to house (3) - 1-10 ft. 1-10 ft. 1-5 ft

Cut at sewer  $7\frac{1}{2}$  ft.

Cut at curb 7 41

Size of pipe 4" x 6" Transit

Correct

Correct 6.4

Foreman