 
## CITY OF NEW BEDFORD

## APPLICATION FOR LAYING DRAIN

Application Nº 19259	Board of Health Permit No.
	New Bedford, Mass., May 13, 1911
To the Mayor and City Council:	I from the premises of Myron Marder
I hereby request that a drain be laid	from the premises of hugain humans
es Hushnel Hin	renue 40's of Barkers Lane
to connect with the sewer in	Asushnet Are street,
the same to be laid in the street and th Works.	e surface repaired as directed by the Commissioner of Public
I hereby agree to pay at the office of the manner specified, in excess of the dethe work.	of the City Treasurer all cost of performing the above work in leposit made herewith, within 10 days after the completion of
payment of the cost of performing the be returned to me by the City Treasure	ne deposit made with this application shall be applied to the work done, and that any excess of deposit over the cost shall r.
Witness L. Bryant	Mynn Marder
	Property owner
	3/ Amor St. Mar Ded ful Moss
	By Cllut P Silva Z Reg. Plenter
Requires separate entrance	25 Spring A. Fautare Mass 02718
for roof water	Address
Consent	of Owner of Private Drain
To the Mayor and City Council:	New Bedford, Mass.,
1 3	
through the private drain owned by me	connecting with sewer in
	street.
	Owner
Estimate	and Deposit Requirement
Office	of Commissioner of Public Works,
	e drain described in the above application is
8 10000	~~
Assessed	# 19000
Entrance charges	Total deposit required
	Total deposit required  A C Anderson RB.
	Commissioner of Public Works
	Certificate of Issue
	Office of City Clerk,
1	d by City Treasurer's receipt presented this day; whereupon
Permit No. 19259 was	s issued, and the Commissioner of Public Works notified of the
same.	Ellen M. Taughangs. City Clerk
Laid from main in street to iron nine in measure.	City Clerk
Laid from main in street to iron pipe in property  Owner agrees to supply all necessary	
Lianate pipe	



	NOTICE TO COMMISSIONER OF PUBLIC WORKS	/
M	Length of drain 25 billed \$3(7100)	2
' KI	Sewer depthpipe system	-
4/	Surf. drain	
1/	Drain Permit Nº 19259 City of New Bedford,	
U	Office of City Clerk, May 13, 1911	
	To Commissioner of Tubic Works.	
	Permission has this day been issued to	
	Myron Marder - 338 Houshnet Hvenue	1
	Property owner  Address Facility of Facili	
	By Filed Address	
	to lay drain from the premises of Myron Marder	
1	es Acushnet Ave. 40's of Barkers Lane	
X	0 + 1 + 1	
1/	to connect with the sewer in Acusknet Ave street.	
Nr.	Laid from main in street to iron pipe in property.  Owner agrees to supply all necessary  Ella M. Jaughan	
a	Iransite pipe. ( B City Clerk.	
	Requires separate entrance for sewage and roof water	
	Relay	

RETURN OF FOREMAN Entered May 19 12,00 NOON Labor hours @ Jesse 1202125 3.39 31,20 osephlardin 10 Joseph Alfonso 31.20 3.12 NOR bert ST. Pierre 10 2.86 28 60 Joseph Macodo10" 35.80 Manyel Broge 18 3.58 35.80 196 Stock 1629 Comen Appleco 15x2 Block-Top Streetern Squares #35-2-HRS @6.55 @3.00, @3.35 3.35 Total Cost Estimate-cost of laying drain 190 000 W. Supplied Entrance charges Total deposit Balance due Pieces pipe to curb / / / / / curb to house from (plumber elo perpi Cut at sewer 6 ft Cut at curb 5 Size of pipe 6 " VITTIS red Clay Correct Conduits - Cables -925-line, All hand work