 
## CITY OF NEW BEDFORD

## APPLICATION FOR LAYING DRAIN

Application Nº 19269	Board of Health Permit No
	New Bedford, Mass., June 7, 1971
To the Mayor and City Council:	d from the premises of BUB. Coxst Colne
My My T. St	· 340'w of Jenny Line It.
January Da	Jane Janes
	<i>Y</i> -
to connect with the sewer in the same to be laid in the street and the Works.	Leart street, he surface repaired as directed by the Commissioner of Public
I hereby agree to pay at the office the manner specified, in excess of the the work.	of the City Treasurer all cost of performing the above work in deposit made herewith, within 10 days after the completion of
payment of the cost of performing the be returned to me by the City Treasure	the deposit made with this application shall be applied to the work done, and that any excess of deposit over the cost shall er.
Witness L. Bryant.	This conf In by the & all property owner 584 County of Address
	Property owner
	Address
	Ву
Requires separate entrance for roof water	Address
Consont	of Owner of Private Drain
Consem	
To the Mayor and City Council:	New Bedford, Mass.,
I hereby grant to	
the privilege of draining premises	
through the private drain owned by me	e connecting with sewer in
	street.
	Owner
Estimate	and Deposit Requirement
Office	of Commissioner of Public Works,
My estimate of the cost of laying the	ne drain described in the above application is
Assessed	1 2/1/
Entrance charges	Total deposit required \$ 26400
	a C Anderson & B, Commissioner of Public Works
	Commissioner of Tubile Works
	Certificate of Issue
	Office of City Clerk,
The above application, accompanie	ed by City Treasurer's receipt presented this day; whereupon
	as issued, and the Commissioner of Public Works notified of the
same.	
	Ellen m Taughan City Clork 23
Laid from main in street to iron pipe in propert	cy.



Length of drain 38 Beled 7 (5/200	
Sewer depth	em
Surf. drain	
Drain Permit Nº 19269 City of New Bedford,	
Office of City Clerk, June 1, 1971	
To Commissioner of Public Works.	
Permission has this day been issued to	
BWB. Const. Co. Inc 584 County St	
Property owner Address	
By Harry Williams	a
Address Address	
to lay drain from the premises of BWB Congst. Co. Luc.	
ns Grant It 340' w of Jenny Line It	
to connect with the sewer in	et.
Laid from main in street to iron pipe in property.  Owner agrees to supply all necessary  Eller M Jauglan A	CB.
Transite pipe. City Clerk.	walt,
Requires separate entrance for sewage and roof water	st north of
Aux Dux	Youword MR

## RETURN OF FOREMAN

RETURN OF FOREMAN	
Entered Ture 25 1971	
Time 11. A.M.	
By Losse In Javores	
COST	
Labor hours @	
Jess'e 1 200 / 3.39 23.73 "	
Joseph Jardin 7 " 3.12 21.84 "	
Novboy 1 St. Piene 7" 2.86 20.02	
Ban 13 (292) 7" 3.58 25.06	
harry Chaquetto 7" 3.58 25.06/	
" 137.55	
Stock	
6 1/2 b 2 9 Comont @ 180 90	
10,0165 Sand 2.12	
= Replace 16x 3 B.T. Street 4160	
- Replace 16x 3 B.T. Street 41 60 - 4x 4 From a Squeros 960  Trucking	
5 17/957. \$550	
3 1 1 1 1 1 1 1 1 1 1 1 1 1 1 1 1 1 1 1	
0	
52-1-HR, Dorghena 3,35	
Total Cost  Estimate-cost of laying drain   204   20	
Estimate-cost of laying drain 264 00 Entrance charges	
Total deposit	
Balance due Burb 50 78	
Oliver I made	
Pieces pipe to curb 3 /- 10 ft.	
" " curb to house 3) /-10ft. /-10ft. /-1	
Cut at sewer 2	
Cut at curb 6 5	
Size of pipe 6" Trons to	
Correct	
Foreman	
1 ordinali	