 
CITY OF NEW BEDFORD

APPLICATION FOR LAYING DRAIN

Application Nº 19294	Board of Health Permit No.
	New Bedford, Mass., July 15,197
To the Mayor and City Council: I hereby request that a drain	n be laid from the premises of a common Lib
333 Lo Lui	in the second se
La Autoria Complet	
to connect with the sewer in the same to be laid in the street Works.	t and the surface repaired as directed by the Commissioner of Public
I hereby agree to pay at the the manner specified, in excess of the work.	e office of the City Treasurer all cost of performing the above work in of the deposit made herewith, within 10 days after the completion of
It is understood and agreed payment of the cost of performi be returned to me by the City	I that the deposit made with this application shall be applied to the ing the work done, and that any excess of deposit over the cost shall Treasurer.
Witness R Miemi	Aune Liho
	117 Main L'Auchare Mass 02715 Address
	By Ellhot & Selace
Requires separate entrance for roof water	25 Janny & Farham Moss 0271
Cor	nsent of Owner of Private Drain
To the Mayor and City Council:	New Bedford, Mass.,
the privilege of draining premise	S
through the private drain owned	l by me connecting with sewer in
	street.
	Owner
Fe	timate and Deposit Requirement
LS	
	Office of Commissioner of Public Works, 197
My estimate of the cost of la	aying the drain described in the above application is
1	
Assessed Entrance charges	Total deposit required 341.
	Commissioner of Public Works &
	Certificate of Issue
	Office of City Clerk,
The above application acco	ompanied by City Treasurer's receipt presented this day; whereupon
Permit No.	was issued, and the Commissioner of Public Works notified of the
MANAGE TO THE STATE OF THE STAT	
	City Clerk
Laid from main in street to iron pipe in Owner agrees to supply all neces	n property.



NOTICE TO COMM	NISSIONER OF PUBLIC WORKS
Length of drain	Billed \$20/12, 00,
Sewer depth	pipe system
Surf. drain	
Drain Permit Nº 19294 City	of New Bedford,
To Commissioner of Public Works.	Office of City Clerk, July 15 1971
Permission has this day been issued to	
arrora Liba	117 Main It Fairlanen
By albert P. Schra	Address 2.5 Spring St. Tauchanen, ma Address
to lay drain from the premises of Que	iora Lilva
333 Lo Lint	
to connect with the sewer in	
Laid from main in street to iron pipe in property. Owner agrees to supply all necessary	Eller M. Lurghan City Olerk. Fix
teausite pipe.	City Clerk.
Requires separate entrance for sewage and re	of water
"celay"	

RETURN OF FOREMAN

RETUI	RN OF	FOR	EMAN	4	
Entered Jul	4 5	3		19	71
Time 11.	à, M,				
By Jane	m	7	2000	9	
	COS	Т			
				1	
Labor		hours			
Joss e Tevai		"	3.39		.51
Woseph Alfons	0 9		3.12	-	.08
Worked Stilie		"	3.12	-	.08
STEP DYIVE, 4	- 9 9	"	2.86		.74 √
Tom Burk		"	3.37	N	.33
Joseph Macoc	10 9	"	3.58	32	. 22
		"		174	96
Stock	1.0			-	
12 00 3 (0	1 0	1.80			.90 V
100/655=	and a		1	./1	.12
pair 1513 Blac		Tres		41	177
(2) Grano 4x4.	Sgyar		dk +s	50	09/
To line	gyo. W	14.0	υ	XT.	87"
Trucking	R 5 - @6			3.7	70 (
1 / / / -					.10 V
		. 35			.35
52 ~ 1-H1	(, &	. 00		26	
Total Cost	1	. 115	ull .	00	0.0
Total Cost Estimate-cost of Entrance charge Total deposit			41-		
Entrance charge Total deposit	28				
Balance due		[1		78	93
0 /01.11.1	0		/	10	10
Pieces pipe to co		-10-		54	1, 1
" " curl	to house	5)1-	541.	4-4	foot
Cut at sewer.	r ft.		<i>.</i>		
Cut at curb	, et.				
Cut at curb	, c T	~	25.7	0	
Correct					
		V			
des	ne bu	5.00	bud	Forem	
			- 19	r orem	lall