 
CITY OF NEW BEDFORD

APPLICATION FOR LAYING DRAIN

Application Nº 19296	Board of Health Permit No.
	New Bedford, Mass., Lune 21, 1971
To the Mayor and City Council: I hereby request that a drain be	laid from the premises of It Leikes Hospital
se Taber St.	330 w of Page It
	7-1-
to connect with the sewer inthe same to be laid in the street and Works.	d the surface repaired as directed by the Commissioner of Public
I hereby agree to pay at the office the manner specified, in excess of the the work.	ce of the City Treasurer all cost of performing the above work in ne deposit made herewith, within 10 days after the completion of
payment of the cost of performing the returned to me by the City Treas	
Witness W. Howart	h UB khi
	By LORANGER CONSTRUCTION CORP
	Address Construction Con O
	PO, BOX 808 NEW BEDFORD MA
Requires separate entrance for roof water	Address
Conser	nt of Owner of Private Drain
	New Bedford, Mass.,
To the Mayor and City Council:	Tiew Bedford, Massi,
I hereby grant to	
the privilege of draining premises	
through the private drain owned by	me connecting with sewer in street.
	Owner
Estimo	ate and Deposit Requirement
Off	fice of Commissioner of Public Works,
My estimate of the cost of laying	g the drain described in the above application is
Assessed Entrance charges	Total deposit required 176.00
	Commissioner of Public Works
	Certificate of Issue
	Office of City Clerk,
	nied by City Treasurer's receipt presented this day; whereupon
Permit No. 19296	was issued, and the Commissioner of Public Works notified of the
same.	Pre nu by 1
= **	Eller M Taughan
Laid from main in street to iron pipe in prop Owner agrees to supply all necessary	perty. Line
Transite	pine.



	NOTICE TO COMMISSIONER OF PUBLIC WORKS	
	Length of drain 28' Billy 9/23/71 (D)	2.
11	Sewer depth81/2	pipe system
	Surf. drain	
	Drain Permit Nº 19296 City of New Bedford,	21 1021
	To Commissioner of Public Works. Office of City Clerk,	Q.1, 1971
	Permission has this day been issued to	
	St. Lukes Hospital Page St.	
DOID	Property owner Address	2 0111
PHID	By Loranger Coast Cosp 10 Bot D-808	The Sedford
William Company of the Company of th	to lay drain from the premises of St. Lukes Hospital	
~	ss Javer St 330' w of Page St.	
10)	to connect with the sewer in Taber It	street.
(APV	Laid from main in street to iron pipe in property. LINE OIL M M	
PI	Owner agrees to supply all necessary	N.
	Characte pipe.	AB. City Clerk.
	Requires separate entrance for sewage and roof water Assessed Storm	water
	connection one	ly
		1

RETURN OF FOREMAN

Seph Almso 13 " 3.12 40.5 rbort ST. Pierro 13 " 3.12 40.5 rbort ST. Pierro 13 " 3.12 40.5 rbort ST. Pierro 13 " 2.86 37.1 43.8 To M Burk 13 " 3.37 43.8 To M Burk 13 " 3.58 35.8 35.8 rbord Braga 3" 3.58 10.7 stock \$263.4 rbord & 10.7 stock \$10.7 stock \$		2 2 1		
COST Labor hours @ Josse Town 13 " 3.39 \$44.00 See th Alanso 13 " 3.12 40.50 STE P 34 1/10 1 3 " 3.37 Town 13 " 3.58 35.80 Fight 13 " 3.58 35.80 Fight 13 " 3.58 35.80 Fight 14 15 10 10 10 10 10 10 10 10 10 10 10 10 10		J.Z		19
Labor hours @ Sosse Susceptible Susce	(10	2 201 4		
Labor hours @ Sosse Susses 13 " 3.39 \$44.00	By Jose	M Ne	voce	<i>Э</i>
See ph plans o 13 " 3.39 \$44.00 See ph plans o 13 " 3.12 Jort ST. Porto 13 " 3.12 Tort ST. Porto 13 " 3.37 Rod Braga 10 " 3.58 Stock Stock Stock Trucking Trucking Trucking Total Cost Estimate-cost of laying drain Entrance charges Total deposit Balance due Pieces pipe to curb 4 3-10 footoos 1-8 footoos Cut at sewer 7 footoos Cut at curb 6 footoos Correct Correct Total Correct Correct Correct Total Correct Correct Total Correct Correct Total Corre	0	COST		
Trucking Total Cost Estimate-cost of laying drain Entrance charges ASSED Total deposit Balance due Total sewer 7 Cut at sewer 7 Cut at sewer 7 Cut at curb 6 Size of pipe 6 Total Cost Correct Total Cost Cut at sewer 7 Cut at curb 6 Correct Total Cost Cut at sewer 7 Cut at curb 6 Correct Total Cost Correct Total Cost Cut at curb 6 Correct	Labor	hour	s @	
Trucking Total Cost Estimate-cost of laying drain Entrance charges ASSESTED Total deposit Balance due Cut at sewer 7 Cut at sewer 7 Cut at sewer 7 Cut at curb 6 Correct Total Cost Correct Total Cost Cut at sewer 7 Cut at curb 6 Correct Total Cost Correct Total Cost Cut at curb 6 Correct	Josse Tour	wo 13 "		\$44.07
STEP 34 1 (a, 4 - 13 " 2.86 37.16 To M By K 13 " 3.37 Rod Braga 10 " 3.58 Stock 3.58 Stock 263.4 Stock 263.4 Trucking 43 9 - 1 - HR. @6.40 6.40 Trucking 43 9 - 1 - HR. @6.55 6.55 G7 - 1 - HR. @6.55 6.55 Estimate-cost of laying drain 176 - Entrance charges ASSESSED 7 Total deposit Balance due 27 1 - 107 Cut at sewer 7 6 Cut at sewer 7 6 Cut at curb 6 6 7 R Correct 7 7 2.86 37.16 Size of pipe 8 " The ans. to P. R Correct 7 7 Ans. to P. R	Toseph Alfon	50 13 "		40.56
To M By K 13 " 3.37	rbort ST. Pix	n ~ 13		
Rod Braga 10 " 3.58 35.88 First Berlo Success 3" 3.58 10.74 Stock Sto	STEPZYVIA	1777		
Stock Stock	TOM BULK	0 13		The same of the sa
Stock Stock	Louis MIFE	0 / / 0		1074
Trucking Trucking Trucking Total Cost Estimate-cost of laying drain Entrance charges ASSESSED Total deposit Balance due Pieces pipe to curb 4, 3-10 footstes 1-8 footstes 1-8 footstee 1-10 fo	FLORIBERTO	Sug 2 3		10.74
Trucking 39 - - HR @6.40 6.40 395 - - HR @6.55 6.55 673 - - HR @3.00 3.00 Total Cost Estimate-cost of laying drain 176 - H7 86.80 Entrance charges SSFSFD Total deposit Balance due 270 86 Pieces pipe to curb 4 3 - 10 for tous 1 - 8 for tous 1 - 10 for tous	Valaga	ta	100	\$263.46
Trucking # 39 - /- HR @6.40 6.40 35 - /- HR @6.55 6.55 6.5 6.50 6.60 6.40 6.40 6.40 6.40 6.40 6.40 6.40 6.40 6.4	12 0 0 9	anout (a	1.9	- 90
Trucking # 39 - /- HR @6.40 6.40 35 - /- HR @6.55 6.55 6.5 6.50 6.60 6.40 6.40 6.40 6.40 6.40 6.40 6.40 6.40 6.4	1200 78 V.3	Blackstop	SPENSE.	113,30
Trucking # 3 9 - / - HR . @6.40	(2) 4x4 9r	moulalk	6	49-78
Total Cost Estimate-cost of laying drain Entrance charges ASSESED Total deposit Balance due Pieces pipe to curb 4 3-10 footous 1-8 footous 1-8 footous 1-10	3	15/9 sy @1	4.00	-
Total Cost Estimate-cost of laying drain Entrance charges ASSESED Total deposit Balance due Pieces pipe to curb 43-10 foot as 1-84 " " curb to house 3 1-10 foot as 1-84 Cut at sewer 7 ft Size of pipe 6 " The Anguito P.R. Correct	Trucking	0.		
Total Cost Estimate-cost of laying drain Entrance charges ASSESSED Total deposit Balance due Pieces pipe to curb 4 3-10 footers 1-84 " " curb to house 2 1-10 ft 1-10 ft Cut at sewer 7 ft Size of pipe 8 " The Angle to P. R. Correct	#39-1	- HR. @6.	40	6.40
Total Cost Estimate-cost of laying drain Entrance charges ASSESED Total deposit Balance due Pieces pipe to curb 4 3-10 footous 1-84 " " curb to house 2 1-10ft 1-10f Cut at sewer 7 ft Size of pipe 6 " The Ans. to P. R. Correct	35-1			
Estimate-cost of laying drain 176 - 446.8 (Entrance charges ASSESSED Total deposit Balance due Pieces pipe to curb 43-10fostous 1-84 " " curb to house 3 1-10ft 1-10f Cut at sewer 7 ft Size of pipe 6 " The Ans. to P. R. Correct	52-1	- HR 183.	00	
Entrance charges ASSESSED Total deposit Balance due Pieces pipe to curb 4 3-10 footess 1-8 f " " curb to house 2 1-10 f Cut at sewer 7 f Cut at curb 6 ff Size of pipe 6 " The Ans. to P. R Correct	The second secon	1.1760.	-	
Pieces pipe to curb 4 3-10 forters /-8 f " " curb to house 2 /-10 ff /-10 f Cut at sewer 7 ff Size of pipe 8 " The ansito P. R Correct			176 -	446.86
Pieces pipe to curb 4) 3-10 footous 1-8 f " " curb to house 9 1-10 ft. 1-10 f Cut at sewer 7 ft. Cut at curb 6 ft. Size of pipe 6 " 7 n 2m 8, to P, R Correct		zes ASSESSED		
Pieces pipe to curb 4 3-10 footous 1-8 f " " curb to house 2 1-10ff, 1-10f Cut at sewer 7 ft Size of pipe 8 " The ansito P. R Correct		At I	7	Major
" " curb to house 2 /-10ff /-10f Cut at sewer 7 ft Size of pipe 8 "The ms. to P. P. Correct	Balance due	Cuy.	1 ×	1000
Cut at sewer 7 ft Cut at curb 6 ft Size of pipe 8 "Transito P.R Correct	Pieces pipe to	curb 4 3-10	fooler	0 1-87
Cut at curb 6 ft Size of pipe 8 "Transito P.R Correct	" " cui	rb to house	1-10/9	1-107
Cut at curb 6 ft Size of pipe 8 "Transito P.R Correct	Cut at sewer	7 ft,		
Correct	Cut at curb.	o ft		
Correct	Size of pipe	8 " Tr	-ams.t	O P.R
Kase M Janns	Correct			
Foreman	1	a Tu Year	2	
	Kosa	e w ser	Fo	reman
	1 10	of Mar	100 100	L. X