 
CITY OF NEW BEDFORD

APPLICATION FOR LAYING DRAIN

Application Nº 19297	Board of Health Permit No. July 26,197!
	New Bedford, Mass.,
	from the premises of Welleam R. Burgess
ws Caroline S	t opp Seprester It.
.,	
	surface repaired as directed by the Commissioner of Public
I hereby agree to pay at the office of the manner specified, in excess of the depthe work.	the City Treasurer all cost of performing the above work in posit made herewith, within 10 days after the completion of
It is understood and agreed that the payment of the cost of performing the wobe returned to me by the City Treasurer.	deposit made with this application shall be applied to the ork done, and that any excess of deposit over the cost shall
Witness Sujant	Wellian R School Property owner of 10/2
	89 Carolen Sheet N.B.
	Address
В	Y
	,
Requires separate entrance or roof water	Address
Consent of	Owner of Private Drain
o the Mayor and City Council:	New Bedford, Mass.,
are privilege of draining premises	
through the private drain owned by me of	onnecting with sewer in
	street.
	Street
	Owner
Estimate o	and Deposit Requirement
Office of	Commissioner of Public Works,
My estimate of the cost of laying the	drain described in the above application is
Assessed E ntrance charges	Total deposit required 338.00
Assessed Entrance charges	Total deposit required 338.00 Commissioner of Public Works
Entrance charges	& C anderson ps.
Entrance charges	Commissioner of Public Works
E ntrance charg es	Commissioner of Public Works ertificate of Issue
The above application, accompanied 1	Commissioner of Public Works ertificate of Issue Office of City Clerk, by City Treasurer's receipt presented this day; whereupon
The above application, accompanied 1	Commissioner of Public Works Commissioner of Public Works Office of City Clerk, by City Treasurer's receipt presented this day; whereupon assued, and the Commissioner of Public Works notified of the
The above application, accompanied learning No.	Commissioner of Public Works ertificate of Issue Office of City Clerk, by City Treasurer's receipt presented this day; whereupon



	NOTICE TO COMMISSIONER OF PUBLIC WORKS
1	Length of drain 48 Billet 8/28/71 (5)
P	Sewer depth
	Surf. drain
	Drain Permit Nº 19297 City of New Bedford,
200	Office of City Clerk, July 26, 1971
- 2	To Commissioner of Public Works. Permission has this day been issued to
	William R. Burgess 89 Caroline St. Address
	By Same same
1	Address
	to lay drain from the premises of William K Singles
1	ws. Caroline It opp Sylvester It
X	to connect with the sewer in Caroline street.
50/	Laid from main in street to iron pipe in property.
V	Owner agrees to supply all necessary City Clerk.
	Iransite pipe. City Clerk.
	Requires separate entrance for sewage and roof water
	Reserved

RETURN OF FOREMAN Entered Aug. July 2 1971 Time 2,00 P.M COST Labor hours @ Jesse Tavares Joseph Allon So Norbout ST. Prope STEP GUIVERS 17.16 Joseph Mecod 21.48 Joseph Jardin Stock . 90 1-4x4 9kono-walk. Trucking Has-@6.55 ordson 13.10 3.35 201-21 Total Cost Estimate-cost of laying drain Entrance charges Total deposit Balance due Pieces pipe to curl 2 1-10 curb to house 3)-1-10ft. 1-10ft. 1-8f Cut at sewer & H Cut at curb 7 I rons it o Size of pipe 6 Correct are Javores of Foreman