 
CITY OF NEW BEDFORD

APPLICATION FOR LAYING DRAIN

Application N. 19349	Board of Health Permit No.		
	New Bedford, Mass., 11-4-71		
To the Mayor and City Council: I hereby request that a drain be laid from the	premises of SS Clipad St		
250' ± E & Allino	ton Stoot 60		
)		
100,104			
to connect with the sewer in the same to be laid in the street and the surface Works.	repaired as directed by the Commissioner of Public		
the manner specified, in excess of the deposit mathe work.	Treasurer all cost of performing the above work in de herewith, within 10 days after the completion of		
payment of the cost of performing the work done be returned to me by the City Treasurer.	made with this application shall be applied to the e, and that any excess of deposit over the cost shall		
Witness Moffman Sav	oud Rolling		
0 - 1	267 ASKLY 3120		
7	onel J. Dulusle		
tald By h	and J. Dulliere		
Requires separate entrance SCo-Co	Brienliffe Rd		
Total Wales	Address Fairhaven Mars		
Consent of Owner of Private Drain			
To the Mayor and City Council:	New Bedford, Mass.,		
I hereby grant to			
the privilege of draining premises			
through the private drain owned by me connecting	g with sewer in		
	street.		
	Owner		
Estimate and Deposit Requirement			
	ssioner of Public Works, 11-4-71		
My estimate of the cost of laying the drain de	escribed in the above application is		
Assessed Entrance charges \$14.00	Total deposit required QQ.		
	A.C. Anderson		
	Commissioner of Public Works		
Certificat	e of Issue		
	Office of City Clerk, N-4-71		
The above application, accompanied by City	Treasurer's receipt presented this day; whereupon		
Permit No. 19349 was issued, a	nd the Commissioner of Public Works notified of the		
same.	Eller M. Grughon		
Laid from main in street to iron pipe in property.	City Clerk		
Owner agrees to supply all necessary	8 v		



Billed 12/10/71 (50) Length of drain 2 % Sewer depth 7/2pipe system Surf. drain City of New Bedford, Office of City Clerk, Nov 4,1971 To Commissioner of Public Works. Permission has this day been issued to Property owner to lay drain from the premises of SS Cultata St to connect with the sewer in..... Laid from main in street to iron pipe in property. Janohou Owner agrees to supply all necessary City Clerk. Requires separate entrance for sewage and roof water

NOTICE TO COMMISSIONER OF PUBLIC WORKS

RETURN OF FOREMAN

	*	
	Entered NOV 4 15	19 7/
	Time 3, 30 1, 201	
	By Josel M Jou	020
	COST	
·	Labor hours @	
Rill	Jesse Parson 8" 339	27/2/
Wo.	Ma 1 -T DI Qu Dia	21196
L'al	2 (1 by NOVI 2 8" 3/2	2496
Kill k	TOM BURK 8" 1337	26 96
	To seph Mocodo 8" (358	1864
	"	10
	"	320
	Stock	
	12 ba & Coment@1Po	1.90
()	100/65 Sand	1.12
Poles	ce 12 ×3 B.T. STreet @253	39201
7 4	X46bono Sq. Wolk	5.400
	17195 Jd & 14.	24891
	Trucking	
#	435-3-4183,66.55	1965
	67-1-HR, P3.00	300
	50-1- FIN 103.35	305
	Total Cost	253.75
5	Estimate-cost of laying drain 2/2 -	
	Entrance charges ASSESSED	
0	Total deposit	11171
-,7	Balance due	11 /4
	Pieces pipe to curb	- 2. ft,
10	" " curb to house	11-10/1, (2)
	Cut at sewer 8 ft	
)	Cut at curb 741	
)	Size of pipe by Transite	32 ft
	Correct	,
)		
	Done W Porodo	Foreman
		1 Of Cilian