 
## CITY OF NEW BEDFORD

## APPLICATION FOR LAYING DRAIN

Application Nº 19364	Board of Health Permit No.	
	New Bedford, Mass., December 2,1971	
To the Mayor and City Council:	n the premises of	
Ne Kla	12 adaman.	
11.5. 108	BOSINDO SX.	
250, ± E	E of Stanley St.	
to connect with the sewer in	face repaired as directed by the Commissioner of Public	
I hereby agree to pay at the office of the the manner specified, in excess of the deposit the work.	City Treasurer all cost of performing the above work in t made herewith, within 10 days after the completion of	
payment of the cost of performing the work be returned to me by the City Treasurer.	posit made with this application shall be applied to the done, and that any excess of deposit over the cost shall	
Witness Shafman I	ous Inc.	
O	Property owner  12 Cook Street  Address	
	) Tradition	
$\mathrm{By}^{\times}$	Luclow Lowers	
Requires separate entrance for roof water	Address	
Consent of Owner of Private Drain		
To the Mayor and City Council:	New Bedford, Mass.,	
I hereby grant to		
,		
through the private drain owned by me conn	ecting with sewer in	
	street.	
	Owner	
Estimate and	Deposit Poquirement	
	Deposit Requirement	
Office of Co	ommissioner of Public Works, December 2, 1971	
My estimate of the cost of laying the drain \$395	in described in the above application is	
Assessed Entrance charges \$15 00	Total deposit required \$410.00	
Entrance charges	A.C. Andrewsoner of Public Works	
Certi	ficate of Issue	
	Office of City Clerk, December 2, 1971	
The characteristics assumed by		
	City Treasurer's receipt presented this day; whereupon	
	ed, and the Commissioner of Public Works notified of the	
same.	Silmy M. Condia.	
Laid from main in street to iron pipe in property.	Ellon M. Ganghou City Clerk	
Owner agrees to supply all necessary  Thombut pipe.	City Clerk	

not assessed - entrance for regibl.



NOTICE TO COMMISSIONER OF FOBLIC WORKS
Length of drain 83 Billy 2/4/22 5
Sewer depth pipe system
Surf. drain
Drain Permit. Nº 19364 City of New Bedford,
Office of City Clerk, Decam bel 2,1971
To Commissioner of Public Works.
Permission has this day been issued to
Don's Inc. 12 Clock St. City
By X Quelow Lower Address
By A Lieban Lawrence Address
to lay drain from the premises of NS Newcombe St
I F of stanley st
to connect with the sewer in 230 Newcombe street.
Waid from main in street to iron pipe in property.  Owner agrees to supply all necessary  Ellem M. Gaughan
Transite pipe. City Clerk.
Requires separate entrance for sewage and roof water
Docimood and sourceting - hogasach AN

## RETURN OF FOREMAN

KETOKIN OF FOREMAIN		
Entered Jan / 3	19 72	
Time 8 AAM		
By Jose M Jova	25	
COST		
Labor hours @	***************************************	
30552 30700 6 3.13	\$22.50 V	
7	19.92 /	
Nower Stitueno & 0.20	17.86	
2000	17.17	
003-11-11-03	3.43	
Tom Burk " 3.45 Joseph Macodo 6" 3.60	21.63	
	121.74	
1/2 h 2 9 ( ement @1.80	.90	
100/65 Sand	12/	
Repairy 243-0: lod gravel		
@1.00 +50	1700	
·		
Trucking		
Trucking #35-3-HR5, @6.55 67-1-HR, @3.00 33-1-HR, @3.35	19.65	
& 67-1-HR, @3.00	3.00 /	
3 3 J - 1 - HR, @3.35	3,35 /	
Total Cost	162:50	
Estimate-cost of laying drain 573		
Entrance charges 15 00		
Entrance charges 15 00 Total deposit Balance due	45030	
Balance due	RAJAT	
Pieces pipe to curb	1-341.	
" " curb to house 6-10 for	ot longths-1-19	
Cut at sewer.	Pier	
Cut at curb 5		
Size of pipe 6 Two sito	80 H,	
Correct		
Soft easy digging		
Foreman		
soft easy diggi	ng	