
CITY OF NEW BEDFORD

APPLICATION FOR LAYING DRAIN

Application Nº 19403	Board of Health Permit No.
	New Bedford, Mass.,
To the Mayor and City Council: I hereby request that a drain	be laid from the premises of BWB Const Inc.
es Church St	255'n of Staron It
to connect with the sewer inthe same to be laid in the street Works.	Church street, and the surface repaired as directed by the Commissioner of Public
I hereby agree to pay at the the manner specified, in excess of the work.	office of the City Treasurer all cost of performing the above work in of the deposit made herewith, within 10 days after the completion of
payment of the cost of performi be returned to me by the City	
Witness Bryant	BUB Construction Inc & the acrible, one
	BWB Construction Fire & My acrille, pres Property owner 584 Court St.
	Address
	Ву
Requires separate entrance for roof water	Address
Cor	nsent of Owner of Private Drain
To the Mayor and City Council.	New Bedford, Mass.,
To the Mayor and City Council:	
* 3	S
	by me connecting with sewer in
	street.
	Owner
Fee	timate and Deposit Requirement
LS	
	Office of Commissioner of Public Works,
My estimate of the cost of la	aying the drain described in the above application is
2 E	122200
Entrance charges	Total deposit required 320 °°
	Lie H Brightman R3 Commissioner of Public Works
	O
	Certificate of Issue
	Office of City Clerk,
The above application, acco	ompanied by City Treasurer's receipt presented this day; whereupon
Permit No. 19403	was issued, and the Commissioner of Public Works notified of the
same.	Ellen M. Jaughan B. City Clerk
Laid from main in street to iron pipe in Owner agrees to supply all neces	ssary
Transite	pipe.

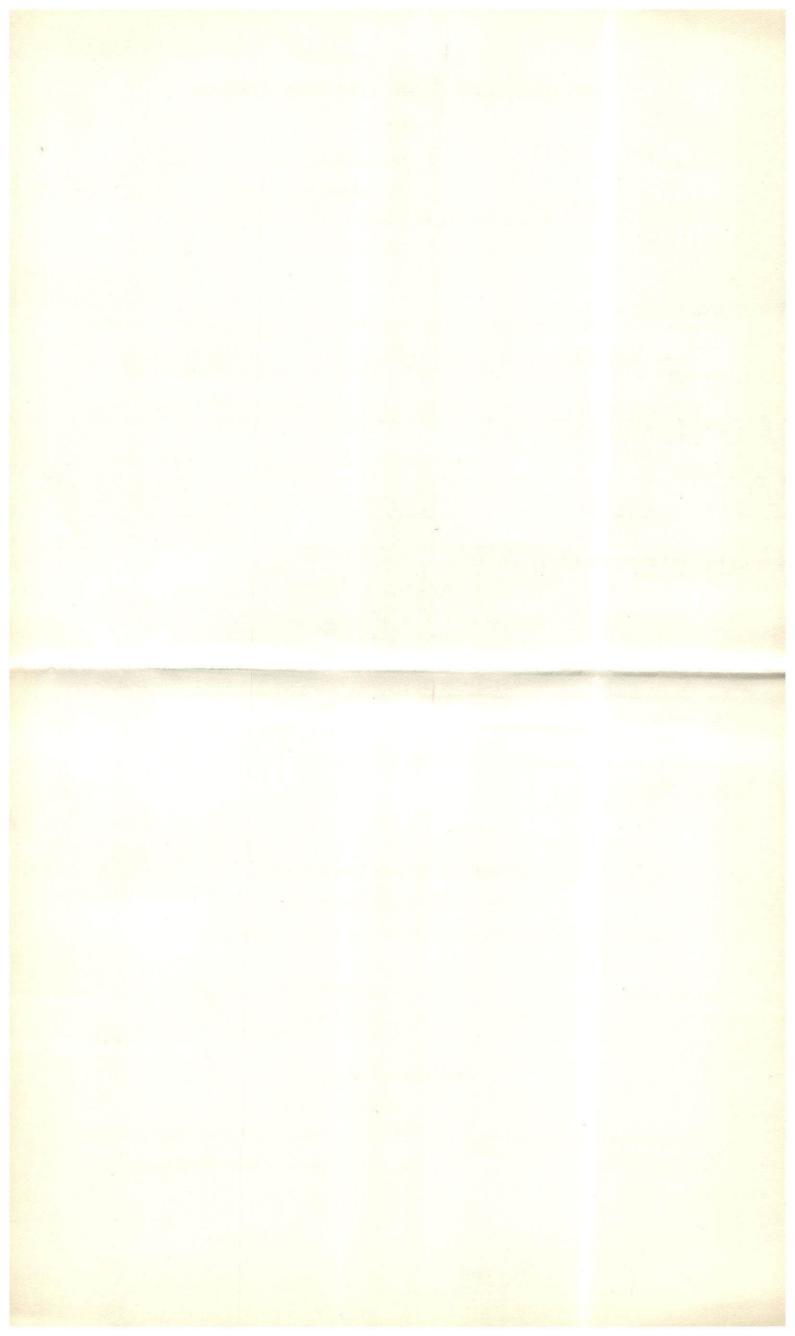

NOTICE TO COMMISSIONER OF PUBLIC WORKS	
Length of drain 48' Billed 89124 @	
Sewer depthpipe syst	em
Surf. drain	
Drain Permit Nº 19403 City of New Bedford,	
Office of City Clerk, Coul 10, 1972	
To Commissioner of Public Works.	
Permission has this day been issued to	
BWB Const. Inc. 584 County Street	
By Chry Williams Address	
to lay drain from the premises of BWB Const Inc.	
es Church It 255 n of Staron St.	
to connect with the sewer in Church stre	et
Laid from main in street to iron pipe in property. Owner agrees to supply all necessary Laid from main in street to iron pipe in property. Laid from main in street to iron pipe in property. Laid from main in street to iron pipe in property. Laid from main in street to iron pipe in property.	
All City Clerk	

Requires separate entrance for sewage and roof water

RETURN OF FOREMAN

RETURN OF FOREMAN
Entered Jyly 24 1972
Time 4.00 P.M.
By Jose M Jornes
COST
Labor hours @
Josse Tayres 6" 3.75 \$22.50
Joseph Hlenso B" 3.32 19.92
NOV hear St. Programs 3.20 19.23 V
W/M. CONVEYO 6" 3.10 18.54
Robert Forsecal?" 3.29 19.75
Joseph Macodo " 3.60 21.68
Oliver, D 1 " 3.75 3.75 Howard, J 1 3.32 3.32
Howard, J 1 3.32 3.32 128.645
12 029 Coment @1.95 .98
100 165 Son de .12cwt .12
Repair 20 x 3. B. T. Street 233 to 62 10
an showing -
hev. #26Trucking Howard (-H) 3.00
ordson 35-3-HRS @6.55 - 19.65
Trk. #67-1-ttk. @3.00- 3.00-
omp. 35 - 1-16R, @3.35 - 3.35
Total Cost 2207J
Estimate-cost of laying drain 320 -
Entrance charges TO BE
Total deposit
Balance due 900 99 20
Pieces pipe to curb 2 /- loft /- 1 oft
" " curb to house 3) [-10 ft .]-1 oft . [-2]
Cut at sewer 7 2
Cut at curb
3 Size of pipe 6" T von S. to 42 feet
Correct
Lang W Jornes
Oreman