 
CITY OF NEW BEDFORD

APPLICATION FOR LAYING DRAIN

Application Nº 19413	Board of Health Permit No.
	New Bedford, Mass., May 3, 1972
To the Mayor and City Council: I hereby request that a drain be laid from th	e premises of Armand Lansaucy 350'e of Arwand Lansaucy
no Maslewood St	350'e of ausknet Cove.
961?	•
to connect with the sewer in the same to be laid in the street and the surface Works.	repaired as directed by the Commissioner of Public
I hereby agree to pay at the office of the Cit the manner specified, in excess of the deposit m the work.	y Treasurer all cost of performing the above work in ade herewith, within 10 days after the completion of
payment of the cost of performing the work do	t made with this application shall be applied to the ne, and that any excess of deposit over the cost shall
Witness & Bregant O	Property owner 1014 Cewey It. Address
	Property owner
	Address
Requires separate entrance	
for roof water	Address
Consent of Owr	ner of Private Drain
To the Mayor and City Council:	New Bedford, Mass.,
	ng with sewer in
	street.
	Owner
Estimate and D	eposit Requirement
	nissioner of Public Works,
My estimate of the cost of laying the drain of	described in the above application is
B.E.	4 171 (7)
Entrance charges	Total deposit required
	George A. Drightman
	Total deposit required Leoge A. Brightman Commissioner of Public Works 25
Certifico	ate of Issue
	Office of City Clerk,
The above application, accompanied by Cit	y Treasurer's receipt presented this day; whereupon
	and the Commissioner of Public Works notified of the
same.	Ollin M. Saughan City Glerk 3
Laid from main in street to iron pipe in property. Owner agrees to supply all necessary	



NOTICE TO COMMISSIONER OF PUBLIC WORKS

Length of drain 50	Reled 457 ? 2 @
Sewer depth	pipe system
Surf. drain	
Drain Permit Nº 19413	City of New Bedford,
To Commissioner of Public Works.	Office of City Clerk, May 3, 1972
Permission has this day been issued	to
Property owner	Agdress
By same	Address
to lay drain from the premises of	armand Sansoury
as Maplicood.	St. 350'e of austret Que.
to connect with the sewer in	apluod street.
Laid from main in street to iron pipe in propert Owner agrees to supply all necessary	
Scansell pip	e.

Requires separate entrance for sewage and roof water

Roll No. 21 RETURN OF FOREMAN Entered. Time. COST Labor hours @ 3.75 \$30.00 3.32 26.56 25.64 3.20 3.10 24.72 27.47 3.43 23.18 3.86 Nacod 3.60 Stock 99 (6 mont @1.95 .98 V 1@.12 cwt .12 Trucking 3-HRS-@6.55 19.65 @3.00 6.00 @3.35 Total Cost Estimate-cost of laying drain Entrance charges Total deposit Balance due Pieces pipe to cur curb to house Cut at sewer... Cut at curb. 3 Size of pipe 6 Correct Foreman