 
CITY OF NEW BEDFORD

APPLICATION FOR LAYING DRAIN

Application N. 19439	Board of Health Permit No.		
	New Bedford Mass., June 19, 1972.		
To the Mayor and City Council: I hereby request that a drain be laid f	from the promises of Second Freites		
r nereby request that a train be laid i	Tom the premises of the premis		
ws Summit St	60 nd lemaket It		
	$\gamma \gamma_{*} = 0.7$		
to connect with the sewer inthe same to be laid in the street and the Works.	surface repaired as directed by the Commissioner of Public		
I hereby agree to pay at the office of the manner specified, in excess of the dep the work.	the City Treasurer all cost of performing the above work in posit made herewith, within 10 days after the completion of		
It is understood and agreed that the payment of the cost of performing the wobe returned to me by the City Treasurer.	deposit made with this application shall be applied to the ork done, and that any excess of deposit over the cost shall		
Witness L. Bryant	Ansigh Freetras		
	Property owner		
V	235 Oummet St- Address		
B	y		
Requires separate entrance	Address		
for roof water	Address		
Consent of	Owner of Private Drain		
To the Mayor and City Council:	New Bedford, Mass.,		
I hereby grant to			
the privilege of draining premises			
through the private drain owned by me co	onnecting with sewer in		
	street		
	Owner		
Estimate a	and Deposit Requirement		
Office of	Commissioner of Public Works,		
My estimate of the cost of laying the	drain described in the above application is		
Assessed	Total density required 380,00		
Entrance charges	H // R /+		
	Total deposit required 380 00 Lough / Brightman Commissioner of Public Works		
Се	ertificate of Issue		
	Office of City Clerk,		
The above application, accompanied I	by City Treasurer's receipt presented this day; whereupor		
/ /	ssued, and the Commissioner of Public Works notified of the		
same.	Fll. m Annah		
MU.	Ellen M Laughe City Clerk		
Laid from main in street to iron pipe in property. Owner agrees to supply all necessary	INE		



NOTICE TO	COMMISSIONER OF PUBLIC WORKS
Length of drain 80' Sewer depth 6/2' Surf. drain 4	Billed \$9172 @ 2 pipe system
Drain Permit. Nº 19439	City of New Bedford, Office of City Clerk, June 19,1912
To Commissioner of Public Works. Permission has this day been is: Property owner Property owner	
to lay drain from the premises of	Joseph Freitas Jr 60'm of Nemaskit St
Laid from main in street to iron pipe in programmer agrees to supply all necessary	
Requires separate entrance for sewo	ige and roof water No storm drain connected

RETURN OF FOREMAN

-	RETURN	OF FOR	KEWAL	A Land
Enter	ed hely	3,		1972
Time	1 0 -	his.		
By	11 1	ine.		
Dy		COST		****************
Lal	oor	hours	@	
(neph ains	2, "	7 h	\$26.25
; All	neph Fer	reira	7 h	w 23.24
2	ose CRI	(Z."	Th	20.83
1000	William (orrein	a7h	w 23.24
Jos	rept macs	do	7 1	m 25.24
	/	"		\$118.80
§ Sto	ole			
310	1 0	+ @1	0.5	00
1/2	bog Cemer		12cwt	.98 /
100	10 40		LZCWG	.12 /
	3 of atrest	rost	411	A
TOK) OU MUNICIPA	-14	Management	5-4
Tru	ıcking			.
dison# 3		@6.55		26.20
Trk#		@3.00		3.00
mp. #5		@3.35		3.35
	al Cost			133145
Est	imate-cost of laying	g drain 3	80 -	
DE Ent	rance charges			
ESSED. Tot	al deposit			
Bal	ance due	tox		22755
Pio	ces pipe to curb	2 410 14	1-1 1	(
Tied,				
V	curb to n		DA	r door i
	at sewer 7			
Cut	at curb 6	ST.	. 4 6	
Size	e of pipe	Trans	ice. 7	6 feet.
Cor	rect		2	
	Joseph	h Re	il .	
	yesep	- Con	I	Foreman