 
CITY OF NEW BEDFORD

APPLICATION FOR LAYING DRAIN

Application Nº 19449	Board of Health Permit No.
	New Bedford, Mass., July 5, 1972
To the Mayor and City Council: I hereby request that a drain be laid from	
W. S. Harrard St.	so t= m. of fafters Il
to connect with the sewer in the same to be laid in the street and the surf Works.	face repaired as directed by the Commissioner of Public
I hereby agree to pay at the office of the the manner specified, in excess of the deposit the work.	City Treasurer all cost of performing the above work in made herewith, within 10 days after the completion of
payment of the cost of performing the work	posit made with this application shall be applied to the done, and that any excess of deposit over the cost shall
Witness S gayal &	Orene Lilva Property owner
	Address
Ву	
Requires separate entrance for roof water	Address
for roof water	Address
Consent of O	wner of Private Drain
consent of o	
To the Mayor and City Council:	New Bedford, Mass.,
I hereby grant to	
the privilege of draining premises	
through the private drain owned by me conne	ecting with sewer in
	street.
	Owner
Estimate and	Deposit Requirement
Office of Co	ommissioner of Public Works,
My estimate of the cost of laying the drai	AND STATE OF THE S
Try estimate of the cost of laying the draft	in described in the above application is
Assessed 257.00	Total deposit required 357.00
Entrance charges	Total deposit required
	Gommissioner of Public Works
Certif	ficate of Issue
	Office of City Clerk, July 5, 1972
The above application, accompanied by	City Treasurer's receipt presented this day; whereupon
Permit No. 19449 was issue	ed, and the Commissioner of Public Works notified of the
same.	
	Colon Mr. Gucken Sy.
Laid from main in street to iron pipe in property. Owner agrees to supply all necessary	City Clerk
Cleante pipe.	



NOTICE TO COMMISSION	ONER OF PUBLIC WORKS
Length of drain 33.	A 9/2 0
Surf. drain 7	p.pe system
Drain Permit Nº 19449 City of N	New Bedford,
To Commissioner of Public Works.	Office of City Clerk, July 5, 1972
Permission has this day been issued to	
- Irene Selva	1137 Victoria St.
Property owner By John Silva	Address
to lay drain from the premises of Steve	Address
W. S. Narvara Sl.	20 = n. cy Goffus Se
to connect with the sewer in Harvay	street.
Laid from main in street to iron pipe in property. Owner agrees to supply all necessary	(Colley M. Gaulen
transle pipe.	City Clerk
Requires separate entrance for sewage and roof w	/ater

RETURN OF FOREMAN

- 1 13		7 5	
Entered 9 9	19	15	- \
Time 3, P, M			
By Jose m Jord	2	0/	
COST			
Labor hours @			
Jesse (2000 6 " 3.75	\$2	2.50	
Joseph Alanso 3 " 3.32	2	23.24	1
5K Wm. Coviero 3" 3.32		23.24	~
JOSOPH (143 " 2.98		20.83	1
Toy Bark 6" 3.43	1 1	20.60	
Joseph Macodo7" 3.60		25.24	-
"	\$13	55.65	
Stock			1
15 bag (grant @1.95		. 98	1
100 / 65 Sanda.12		.12	-
Ryfoir 1513 graves			
@ 1.00 +5.	20	0-0	
Trucking		1	
ordson 0, 35 -3 - HRS @6.55		19.65	
J Int'1 67~ (-HR) @3.00		3.00	-
Compressors I - 1-HR, @3.35	1 940 6	3.35	bearing the same of the same o
Total Cost	183	275	
Estimate-cost of laying drain 257 -			
Entranco charges assessed.			
Total deposit	10.0		
Balance due Luly	19	25	
Pieces pipe to curb	/	- 5	ft
" " curb to house (3)	1	. /-	7/1
	(/	(/	77
Cut at sewer			
Cut at curb 10	1	13	1-
Size of pipe 4 7 6	UM	75 -	7/
Correct			
On The spe)		
Jose M. Johnson	Forem	nan	
	70.700		