
## CITY OF NEW BEDFORD

## APPLICATION FOR LAYING DRAIN

	Application Nº 19459	Board of Health Permit No.								
		New Bedford, Mass., July 20,1912								
	To the Mayor and City Council:  I hereby request that a drain be laid from the	premises of John Silva								
ادا	Harrard So westerly in Lag	thus St to w line Harwick								
101	surrara di									
	to connect with the sewer in Harrana	repaired as directed by the Commissioner of Public								
	I hereby agree to pay at the office of the City Treasurer all cost of performing the above work in the manner specified, in excess of the deposit made herewith, within 10 days after the completion of the work.  It is understood and agreed that the deposit made with this application shall be applied to the payment of the cost of performing the work done, and that any excess of deposit over the cost shall be returned to me by the City Treasurer.  Witness Tauline Treasurer.									
		Property owner								
		Address								
	Ву									
	Requires separate entrance for roof water	Address								
	Consent of Owner of Private Drain									
	To the Mayor and City Council:	New Bedford, Mass.,								
	I hereby grant to									
	through the private drain owned by me connecting with sewer in									
	through the private than owned by the connecting	street.								
		Stock								
		Owner								
		posit Requirement								
	Office of Commis	ssioner of Public Works, July 20, 1977								
	My estimate of the cost of laying the drain de	scribed in the above application is								
	4200.00									
	Assessed	Transit asserted								
	Entrance charges	Total deposit required								
		Commissioner of Public Works								
		Commissionly of Tubic Works								
	Certificat	e of Issue								
	NOTE (CONTROL OF CONTROL OF CONTR									
		Office of City Clerk, July 20, 1973								
		Treasurer's receipt presented this day; whereupon								
	,	nd the Commissioner of Public Works notified of the								
	same.	Ellen B Laughan								
41	w. line in haltus lx	- City Clerk								
6	Laid from main in street to non pipe in property.  Owner agrees to supply all necessary	Con								
	Transite pipe.									
	Lay pipes to a point en "	v. w. sedewalk cor Howard and								

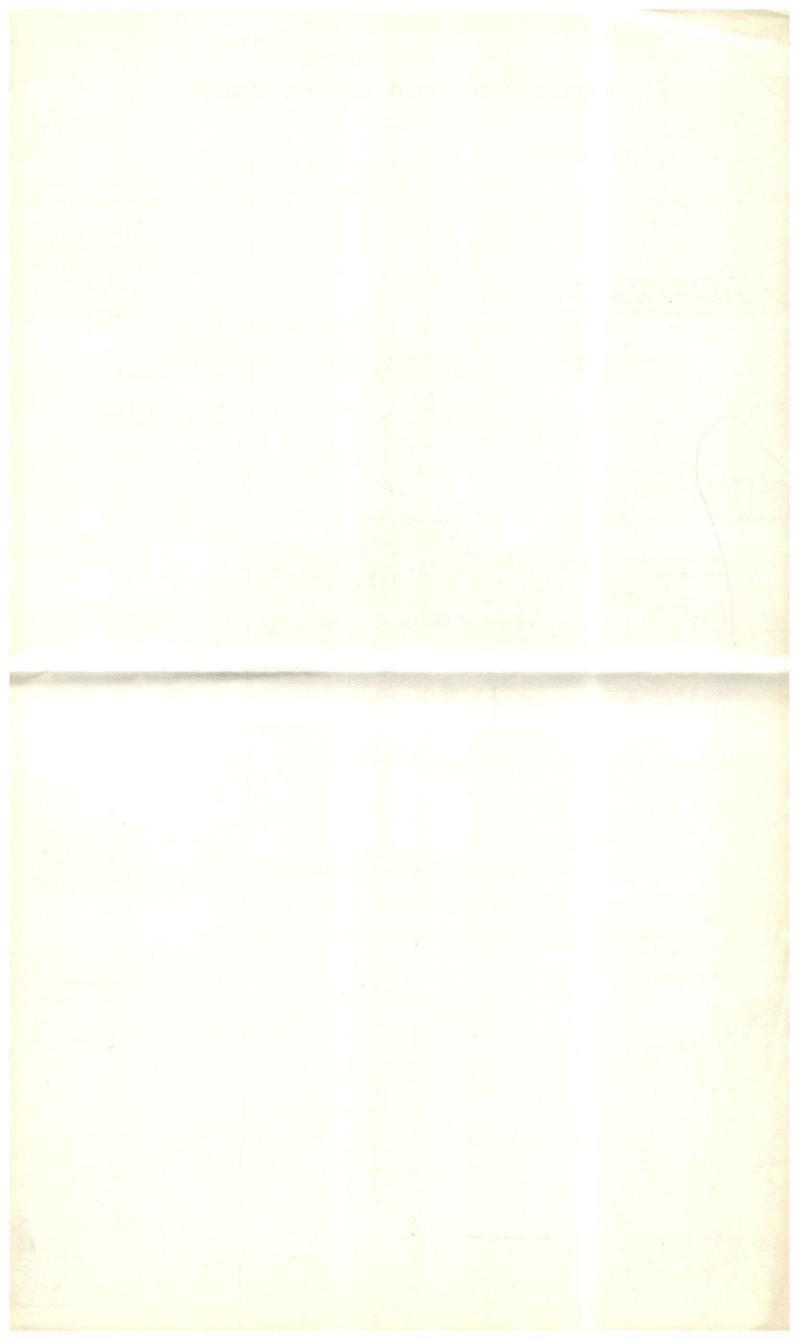

NOTICE TO COMMISSIONER OF PUBLIC WORKS Length of drain 26 Sewer depth /5 /2 / /5 pipe system Surf. drain 6 /2 ' City of New Bedford, Office of City Clerk,..... To Commissioner of Public Works. Permission has this day been issued to Property owner Address to lay drain from the premises of Laid from main in street to iron pipe in p Owner agrees to supply all necessary tv Clerk.

Roll N	10. 31								
		RETUI	RN O	FF	ORE	MAN	1		
E	Intered	Ju	14	2	5		19	72	
Г	ime	4. P.	M'.						
В	y	Dess	e M	T	011	nes	• • • • • • • • • • • • • • • • • • • •		
		1	C	OST					
	Labor hours @								
7	255-6	Tarr	nos	7	,	3.75	\$2	6.25	/
Ja	sepl	13/5	onsa	7	,	3.32	2	3.24	/
North	no si	, Prie	100	1	,	3.20		2.44	
to	m.C	onie	20	1	,	3.10		21.62	
R	sport	5 ms	eca.	7	,	3.29	2	3.04	
	sepl	n Ma	cod	Q1	,	3.60	1	5.24	-
	iver,	D.	_	4	,	3.75	91	3.28	/
no 17	ward,	0.			> F		\$1	0.11	
1/2	I bag	7 (on	lucy	@1.9		=		.98	1
1173/5	001	62	Nes		2.12	CWt	( 5		94-16
Food J	rav	2011	roa	4	150	1.47	"id	500	
Strac.	e(2)/	377)	(12	F	Re	5	01	- E17	AC I
r_	Truckir	26 41	7	tox	2.	- Cara	.21	57.	40 1
0 1	to C	7 1	TRS	-	<b>26.</b> 5	5.5		19.65	/
The state of the s	35	3-7	HO		23.0			3.00	/
Tok.	ev. #2	26 - 1	hr.	-	3.0			3.00	1
ラスア	Total C		o sledesko (S)	. «			27	-	/
n 601-		e-cost of	laving	drain	120	0-	di	1,9	
3: -		e charge		dram	100				
end -	Total d		<b>A</b>						,
0 -	Balance		du		11		74	32	
=			M	1-	12	1+		-	
welk	Pieces 1	pipe to c	urb/		4	1	- 1	,	
MEIL	"	pipe to c	to hou	1se1.	)1	- /	3-1	t,	
	Cut at	sewer/	I,f	X 1	,				
	Cut at	curb/	10	P					
	Size of	pipe.	4	15	L	7 00	ms	. 10	, ,,
	Correct								
		1		7	~~			(	
1		Jowa iver	re.	10	0.5.2	]	Forem	an /	1
Joh.	n to	10000	id	H	RS	. 21	nol	814	G
Do	01	iver		0		Jul	- f	light	700