
CITY OF NEW BEDFORD

APPLICATION FOR LAYING DRAIN

Application Nº 19463	Board of Health Permit No.	
	New Bedford, Mass., July 26, 1972	
To the Mayor and City Council: I hereby request that a drain be laid fro	m the premises of Novelty Homes	
N. S. Stevenson SB	- 50'+ E of miston and	
	0	
to connect with the sewer inthe same to be laid in the street and the su Works.	Street, urface repaired as directed by the Commissioner of Public	
I hereby agree to pay at the office of the the manner specified, in excess of the depos the work.	e City Treasurer all cost of performing the above work in sit made herewith, within 10 days after the completion of	
It is understood and agreed that the d payment of the cost of performing the work be returned to me by the City Treasurer.	eposit made with this application shall be applied to the c done, and that any excess of deposit over the cost shall	
Witness Ruline Mourass	Monetty Domes Property owner	
<i>[.a.</i>	28 Hathaway Rd 20 Dard Mass.	
By	Wantly Jimseline	
Requires separate entrance for roof water	28 for laway of Nord & Tellmith	
Comment	Decree of Discrete Deci-	
Consent of Owner of Private Drain		
To the Mayor and City Council:	New Bedford, Mass.,	
I hereby grant to		
the privilege of draining premises		
through the private drain owned by me connecting with sewer in		
	street.	
	Owner	
	Owner	
Estimate and Deposit Requirement		
Office of Commissioner of Public Works, July 26, 1977		
My estimate of the cost of laying the drain described in the above application is		
339,00	**	
Assessed Assessed	Total deposit required 339.00	
Environment of the second of t		
	Lorge W Justinan Commissioner of Public Works Jan	
Cort	rificate of Issue	
Cert	Office of City Clerk, July 26, 1972	
	City Treasurer's receipt presented this day; whereupon	
	ned, and the Commissioner of Public Works notified of the	
same.	Elin M. Snighan City Clerk po	
Laid from main in street to iron pipe in property.	City Clerk John	
Owner agrees to supply all necessary Jansete pipe.		
areand		

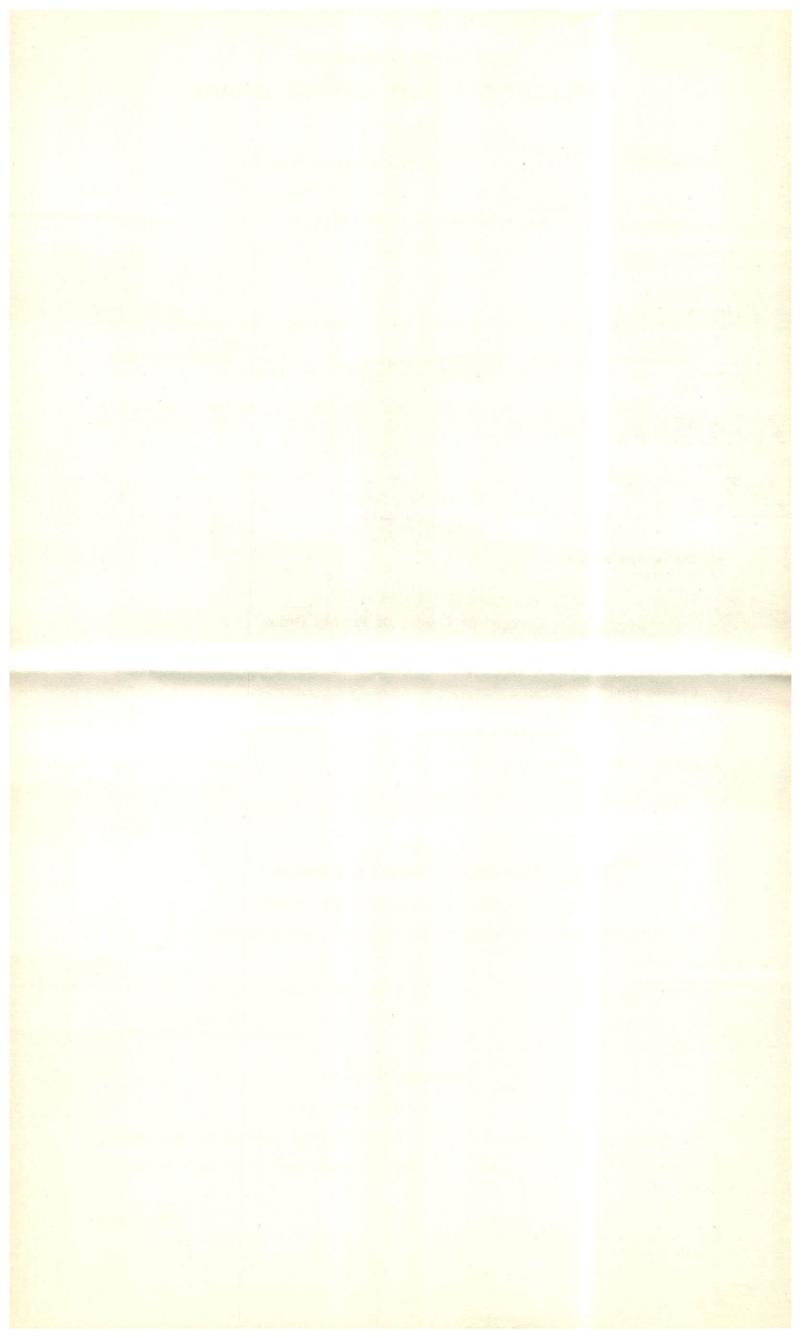

NOTICE TO COMMISSIONER OF PUBLIC WORKS

Length of drain 50	Lilest 9/21/2200
Sewer depth7	pipe system
Surf. drain 5	
Drain Permit Nº 19463	City of New Bedford,
To Commissioner of Public Works.	Office of City Clerk, July 26, 1918
Permission has this day been issued	128 Hathaway Rd - M.D. Mass.
By Renneth Umeed	Address a same
to lay drain from the premises of Mon	Address Sty I was on the
to connect with the sewer in	Stevenson MONTON AW, street.
Laid from medi in street to iron pipe in property	y. Elen M. Yaughan City Clerkon
Sulant) pir	e.

Requires separate entrance for sewage and roof water

assessed

4696 Entered. Time. Labor hours @ 3.75 \$33.75 3.32 29.88 3.20 28.85 3.10 27.82 3.43 30.90 3.60 32.44 3.32 3.32 \$186.96 Stock .98/ .12 Trucking ordson Total Cost Estimate-cost of laying drain ||339 Entrance charges Total deposit Balance due Pieces pipe to curb curb to house 5 Cut at sewer 7.5 Cut at curb ... >-Size of pipe 4 " Correct