 
CITY OF NEW BEDFORD

APPLICATION FOR LAYING DRAIN

Application N. 19491	Board of Health Permit No.
	New Bedford, Mass., 11/7/72
To the Mayor and City Council: I hereby request that a drain be laid from the	e premises of I Sidl
Tosbarough Si	D, 50 - 0 4
To a do	and ale
to connect with the sewer in	repaired as directed by the Commissioner of Public
I hereby agree to pay at the office of the Cit the manner specified, in excess of the deposit me the work.	y Treasurer all cost of performing the above work in ade herewith, within 10 days after the completion of
payment of the cost of performing the work dor be returned to me by the City Treasurer.	t made with this application shall be applied to the ne, and that any excess of deposit over the cost shall
Witness 6- Sua Delos	Jul 9 3
Witness	Property owner
	to Foxborough S
Ву	
Requires separate entrance for roof water	Address
Consent of Owner of Private Drain	
	New Bedford, Mass.,
To the Mayor and City Council:	
I hereby grant to	
the privilege of draining premises	
through the private drain owned by me connecti	ng with sewer in
	street.
	Owner
	Owner
Estimate and Deposit Requirement	
Office of Commissioner of Public Works, (1/7/72)	
My estimate of the cost of laying the drain of	lescribed in the above application is
Assessed	21/6m)
Entrance charges	Total deposit required
	George H. Brightman
	Commissioner of Public Works
Cortifica	ite of Issue
Cermico	
	Office of City Clerk, // /7 /72
The above application, accompanied by City Treasurer's receipt presented this day; whereupon	
Permit No. 1944 was issued,	and the Commissioner of Public Works notified of the
same.	Celen M. Laughan
	City Clerk
Laid from main in street to iron pipe in property. Les	e Historia
Owner agrees to supply all necessary	
pipe.	
to be assessed.	
Ju Ju wow of	



	NOTICE TO COMMISSIONER OF PUBLIC WORKS
	Length of drain 28 Filled 19/73 B
	Sewer depth pipe system
	Surf. drain
	Drain Permit Nº 19491 City of New Bedford, Office of City Clerk,
	To Commissioner of Public Works. Permission has this day been issued to Property owner Once of City Clerk, Once of City Clerk, Address
	By Address /
	to lay drain from the premises of Escle Hollorough St., 50 ± S of Splow Street
	to connect with the sewer in Haflarough street.
	Laid from main in street to item pipe of property. line Owner agrees to supply all necessary City Clerk.
1/	pipe.
	Requires separate entrance for sewage and roof water
	to be assessed

RETURN OF FOREMAN 2 hrs.@4.12 Francisco, Labor hours @ 3.75 3.10 3.32 3.32 3.60 3,86 3.75 3.32 ant@1.95 @.12 cwt Trucking 26.20 Total Cost Estimate-cost of laying drain Entrance charges Total deposit Balance due Pieces pipe to curb(2) curb to house Cut at sewer () Cut at curb...? Size of pipe 4 Correct

Dangerous + wat Condition

Foreman