

CITY OF NEW BEDFORD
APPLICATION FOR LAYING DRAIN

Application **Nº 19493**

Board of Health Permit No. _____

New Bedford, Mass., 11/7/72

To the Mayor and City Council:

I hereby request that a drain be laid from the premises of W. Side Mac Arthur

Drive 65' ± S of South Street

to connect with the sewer in Mac Arthur Drive street,
the same to be laid in the street and the surface repaired as directed by the Commissioner of Public Works.

I hereby agree to pay at the office of the City Treasurer all cost of performing the above work in the manner specified, in excess of the deposit made herewith, within 10 days after the completion of the work.

It is understood and agreed that the deposit made with this application shall be applied to the payment of the cost of performing the work done, and that any excess of deposit over the cost shall be returned to me by the City Treasurer.

Witness

E. J. Queros

Antone M. M. M.

Property owner

130 S. Lenox St. Fairhaven

Address

By _____

Requires separate entrance
for roof water

Address

~~Consent of Owner of Private Drain~~

~~New Bedford, Mass., _____~~

~~To the Mayor and City Council:~~

~~I hereby grant to _____~~

~~the privilege of draining premises _____~~

~~through the private drain owned by me connecting with sewer in _____~~

~~street.~~

~~Owner~~

Estimate and Deposit Requirement

Office of Commissioner of Public Works, 11/7/72

My estimate of the cost of laying the drain described in the above application is

15.00

Assessed

Entrance charges _____

Total deposit required 15.00

George H. Brighton
Commissioner of Public Works

Certificate of Issue

Office of City Clerk, 11/7/72

The above application, accompanied by City Treasurer's receipt presented this day; whereupon

Permit No. 19493 was issued, and the Commissioner of Public Works notified of the same.

Eileen M. Goughan
City Clerk

Laid from main in street to iron pipe in property.
Owner agrees to supply all necessary

pipe.

Inspection & location sketch only - Connection made by Contractor.

AND TO DRAIN

STREET

10" sewer

24" sur. dr.

50' H 5'

21"

12" sewer

30" sur. dr.

MACADAM

TO EXISTING
SEWER

19493-72


ACE AUTO
BODY
INC.

DRAINS IN THIS LOCALE

PERMIT

12/5/11

CH

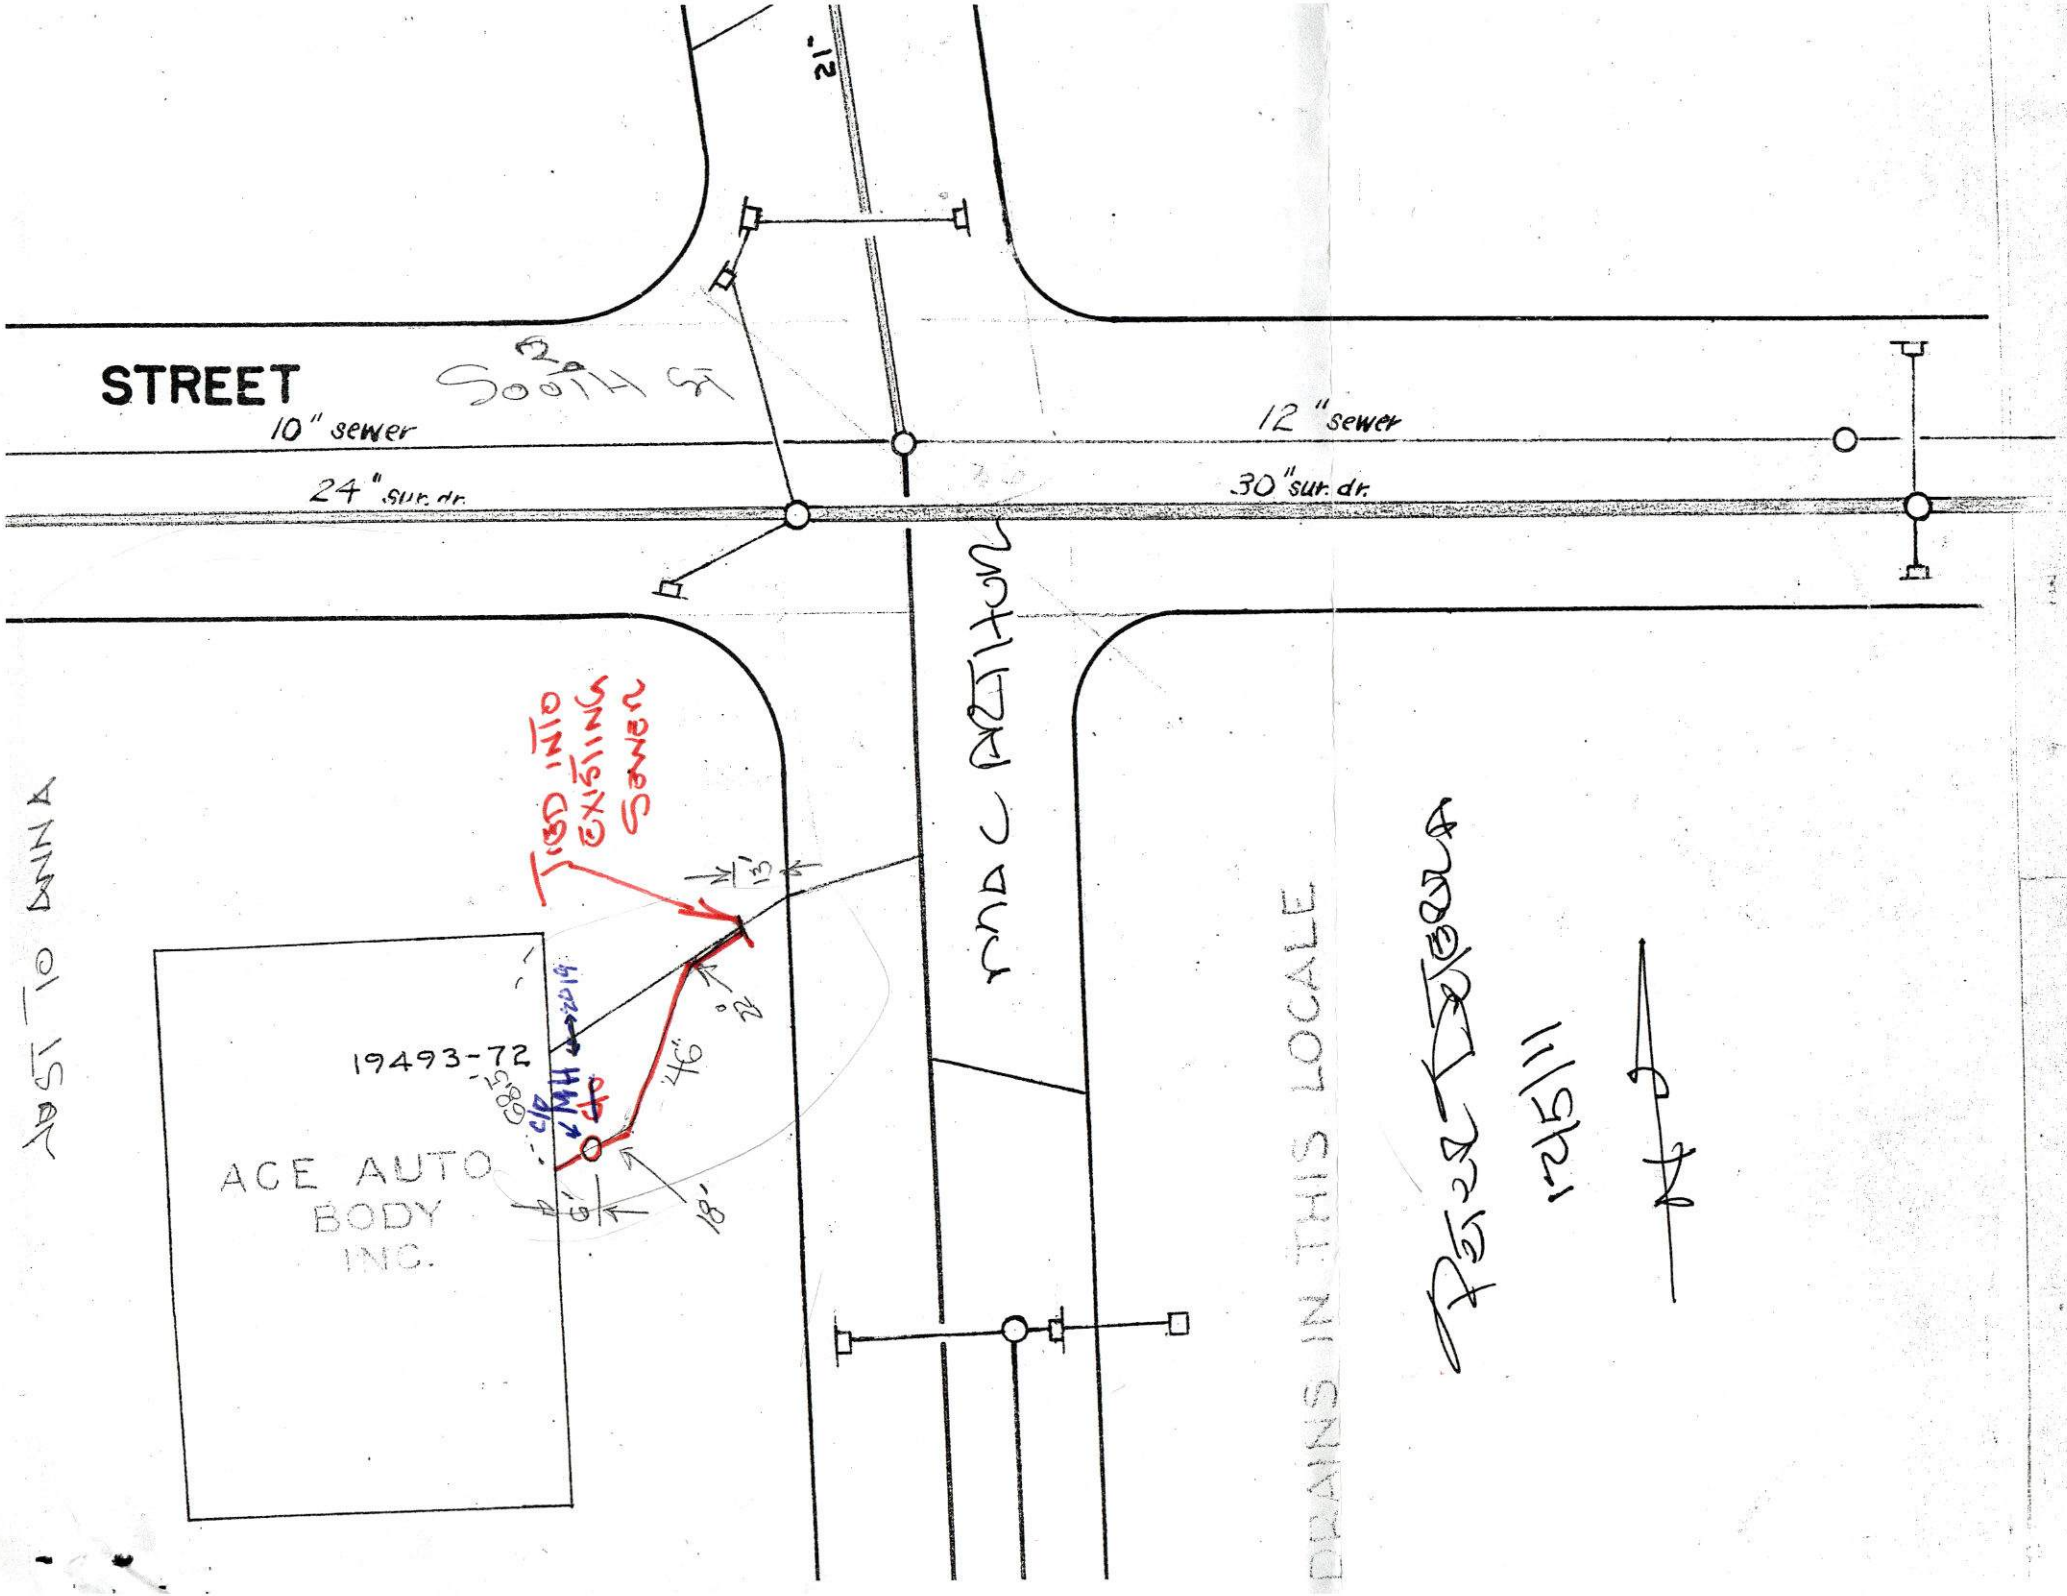

NOTICE TO COMMISSIONER OF PUBLIC WORKS

46

Length of drain.....

Sewer depth.....

Surf. drain.....

filed 7/14/72 @

..... 2 pipe system

Drain Permit **Nº 19493**

City of New Bedford,

Office of City Clerk,

11/7/72

To Commissioner of Public Works.

Permission has this day been issued to

Dee Auto Body

Property owner

35 Hullman Street

Address

By Martin Constr. Co., 151 Scotticut Neck Rd., Fairhaven

Address

to lay drain from the premises of W. Side Mac Arthur Drive 65' ±

S of South Street

to connect with the sewer in Mac Arthur Drive street.

Laid from main in street to iron pipe in property.

Owner agrees to supply all necessary

Ellen M. Gaughan

City Clerk.

..... pipe.

Requires separate entrance for sewage and roof water

Inspection and Location sketch only - connections

RETURN OF FOREMAN

Entered NOV 9 19 22

Time

By Joseph C. Thibault
COST

Labor	hours	@	
Thibault, J. -	1	"	3.75
Travers, D. -	1	"	3.43
		"	7.18
		"	
		"	
		"	
		"	
Stock			
<u>INSPEC. ONLY</u>			
Trucking #25 - - - - -			3.00
Total Cost			\$10.18
Estimate-cost of laying drain	15	00	
Entrance charges			
Total deposit			
Balance due			

Pieces pipe to curb

" " curb to house

Cut at sewer

Cut at curb

Size of pipe

Correct

Joseph C. Thibault
Foreman

6/15/23
Tax charge. (23)