
## CITY OF NEW BEDFORD

## APPLICATION FOR LAYING DRAIN

Application Nº 19534	Board of Health Permit No.
	New Bedford, Mass. 1-3-73
To the Mayor and City Council:  I hereby request that a drain be lated to the second t	id from the premises of E side Ithullow
0	<i></i>
to connect with the sewer in the same to be laid in the street and tworks.	the surface repaired as directed by the Commissioner of Public
the work.	deposit made herewith, within 10 days after the completion of
payment of the cost of performing the	work done, and that any excess of deposit over the cost shall
Witness	Daula Portra
	Property owner
	Address A
	By feter fly Plunter
Requires separate entrance for roof water	1843 Cost Address
Consent	of Owner of Private Drain
To the Mayor and City Council:	New Bedford, Mass.,
	connecting with sewer in
	street.
	Owner
Estimate	and Deposit Requirement
My estimate of the cost of laying th	e drain described in the above application is
Assessed	197 10
Entrance charges	Total deposit required
	Commissioner of Public Works
	Certificate of Issue
	Office of City Clerk. 1-3-13
The above application, accompanied	by City Treasurer's receipt presented this day; whereupon
Permit No. 19534 was same.	s issued, and the Commissioner of Public Works notified of the
To connect with the sewer in Abbut 1000 to connect work.  It is understood and agreed that the deposit made with this application shall be application to the cost of performing the work done, and that any excess of deposit over the returned to me by the City Treasurer.  Witness  Consent of Owner of Private Drain  To the Mayor and City Council:  I hereby grant to the private drain owned by me connecting with sewer in the private drain owned by me connecting with sewer in Commissioner of Public Works.  My estimate of the cost of laying the drain described in the above application is Assessed Entrance charges  Certificate of Issue  Office of City Clerk,  The above application, accompanied by City Treasurer's receipt presented this day; we remit No.  Was issued, and the Commissioner of Public Works notifice was incommissioner of Public Works notificed to the commissioner of Public Works no	
/Viantitle pipe	

I be assessed no storm connection regid. E.T.

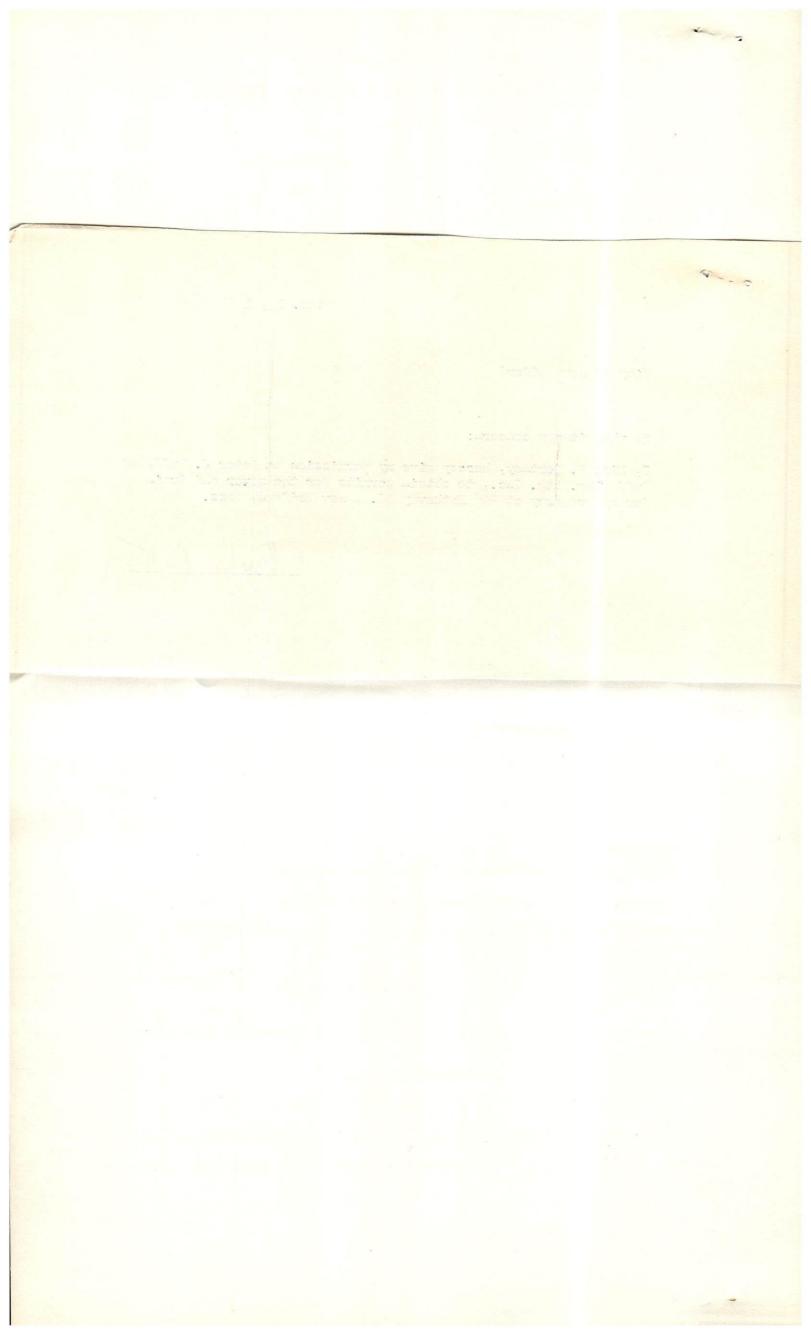


City of New Bedford

To whom it may concern:

I, Miss P. Portney, hereby give my permission to Peter J. Duff, of Duff Plbg. Rtg. Inc., to obtain permits for the sewer and drain for my property at 296 Mathaway Rd., New Bedford, Mass.

Paula Portury

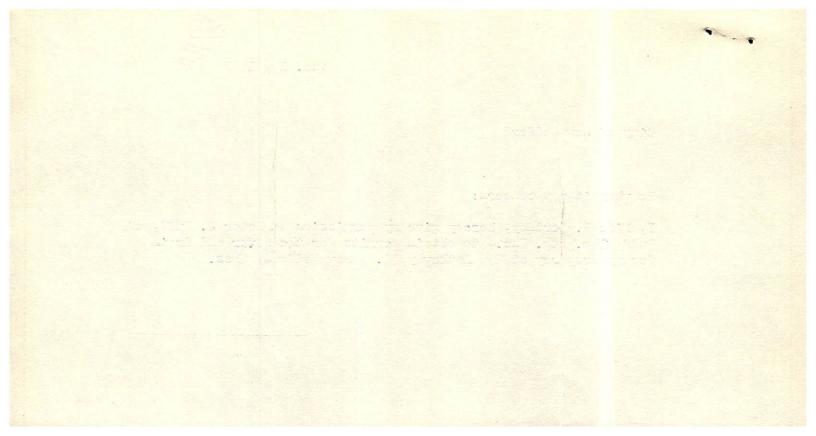

NOTICE TO COMMISSIONER OF PUBLIC WORKS	
Length of drain 28 Rilled 7, 2/73 @	
Sewer depth pipe system	
Surf. drain	
Drain Permit Nº 19534 City of New Bedford,	
To Commissioner of Public Works.  Permission has this day been issued to faula farlingy  Property owner  Office of City Clerk, 1-3-73  Address  Office of City Clerk, 1-3-73  Address	2.
by to lay drain from the premises of F side Whitlow St. 60 +	
to connect with the sewer in Whitlow, street.	
Laid from main in street to iron pipe in property. Leve Colon M. Gaughan  Owner agrees to supply all necessary  Verensete pipe.  City Clerk.	
Requires separate entrance for sewage and roof water	
To be assessed - no starm connection reg'd EJ.T.	

## RETURN OF FOREMAN

Entered JAN	1 3,			10	73		
	-, P.M.		••••••	19	10		
By JOSEPH 1			*********	******			
Бу.С.С.Т.	COST	**********					
Labor	ho	urs @					
JOSEPH PI	VE.	" 7.6	375	26	25		
	LOR	" 17.0	332	23	24	V	
	KEIKA	" 7.0	332	23	24	-	
ROD BRAGA	0	" 7.C	360	25	24		
Shoring Don OLIVE	K	"20	375	7	50	1	
JOHN HOWA	IDV.	" 2(2)	332	6	64	1	
HAMUW, Tho.	mos -	"100	343	3	43	_	
1	- 1		-			1	
12 BAG CE			2-		.98	1	
1000 1BS. St		7	-	11		-	T
13×3 BLACK TOF	STREE	The second second		70	000	00	2
D'Grano Squar	la says	@14.	LK	49	78	1	0
Trucking	177	611-		8 4	10	-	2
Multie-hoe #65	- 3, H.R	5.06.	55	19	65	/	7
Compress. # 47-	- I. H.R.	@3.	35	3	.35	V.	0
Trk. # 40-	1- H.R.	@3.		3.	.00	/	Cupai
Total Cost			70	23	4.4	7	V
Estimate-cost of la	aying drain	1177-		192,	42	1	3
Entrance charges							NEW
Total deposit			1	15.	42		3
Balance due	5			57	47		1
Pieces pipe to cur	rb (1)-1-1	D-FT-	1-3F	T.			
" " curb	to house	1-1-101	FT-1-	-bF	F		
Cut at sewer				0,.			
Cut at curb							
Size of pipe 6.	TRAC	TE.					
			******				
Correct							
JOSE	Ph Pin	IE,	*******				
			F	orem	an	100	F
					- 10	1 1 -	