

CITY OF NEW BEDFORD
APPLICATION FOR LAYING DRAIN

Application **N^o 19536**

Board of Health Permit No.

To the Mayor and City Council:

New Bedford, Mass., 12/28/72

I hereby request that a drain be laid from the premises of W.S. Church

Street across from Sharon St

to connect with the sewer in Church street,
the same to be laid in the street and the surface repaired as directed by the Commissioner of Public Works.

I hereby agree to pay at the office of the City Treasurer all cost of performing the above work in the manner specified, in excess of the deposit made herewith, within 10 days after the completion of the work.

It is understood and agreed that the deposit made with this application shall be applied to the payment of the cost of performing the work done, and that any excess of deposit over the cost shall be returned to me by the City Treasurer.

Witness E. Quadros

J. Bhea Bryant
Property owner
1225 Church St.
Address

By

Requires separate entrance
for roof water

Address

Consent of Owner of Private Drain

New Bedford, Mass.,

To the Mayor and City Council:

I hereby grant to
the privilege of draining premises

through the private drain owned by me connecting with sewer in
street.

Owner

Estimate and Deposit Requirement

Office of Commissioner of Public Works, 12/28/72

My estimate of the cost of laying the drain described in the above application is

191.00

Assessed
Entrance charges

Total deposit required 191.00
George H. Brightman
Commissioner of Public Works


Certificate of Issue

Office of City Clerk, 12/28/72

The above application, accompanied by City Treasurer's receipt presented this day; whereupon
Permit No. 19536 was issued, and the Commissioner of Public Works notified of the same.

Elen M. Laughan
City Clerk

✓ Laid from main in street to ~~iron pipe in~~ property line
Owner agrees to supply all necessary
transite pipe.

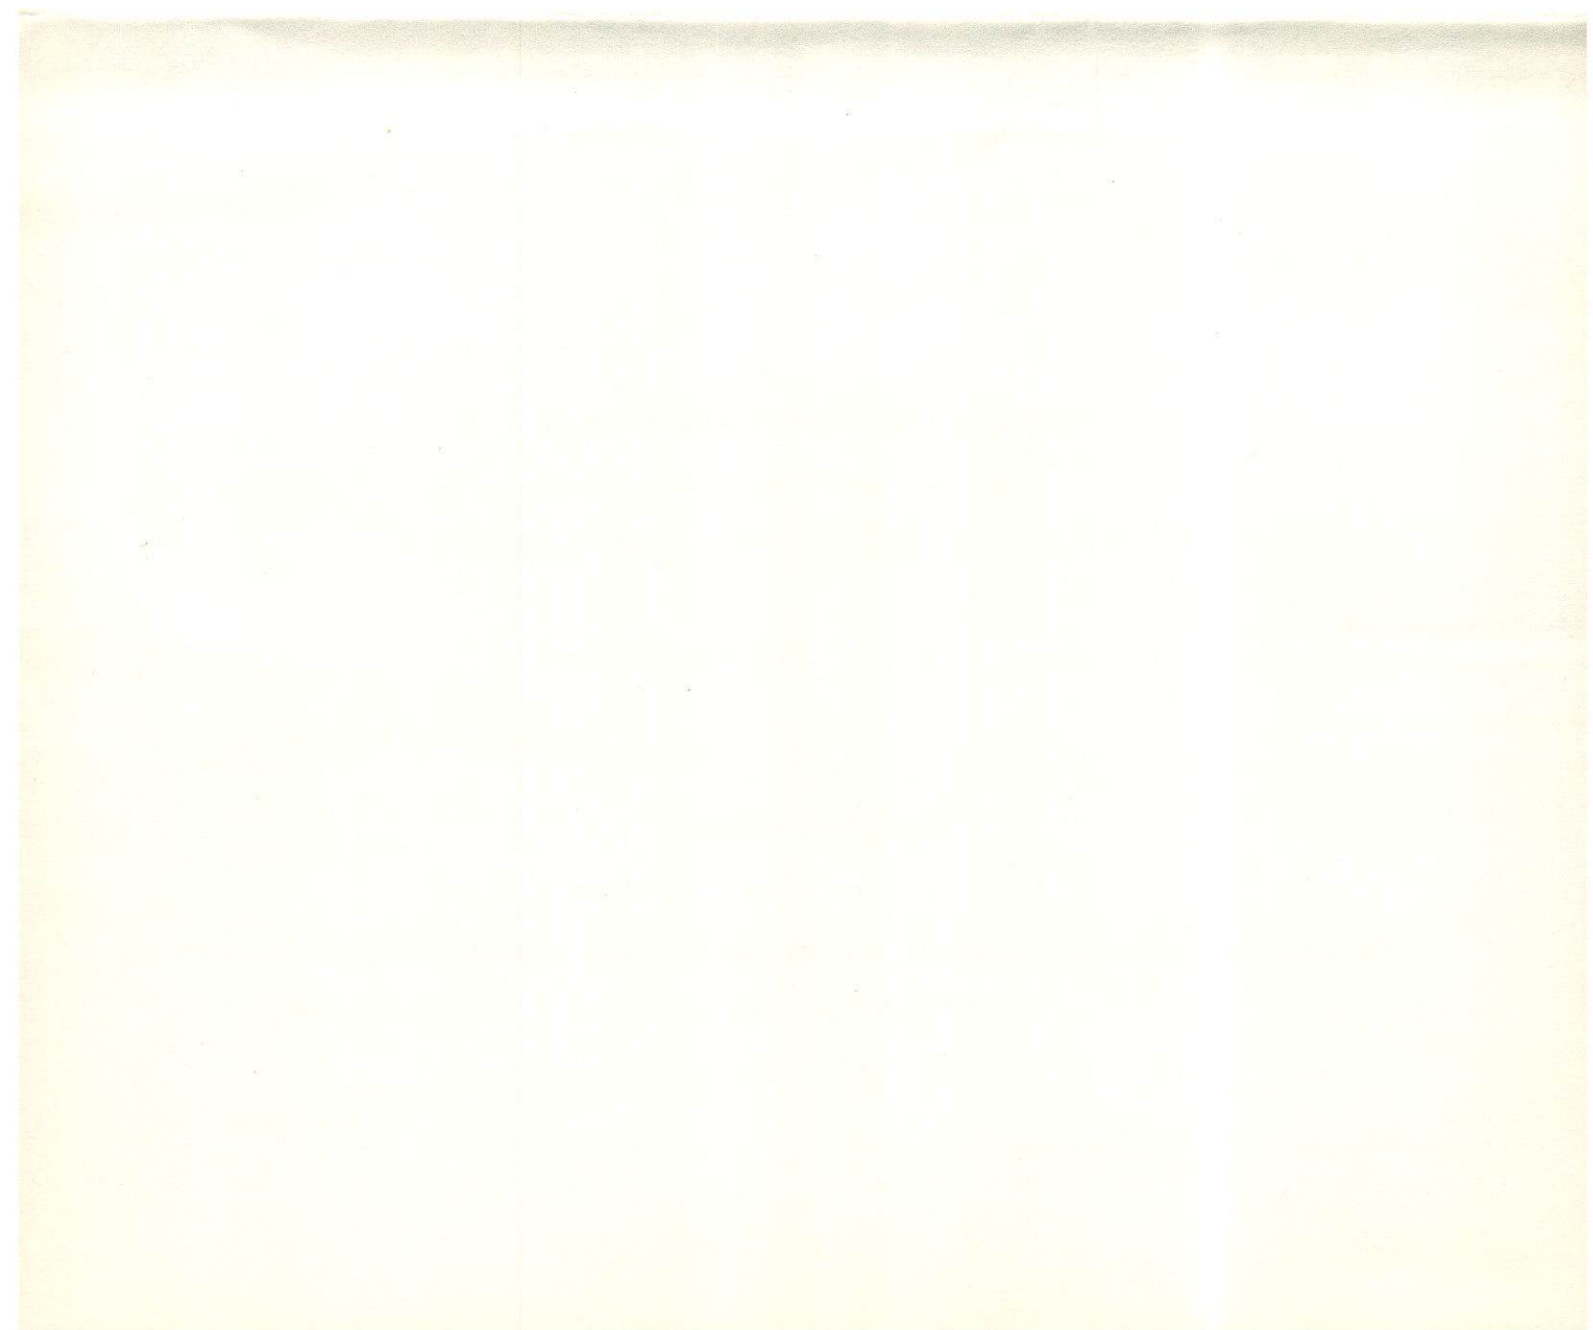

NOTICE TO COMMISSIONER OF PUBLIC WORKS

Length of drain.....23.....

Sewer depth.....7 1/2.....

Surf. drain.....

Billed 2/13/73

.....1.....pipe system

Drain Permit **N^o 19536**

City of New Bedford,

Office of City Clerk,.....12/28/72.....

To Commissioner of Public Works.

Permission has this day been issued to

Mrs Shea Payant
Property owner

1225 Church Street
Address

By.....

to lay drain from the premises of W. S. Church Street
Address

to connect with the sewer in Church street.

✓ Laid from main in street to ~~iron pipe in~~ line property.
Owner agrees to supply all necessary transite pipe.
Eelen M Gaughan
City Clerk.

Requires separate entrance for sewage and roof water

fl

(2)

RETURN OF FOREMAN

Entered Jan. 2 19 73
 Time 4 P.M.
 By Jesse M. Torres

COST

Labor	hours @	
Jesse Torres 8"	3.75	\$30.00 ✓
X. Wm. Corriero 8"	3.32	26.56 ✓
KN Robert & T. Pierno 8"	3.32	26.56 ✓
Frank Fersiero 8"	3.10	24.72 ✓
Tom Burk 8"	3.43	27.47 ✓
Joseph Macedo 8"	3.60	28.84 ✓
"		\$164.15 → 17:
Stock		<u>163.90</u> ←
1/2 bag Cement @1.95-		.98 ✓
100 lbs Sand @ .12cwt		.12 ✓
Repair 20x3 B.T. Street		
@ 2.15' + 1'		<u>62.00 out</u>
Trucking		
ordson #35-3-HRS @6.55-		19.65 ✓
nt. Trk. 67-1-HR. @3.00-		3.00 ✓
Comp. 52-1-HR. @3.35-		3.35 ✓
Total Cost		<u>253.25</u>
Estimate-cost of laying drain	191-	191.00
Entrance charges		
Total deposit		<u>25</u>
Balance due City		<u>62.25</u>

Pieces pipe to curb 2-10 ft. Pieces
 " " curb to house 1-Ten foot Piece
 Cut at sewer 7 1/2'
 Cut at curb 6 1/2'
 Size of pipe 6" Transit
 Correct

Jesse M. Torres
 Foreman

Some Lod 94

2/9/73
3/1/73

owner supplied
 p. 2