 
## CITY OF NEW BEDFORD

## APPLICATION FOR LAYING DRAIN

Application Nº 19555 PUM	1717
Application	Board of Health Permit No.
13/21	1/11
To the Mayor and City Council:	New Bedford, Mass., 3/13/19
I hereby request that a drain be la	id, from the premises of N Sede of
Vientana Sure	1 IV of Burtlett Street
	V
to connect with the sewer in July	tland street.
Works.	the surface repaired as directed by the Commissioner of Public
the manner specified, in excess of the the work.	of the City Treasurer all cost of performing the above work in deposit made herewith, within 10 days after the completion of
payment of the cost of performing the be returned to me by the City Treasur	
Witness Luadry	I Charle 7 Medeiro
	Property owner
	Address
	By 919 Westland of T
Requires separate entrance for roof water	Rew Befford.
Consent	of Owner of Private Drain
To the Mayor and City Council:	New Bedford, Mass.,
I hereby grant to	, )
the privilege of draining premises	
through the private drain owned by m	e connecting with sewer in
anough the private drain owned by in	street.
	Owner
F. 12.	
Estimate	e and Deposit Requirement
Office	e of Commissioner of Public Works, 5/15/
My estimate of the cost of laying the	he drain described in the above application is
Assessed	he drain described in the above application is
426.00	he drain described in the above application is
Assessed	Total deposit required Longithman
Assessed	he drain described in the above application is
Assessed	Total deposit required Longithman
Assessed	Total deposit required 426-00  Commissioner of Public Works  2/4/20
Assessed Entrance charges	Total deposit required 426-00  Lewy Degletness  Commissioner of Public Works
Assessed Entrance charges  The above application, accompanies	Total deposit required 426 Commissioner of Public Works  Commissioner of Public Works  Commissioner of City Clerk,  Cod by City Treasurer's receipt presented this day; whereupon
Assessed Entrance charges  The above application, accompanies	Total deposit required 426 or Commissioner of Public Works of Office of City Clerk,
Assessed Entrance charges  The above application, accompanies Permit No. 19555 was same.	Total deposit required 426 or Commissioner of Public Works of the Digital Works of State of City Clerk, State of the Commissioner of Public Works notified of the Clerk Management of Public Works notified of the Clerk Notified of the Clerk Notified Notif
Assessed Entrance charges  The above application, accompanies Permit No. 19555 was	Total deposit required 426.00  Commissioner of Public Works  Coffice of City Clerk,  as issued, and the Commissioner of Public Works notified of the  Clerk Many of City Clerk  City Clerk  City Clerk
Assessed Entrance charges  The above application, accompanies Permit No. 19555 was same.	Total deposit required 426-00  Learge A Brightman Commissioner of Public Works  Commissioner of Public Works  as issued, and the Commissioner of Public Works notified of the  Cless M Laughan  City Clerk  City Clerk
Assessed Entrance charges  The above application, accompanies Permit No. 19555 was same.  Laid from main in street to iron pipe in propert Owner agrees to supply all necessary	Total deposit required 426 or Sugarthum Commissioner of Public Works of Deposit of Certificate of Issue  Office of City Clerk,  ed by City Treasurer's receipt presented this day; whereupon as issued, and the Commissioner of Public Works notified of the Celen M. Saughan  Ellen M. Saughan  City Clerk  Section



TO COMMISSIONER OF PUBLIC WORKS Length of drain Sewer depth Surf. drain City of New Bedford, Office of City Clerk, To Commissioner of Public Works. Rermission has this day been issued to Property owner to lay drain from the premises of to connect with the sewer in .... Laid from main in street to iron pipe in property live.

Owner agrees to supply all necessary pipe. Requires separate entrance for sewage and roof water Enter M. H. @ Bartlett St Ongo from M Camacho

## RETURN OF FOREMAN

Entered Moles 2	1		0 -7 /
	<i>[</i>	1	9 3/
Time 3, R, M,	······································		
By Wellson	1 70	vov	
CO	OST		
Labor	hours @		
Jesse Tours	6"	3.75	22.50
Joseph Alfonso	£ "	3.32	19.92 -
Norbest ST. Pierre	6"	3.32	19.92
Wm. Coniero	6"	3.10	18.54
TOM BUTKY	6 "	3.43	20,60 4
Joseph Macado	7 "	3.75	3.75
Oliver, D Stock	<u> </u>		126.86
1 1 1 5	# 02 01		-
1500g Comer	(@1.98	3cwt	98/
100/bs Sans	B 100	12	451.05
The same of the sa		in	7272
(1-HR. Showing Don	Oliver		<del>                                     </del>
Trucking Chev.#25	- 1 hr.	_	3.00
#135-3-HRS,			19.65
116-1-HR1			3,00
52-1-HR.	@3.35-		3.35 /
Total Cost			199,00
Estimate-cost of laying d	Irain H26	-	
9 Entrance charges	8		
Total deposit			
Balance due Trutus	ne	2	27.00
Pieces pipe to curb	3-10-	4. 10	nsths
" curb to hou	Carlo V	1 1	
Cut at sewer & 5		000-	12-1
Cut at curb	1.	*******	
Cut at curb 7 5	6117	vonsi	+ 2
Correct			~
1	4		
Jack M.	Joven	Fore	eman
n 1 1011 50	-1	0	as MH