

CITY OF NEW BEDFORD  
APPLICATION FOR LAYING DRAIN

Application **Nº 19556**

Board of Health Permit No. ....

To the Mayor and City Council:

New Bedford, Mass., 4/3/73

I hereby request that a drain be laid from the premises of N.S. Caggeshall St

100'± E. of No. Front St.

to connect with the sewer in Caggeshall street,  
the same to be laid in the street and the surface repaired as directed by the Commissioner of Public Works.

I hereby agree to pay at the office of the City Treasurer all cost of performing the above work in the manner specified, in excess of the deposit made herewith, within 10 days after the completion of the work.

It is understood and agreed that the deposit made with this application shall be applied to the payment of the cost of performing the work done, and that any excess of deposit over the cost shall be returned to me by the City Treasurer.

Witness Bill Boucher

John P. Santos }  
Property owner

161 EARLE ST.

Address

CLUB RECORDACIOS DE PORTUGAL, INC

253 COGGESHALL ST.

Address

Requires separate entrance  
for roof water

**Consent of Owner of Private Drain**

New Bedford, Mass.,

To the Mayor and City Council:

I hereby grant to

the privilege of draining premises

through the private drain owned by me connecting with sewer in

street.

Owner

**Estimate and Deposit Requirement**

Office of Commissioner of Public Works, 4/3/73

My estimate of the cost of laying the drain described in the above application is

172.00

Assessed

Entrance charges

Total deposit required 172.00

George H. Brightman  
Commissioner of Public Works

**Certificate of Issue**

Office of City Clerk, 4/3/73

The above application, accompanied by City Treasurer's receipt presented this day; whereupon

Permit No. 19556 was issued, and the Commissioner of Public Works notified of the same.

Eileen M. Laughon  
City Clerk


✓ Laid from main in street to ~~iron pipe~~ in property.

✓ Owner agrees to supply all necessary

transits

pipe.

Sewer in north gutter line

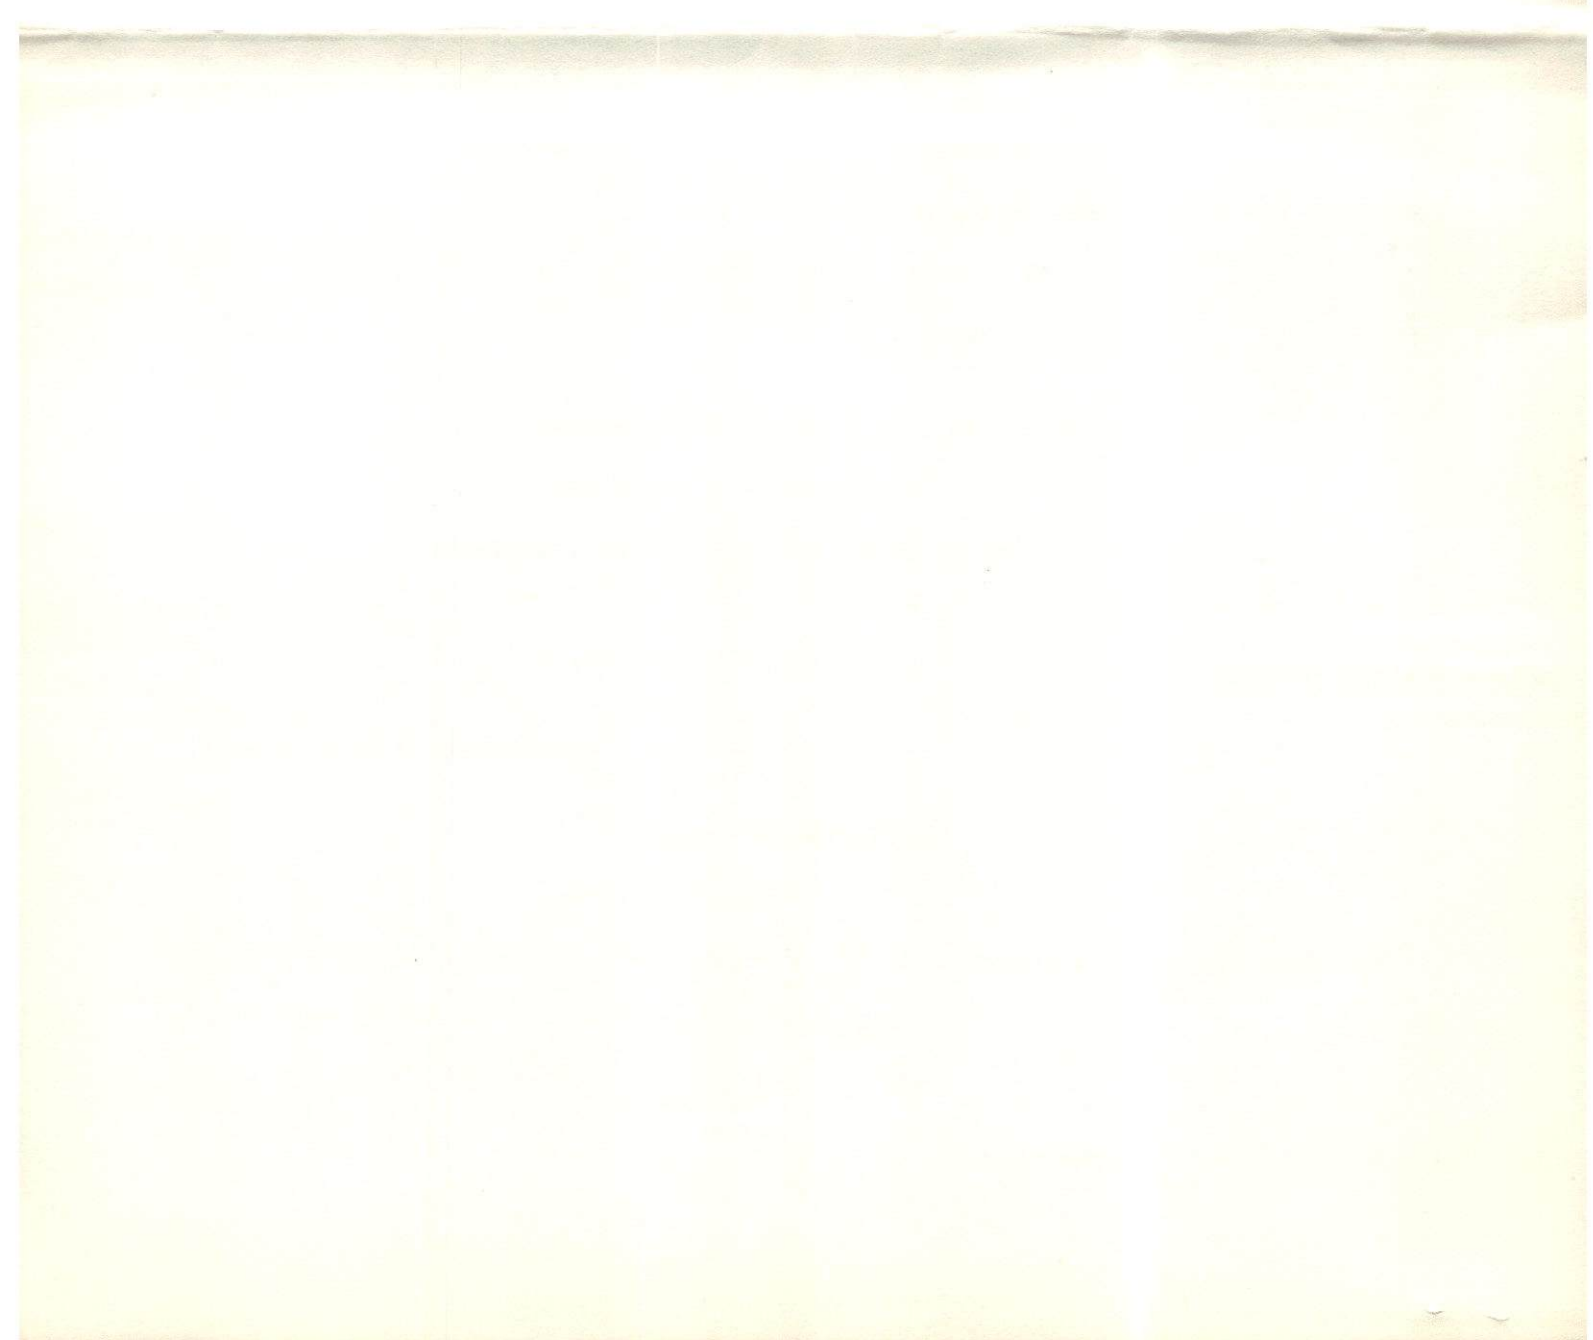

This is to certify that  
Mr. John Santos, has my  
permission to sign for the  
Club Recordaes de Portugal  
for the seamer permit.

Frank Roque  
President.  
Club Recordaes de  
Portugal

to Capt. J. H. ...

25-10-1917

10/27/2010

16. What is the purpose of the book?

1870

1/2

9

live to 100.

the Port of New York



# NOTICE TO COMMISSIONER OF PUBLIC WORKS

21

Length of drain 15  
 Sewer depth 11 1/2  
 Surf. drain .....  
 ..... pipe system

*Billed 7/3/73 @*

Drain Permit **Nº 19556**

City of New Bedford,

Office of City Clerk,

*4/3/73*

To Commissioner of Public Works.

Permission has this day been issued to

*Clyde Rodrigues de  
 Portugal Inc*

property owner

*253 Coggeshall St*

Address

By

Address

to lay drain from the premises of

*N.S. Coggeshall St 100' ±  
 E. of No Front St*

to connect with the sewer in

*Coggeshall*

street.

Laid from main in street to ~~main~~ *line* in property.

Owner agrees to supply all necessary

*transite*

pipe.

*Eileen M. Gaughan*

City Clerk.

*lg*

Requires separate entrance for sewage and roof water

*Sewer in north gutter line*

*EM*

# RETURN OF FOREMAN

Entered M27 22 19 73  
 Time 12 Noon  
 By Jesse W. Jones  
 COST

Labor	hours @		
Jesse Jones ?	" 3.85	34	65 ✓
Joseph Alfaro ?	" 3.42	30	78 ✓
Volunt ST. Pierre ?	" 3.31	29	79 ✓
Joseph Belonger ?	" 3.19	28	71 ✓
Tom Burke ?	" 3.53	31	77 ✓
Rod Braga ?	" 3.71	14	84 ✓
Steve Bombardier ?	" 3.96	19	80 ✓
Stock		190	34 ✓
1/2 bag Cement @ 2.05		1	83 ✓
100 lbs Sand		19	✓
1-30° Elbow		8	40 ✓
Repair 10 x 3 B.T. with 2.15		9	17 ✓
116 x 3 B.T. Street @ 2.85 ft.		22	10 ✓
Trucking			
#65 - 3 - HR. @ 6.15		19	65 ✓
116 - 1 - HR. truck		3	00 ✓
52 - 1 - HR Comp.		3	35 ✓
Total Cost		257	23
Estimate-cost of laying drain	172-		
Entrance charges			
Total deposit			
Balance due City		85	23

Pieces pipe to curb 1-6ft.  
 " " curb to house 1-10ft.  
 Cut at sewer 11 1/2 ft.  
 Cut at curb 10 ft.  
 Size of pipe 6" Trans. to  
 Correct

Jesse W. Jones

Foreman

Don Oliver  
1-HR. Showing to Howard

Tough  
ground  
Ledge  
water

owner supply pipe