CITY OF NEW BEDFORD

APPLICATION FOR LAYING BUILDING SEWER AND/OR DRAIN SERVICE

Application Nº 1965	8 may 3 1974 pate
To the Mayor and City Counci	1:
I hereby request that a b	uilding sewer and/or drain be laid for the premises at
w. S. Perchase	St. 50't n. of Bedfiel St.
CONTROL III	
to connect with the sewer/dra	ain in Kruckese street,
the same to be laid in the stre Public Works.	eet and the surface repaired as directed by the Commissioner of
I hereby agree to pay at work in the manner specified, completion of the work.	t the office of the City Treasurer all cost of performing the above in excess of the deposit made herewith, within 10 days after the
to the payment of the cost of cost shall be returned to me h	performing the work done, and that any excess of deposit over the by the City Treasurer.
Witness Il Howartt	I New England T. E. T.
	Signature of Property Owner APPUCANT.
	Signature of Property Owner APPHCANT. 1166 Showmut Que. 9943 Address Telephone No.
	Plumber's Name
Requires separate entrance	
for roof water	Address
Permits to	o Industrial and/or Commercial Applicants:
the Commissioner of Public V	Vorks of such supplemental information as may be required by and quantity of the proposed wastewater discharge.
This information was su	bmitted by
	Signature of Applicant (owner)
and approved by the Commi	ssioner of Public Works on
	Commissioner of Public Works
	Estimate and Deposit Requirement
	Office of Commissioner of Public Works, May 3 1974
My estimate of the cost	of laying the building sewer and/or drain described in the above
application is	
Assessed	
Entrance charges	Total deposit required
	Sough H. Brighting Commissioner of Public Works
	Certificate of Issue
	4
m1	Office of City Clerk, May 3 1974
The above application,	accompanied by City Treasurer's receipt presented this day;
	9658 was issued, and the Commissioner of Public Works
notified of the same.	
	Ellen M. Guighau City Clerk LLA
Laid from main in street to proper Owner agrees to supply all necessary	ty line.

ials and pipe.


SECTION WAS TO VIEW

TOTAL AND AND SOCIAL ASSESSMENT OF THE STATE OF THE SECOND STATE OF THE SECOND SECOND

C.C. markey.
and the second

Length of service 50 Bulled Trafty	(×201
Length of service	
Sewer depth	pipe system
Surf. drain Contractor's Name	
(if working on City	
City of New Bedford,	
Drain Permit Nº 19658 Office of D. P. W., Date	1974
To Commissioner of Public Works.	
Permission has this day been issued to	
Signature of Property Owner APPLICANT Address	leve.
Signature of Property Owner # PPLICH WI Address	1
By Kenneth C. Pelith 1166 Shawnet Address	Que.
to lay a building sewer/drain service from the premises at	
its Pirchase St. 50' = n. of Bedfare	
to connect with the sewer/drain in	street.
Laid from main in street to property line. Owner agrees to supply all necessary materials By Ellen M. Hang	ighan
relay of extracting draw to 24 Breik Lewer en B	erford \$0

MOTT TA RETURN OF FOREMAN 20 Entered 17 COST Labor hours @ - =160,2 4.33 3.74-138.38 3.74-138.38 3.11-115.07 3.68-136.16 3.91+ 31.28=559.2 \$719.4 Stock 2.45 @ 2.45-.20 .10-BI. STreet@282 241.50 C.Gravel-42,240# @.07 cwt - 29,57 Trucking 15.00 -@3.00 -16.75 @3,35 e stuterant of took hills 146.20 1141.63 Total Cost Estimate-cost of laying drain Entrance charges Total deposit Balance due Pieces pipe to curb " curb to house..... Cut at sewer 6 ff Cut at curb.... Size of pipe 6 Trza Correct

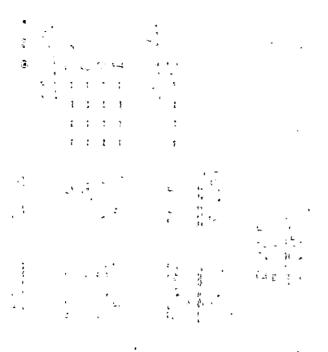

#19658

~~ ·	Superv.	Labor
Roll #19		
5/7	34.64	114.16
5/8	34.64	114.16
5/9	34.64	114,16
5/10	34.64	114.16
Roll #20		
5/13	21.65	102.63
	160,21	559.27

160.21 559.27 719.48

Permit #19658 - relay drain Chg. New Eng. Tel. & Tel.

Sturtevant & Hook bills -

Bill #84657

Bill #84788	
2-10' pcs. of 4" transite pipe - B/S w/coup.	35.00
20 ft. @ 85¢ 1-6" transite wye	17.00
1-6" V.C. 90° elbow	8.40
1-6"-4 V.C. reducer	8.40
Bill #84667	
5-10' pcs. 6" transite B/S	
pipe w/coup. 50 ft. @ 1.35	67.50
1-6x6 transite wye	11.25
1-6" - 90 elbow	6.75
1 bag hi-early cement	3.05

2 tubes transite lubricant @ 45¢ .90

146.20

2-6" transite 45° elbows @ 5.85 11.70