

CITY OF NEW BEDFORD

APPLICATION FOR LAYING BUILDING SEWER AND/OR DRAIN SERVICE

Application **Nº 19674**

.....
Date

To the Mayor and City Council:

I hereby request that a building sewer and/or drain be laid for the premises at

.....
to connect with the sewer/drain in street,
the same to be laid in the street and the surface repaired as directed by the Commissioner of
Public Works.

I hereby agree to pay at the office of the City Treasurer all cost of performing the above
work in the manner specified, in excess of the deposit made herewith, within 10 days after the
completion of the work.

It is understood and agreed that the deposit made with this application shall be applied
to the payment of the cost of performing the work done, and that any excess of deposit over the
cost shall be returned to me by the City Treasurer.

Witness

Bill Bunker

.....
Signature of Property Owner

1016 Beverly St.
Address

53343
Telephone No.

.....
Plumber's Name

Requires separate entrance
for roof water

.....
Address

Permits to Industrial and/or Commercial Applicants:

Permits can be issued to industrial and/or commercial applicants only upon receipt by
the Commissioner of Public Works of such supplemental information as may be required by
him concerning the quality and quantity of the proposed wastewater discharge.

This information was submitted by

.....
Signature of Applicant (owner)

and approved by the Commissioner of Public Works on

.....
Date

.....
Commissioner of Public Works

Estimate and Deposit Requirement

Office of Commissioner of Public Works, *6-3-74*

My estimate of the cost of laying the building sewer and/or drain described in the above
application is *\$119*

Assessed

Entrance charges

Total deposit required *\$119.00*

George R. Brightman
Commissioner of Public Works

Certificate of Issue

Office of City Clerk, *6-3-74*

The above application, accompanied by City Treasurer's receipt presented this day;
whereupon Permit No. *19674* was issued, and the Commissioner of Public Works
notified of the same.

Ellen M. Laughan
City Clerk

Laid from main in street to property line.
Owner agrees to supply all necessary mater-
ials and *TRANSIT* pipe.

NOTICE TO COMMISSIONER OF PUBLIC WORKS

55

Length of service 28'
 Sewer depth 5 1/2
 Surf. drain 4

Billed 9/11/74

..... 2 pipe system

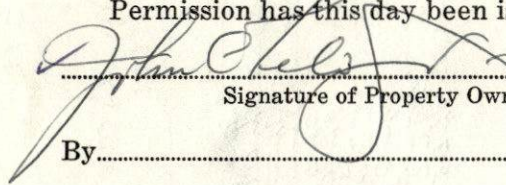
Contractor's Name
 (if working on City Property)

Drain Permit **Nº 19674**

City of New Bedford,

Office of D. P. W., 6-3-74
 Date


To Commissioner of Public Works.
 Permission has this day been issued to

 (John C. Telio) 1016 Beverly St
 Signature of Property Owner Address
 By Address

to lay a building sewer/drain service from the premises at
 S. SIDE BEVERLY ST., 130' E. OF BARTLETT ST.

to connect with the sewer/drain in BEVERLY ST. street.

✓ Laid from main in street to property line.
 ✓ Owner agrees to supply all necessary materials
 and TRANSITE pipe.

By 

Requires separate entrance for sewage and roof water

31
340

RETURN OF FOREMAN

Entered Aug. 21 19 74
 Time 6 P.M.
 By Jose M. Morales
 COST

| Labor | hours @ | | |
|--------------------------|-------------------|-----------|-----------|
| <u>Jose M. Morales</u> | <u>5 2h 04.38</u> | <u>26</u> | <u>42</u> |
| <u>Robert St. Pierre</u> | <u>5 3h 03.79</u> | <u>22</u> | <u>75</u> |
| <u>Joe Ferreira</u> | <u>5 3h 03.79</u> | <u>22</u> | <u>75</u> |
| <u>John Lemos</u> | <u>5 3h 03.76</u> | <u>18</u> | <u>96</u> |
| <u>Tom Burke</u> | <u>5 3h 03.23</u> | <u>22</u> | <u>39</u> |
| <u>Joe Macado</u> | <u>5 3h 03.51</u> | <u>23</u> | <u>46</u> |
| | <u>" 2h 05.87</u> | | |

(11380)

Stock

1/2 bag Cement @ 2.45 1 23
100 lbs Sand (cut) @ .10 .10

Trucking

2 13 10
#35 - 1-HRS @ 6.50 19 65
116 - 1-HR. 3 00

Total Cost

Estimate-cost of laying drain

Entrance charges

Total deposit

Balance due

Pieces pipe to curb 2 1-10ft. 1-5ft.
 " " curb to house 1 1-10ft. Piece
 Cut at sewer 5 1/2 ft.
 Cut at curb 5 ft.
 Size of pipe 4" + 6" Trans. 7p
 Correct

Jose M. Morales
 Foreman

owner supply pipe