

CITY OF NEW BEDFORD

APPLICATION FOR LAYING BUILDING SEWER AND/OR DRAIN SERVICE

Application N^o 19781

5/13/75
Date

To the Mayor and City Council:

I hereby request that a building sewer and/or drain be laid for the premises at

State St #208 75' ± s of Linden Street

to connect with the sewer/drain in street,
the same to be laid in the street and the surface repaired as directed by the Commissioner of
Public Works.

I hereby agree to pay at the office of the City Treasurer all cost of performing the above
work in the manner specified, in excess of the deposit made herewith, within 10 days after the
completion of the work.

It is understood and agreed that the deposit made with this application shall be applied
to the payment of the cost of performing the work done, and that any excess of deposit over the
cost shall be returned to me by the City Treasurer.

Witness

Ethel Gifford

Signature of Property Owner

Address

174 Linden St.

Telephone No.

7-784-1

Plumber's Name

Requires separate entrance
for roof water

Address

Permits to Industrial and/or Commercial Applicants:

Permits can be issued to industrial and/or commercial applicants only upon receipt by
the Commissioner of Public Works of such supplemental information as may be required by
him concerning the quality and quantity of the proposed wastewater discharge.

This information was submitted by

Signature of Applicant (owner)

and approved by the Commissioner of Public Works on

Date

Commissioner of Public Works

Estimate and Deposit Requirement

Office of Commissioner of Public Works, 5/13/75

My estimate of the cost of laying the building sewer and/or drain described in the above
application is

Assessed

Entrance charges

Total deposit required

160 00/100

Commissioner of Public Works

Certificate of Issue

Office of City Clerk, 5/13/75

The above application, accompanied by City Treasurer's receipt presented this day;
whereupon Permit No. 19781 was issued, and the Commissioner of Public Works
notified of the same.

City Clerk

Laid from main in street to property line.
Owner agrees to supply all necessary mater-
ials and pipe.

5-13-75



M.H. ①

INV. 95.86

STATE

292.5'

ST


RIM 100 (ASSUMED) M.H. ②

INV. 92.47

ST

UNDEN

- Need Rains ① ②
- " INV ① ②
- " Trap in house (X)
- " house location

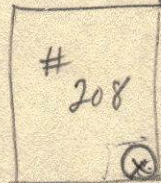

102.10

104.40

102.10


102.10

102.10

102.10

102.10

CURBLINE

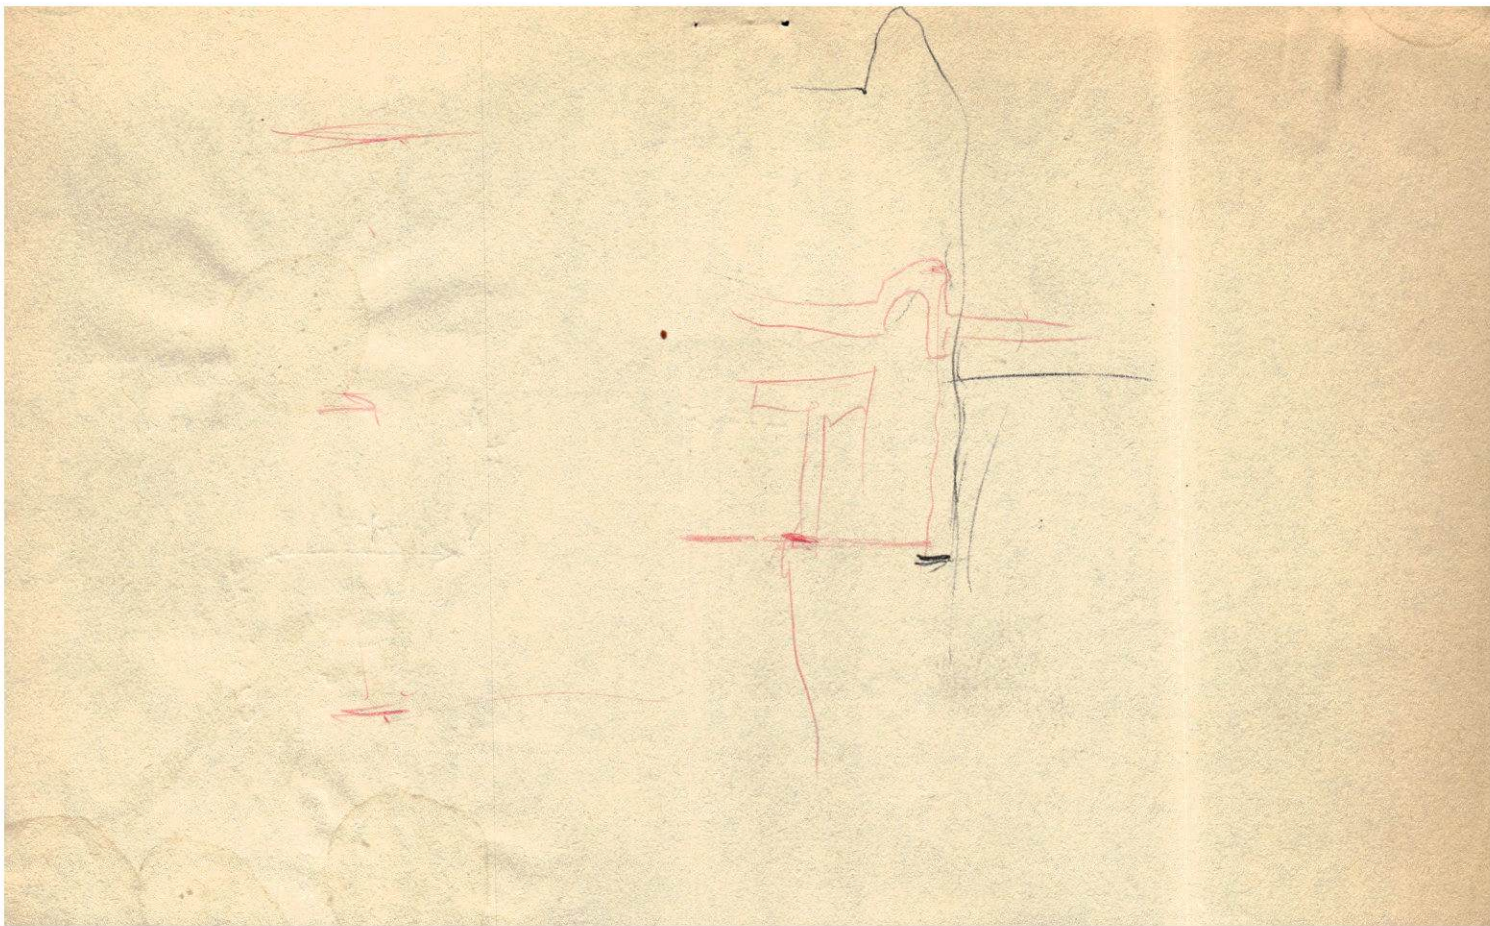

208 STATE ST

FROM

TO

FOR M.H. ELEV. DRAIN BY ^{KC}JP

19

ASSUMED

Rim to INV.

6.25 106.25

100.00 M.H. @ LINDEN STATE (2)

7.53 = 92.47

3.94 102.31

" @ STATE (1)

6.45 = 95.86

1.85 104.40 SILL ELEV. # 208 STATE

SILL TO PIPE 2.30 = 102.10

FROM

TO

FOR

BY

19

