

CITY OF NEW BEDFORD

APPLICATION FOR LAYING BUILDING SEWER AND/OR DRAIN SERVICE

Application **Nº 19826**

November 25, 1975

Date

To the Mayor and City Council:

I hereby request that a building sewer and/or drain be laid for the premises at

N.S. VICTORIA STREET 250' ⁺ E. OF MONSON STREET

to connect with the sewer/drain in VICTORIA street,
the same to be laid in the street and the surface repaired as directed by the Commissioner of
Public Works.

I hereby agree to pay at the office of the City Treasurer all cost of performing the above
work in the manner specified, in excess of the deposit made herewith, within 10 days after the
completion of the work.

It is understood and agreed that the deposit made with this application shall be applied
to the payment of the cost of performing the work done, and that any excess of deposit over the
cost shall be returned to me by the City Treasurer.

Witness

Joseph R. Rodriguez
Property owner

Signature of Property Owner

Witness - *Linda J. Thomas*

929 Victoria St
Address

81449

Telephone No.

Plumber's Name

Requires separate entrance
for roof water

Address

Permits to Industrial and/or Commercial Applicants:

Permits can be issued to industrial and/or commercial applicants only upon receipt by
the Commissioner of Public Works of such supplemental information as may be required by
him concerning the quality and quantity of the proposed wastewater discharge.

This information was submitted by

Signature of Applicant (owner)

and approved by the Commissioner of Public Works on November 25, 1975

Date

Commissioner of Public Works

Estimate and Deposit Requirement

Office of Commissioner of Public Works, November 25, 1975

My estimate of the cost of laying the building sewer and/or drain described in the above
application is

Assessed

Entrance charges Total deposit required 560.30

George H. Brighton
Commissioner of Public Works (201)

Certificate of Issue

Office of City Clerk, November 25, 1975

The above application, accompanied by City Treasurer's receipt presented this day;
whereupon Permit No. 19826 was issued, and the Commissioner of Public Works
notified of the same.

Ellen M. Goughan
City Clerk (201)

Laid from main in street to property line.
Owner agrees to supply all necessary mater-
ials and pipe.

1923

I, the undersigned, do hereby certify that the above named person or persons are duly qualified to sell or exchange the securities herein mentioned, and that they are not under any legal disability to do so.

Witness my hand and seal this _____ day of _____, 1923.

Mayor

CONFIDENTIAL

I, the undersigned, do hereby certify that the above named person or persons are duly qualified to sell or exchange the securities herein mentioned, and that they are not under any legal disability to do so.

Witness my hand and seal this _____ day of _____, 1923.

Mayor

NOTICE TO COMMISSIONER OF PUBLIC WORKS

48

Length of service ----

Sewer depth 2 1/2'

Surf. drain ----

File 3/25/74

1 pipe system

Contractor's Name
(if working on City Property)

Drain Permit N^o 19826

City of New Bedford,

Office of D. P. W., November 25, 1975
Date

To Commissioner of Public Works.

Permission has this day been issued to

Joseph Rodriguez
Signature of Property Owner

929 Victoria St 81449
Address

tel #

By
Address

to lay a building sewer/drain service from the premises at
N.S. Victoria Street 250'± E. of Monson Street

to connect with the sewer/drain in Victoria street.

Laid from main in street to property line.

Owner agrees to supply all necessary materials
and pipe.

By Ellen M. Guzman

Requires separate entrance for sewage and roof water

RETURN OF FOREMAN

Entered.....*Oct. 16.*.....19*75*
 Time.....
 By.....

COST

Labor <i>McCarthy</i>	<i>6</i>	hours @ <i>5.23</i>	<i>31</i>	<i>38</i>
<i>Mullins</i>	<i>6</i>	" @ <i>4.09</i>	<i>24</i>	<i>24</i>
<i>Whitehead</i>	<i>6</i>	" @ <i>3.34</i>	<i>20</i>	<i>04</i>
<i>Ellison</i>	<i>6</i>	" @ <i>3.53</i>	<i>21</i>	<i>18</i>
<i>De Mello, B.</i>	<i>6</i>	" @ <i>4.16</i>	<i>24</i>	<i>96</i>
<i>Corvicio, Wm.</i>	<i>6</i>	" @ <i>3.81</i>	<i>22</i>	<i>86</i>
		"	<i>144</i>	<i>66</i>
		"		
Stock <i>75' cast iron pipe @ 1.65</i>			<i>123</i>	<i>75</i>
<i>3 bhp motor cement @ 2.60</i>			<i>7</i>	<i>80</i>
<i>6 cu ft. sand @ 1.00</i>				<i>60</i>
Trucking <i>#83- 1 hr.</i>			<i>3</i>	<i>45</i>
<i>#49- Backhoe. 3 hr. @ 7.00</i>			<i>21</i>	<i>00</i>
<i>Cost of drain</i>			<i>301</i>	<i>26</i>
<i>Cost of main sewer</i>			<i>259</i>	<i>04</i>
Total Cost			<i>560.30</i>	
Estimate-cost of laying drain	<i>560</i>	<i>30</i>		
Entrance charges				
Total deposit				
Balance due				

Pieces pipe to curb.....


" " curb to house.....

Cut at sewer.....

Cut at curb.....

Size of pipe.....

Correct

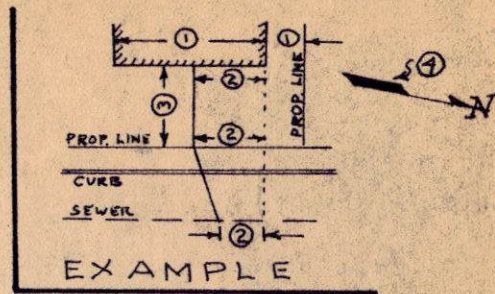
Installed by J. McCarthy -
WCB 

Foreman

DRAIN NO. 19826OWNER ^{JOSEPH} RODRIGUES

- ① MEASURE FRONT OF HOUSE, DISTANCE TO LOT LINE.
- ② MEASURE FROM COR. OF HOUSE TO DRAIN, DISTANCE WHERE DRAIN CROSSES PROPERTY LINE, ENTERS SEWER
- ③ LENGTH OF DRAIN FROM FRONT PROP. LINE TO HOUSE
- ④ SHOW NORTH ARROW.

929 VICTORIA

#19826 - Victoria st. n.s. 250' e. Monson st.
to enter Victoria st. sewer

EXAMPLE

20 FT 44 FT

24 FT

18 FT

PROP. LINE

CURB LINE (IF ANY)

SEWER

57 FT

John

McCarthy 6 hours @ 5.93 = 31.38
 Macklin 6 " @ 4.04 = 24.24
 Whithead 6 @ 3.34 = 20.04
 Elison 6 @ 3.53 = 21.18
 DeWells B. 6 @ 4.16 = 24.96
 Carcia, Min. 6 @ 3.81 = 22.86
 144.66

Material
 75' cut from top @ 1.65
 3 bags water cement @ 2.60
 6 cut, dirt @ 1.00
 Equipment

Truck # 83 - 4 hours = 3.45
 Backhoe # 49 - 3 hours = 21.00
 @ 7.00
 30.1.26

Cost of main power
 into charge

259.04
 560.30

Continued by me Lantry - (WR) (B)
 THURS - 10/16/75