

CITY OF NEW BEDFORD

APPLICATION FOR LAYING BUILDING SEWER AND/OR DRAIN SERVICE

Application No 20450

9-17-79
Date

To the Mayor and City Council:

I hereby request that a building sewer and/or drain be laid for the premises at M.D.

94 Kilburn St 360' ± e of Belleville Ave

to connect with the sewer/drain in Kilburn St street,
the same to be laid in the street and the surface repaired as directed by the Commissioner of
Public Works.

I hereby agree to pay at the office of the City Treasurer all cost of performing the above
work in the manner specified, in excess of the deposit made herewith, within 10 days after the
completion of the work.

It is understood and agreed that the deposit made with this application shall be applied
to the payment of the cost of performing the work done, and that any excess of deposit over the
cost shall be returned to me by the City Treasurer.

Witness Lynda Balgo Ronald Wapfelt
Signature of Property Owner

Requires separate entrance
for roof water

34 Address Telephone No.
Daniel J. Davis
Plumber's Name
266 W. FRONT MB.
Address

Permits to Industrial and/or Commercial Applicants:

Permits can be issued to industrial and/or commercial applicants only upon receipt by
the Commissioner of Public Works of such supplemental information as may be required by
him concerning the quality and quantity of the proposed wastewater discharge.

This information was submitted by BY DIAS PLUMBERS
Signature of Applicant (owner)

and approved by the Commissioner of Public Works on 9-17-79
Date

George H. Brighton
Commissioner of Public Works

Estimate and Deposit Requirement

Office of Commissioner of Public Works, 9-17-79

My estimate of the cost of laying the building sewer and/or drain described in the above
application is

Assessed Entrance charges Total deposit required 218.00

George H. Brighton
Commissioner of Public Works

Certificate of Issue

Office of City Clerk, 9-17-79

The above application, accompanied by City Treasurer's receipt presented this day;
whereupon Permit No. 20450 was issued, and the Commissioner of Public Works
notified of the same.

James A. Davidson
City Clerk

Laid from main in street to property line.
Owner agrees to supply all necessary mater-
ials and Transite pipe.

NO. 24110

TO THE HONORABLE THE COMMISSIONER OF THE LANDS, TOWNS AND VILLAGES DEPARTMENT, BOSTON, MASS.

RE: [Illegible text]

[Illegible text]

[Illegible text]

Coastal Fisheries, Inc.

UNION WHARF

P. O. BOX D-6

FAIRHAVEN, MASSACHUSETTS 02719

TEL. 617 / 996-9169 - 996-9112



August 20, 1979

City of New Bedford
Sewer Dept.
City Hall
New Bedford, Mass.:

To Whom It May Concern:

David Dias of Dias Plumbing & Heating has my authority to sign any necessary permits or work orders pertaining to sewerage installation at the Jay Bee Fillet Plant on Kilburn Street, New Bedford, Mass.

Very truly yours
Coastal Fisheries, Inc.

Ronald A. Nanfelt
Ronald A. Nanfelt, President




JAY BEA
FILLET

17 KILBURN ST.


BELLVILLE AVE

100'

100'

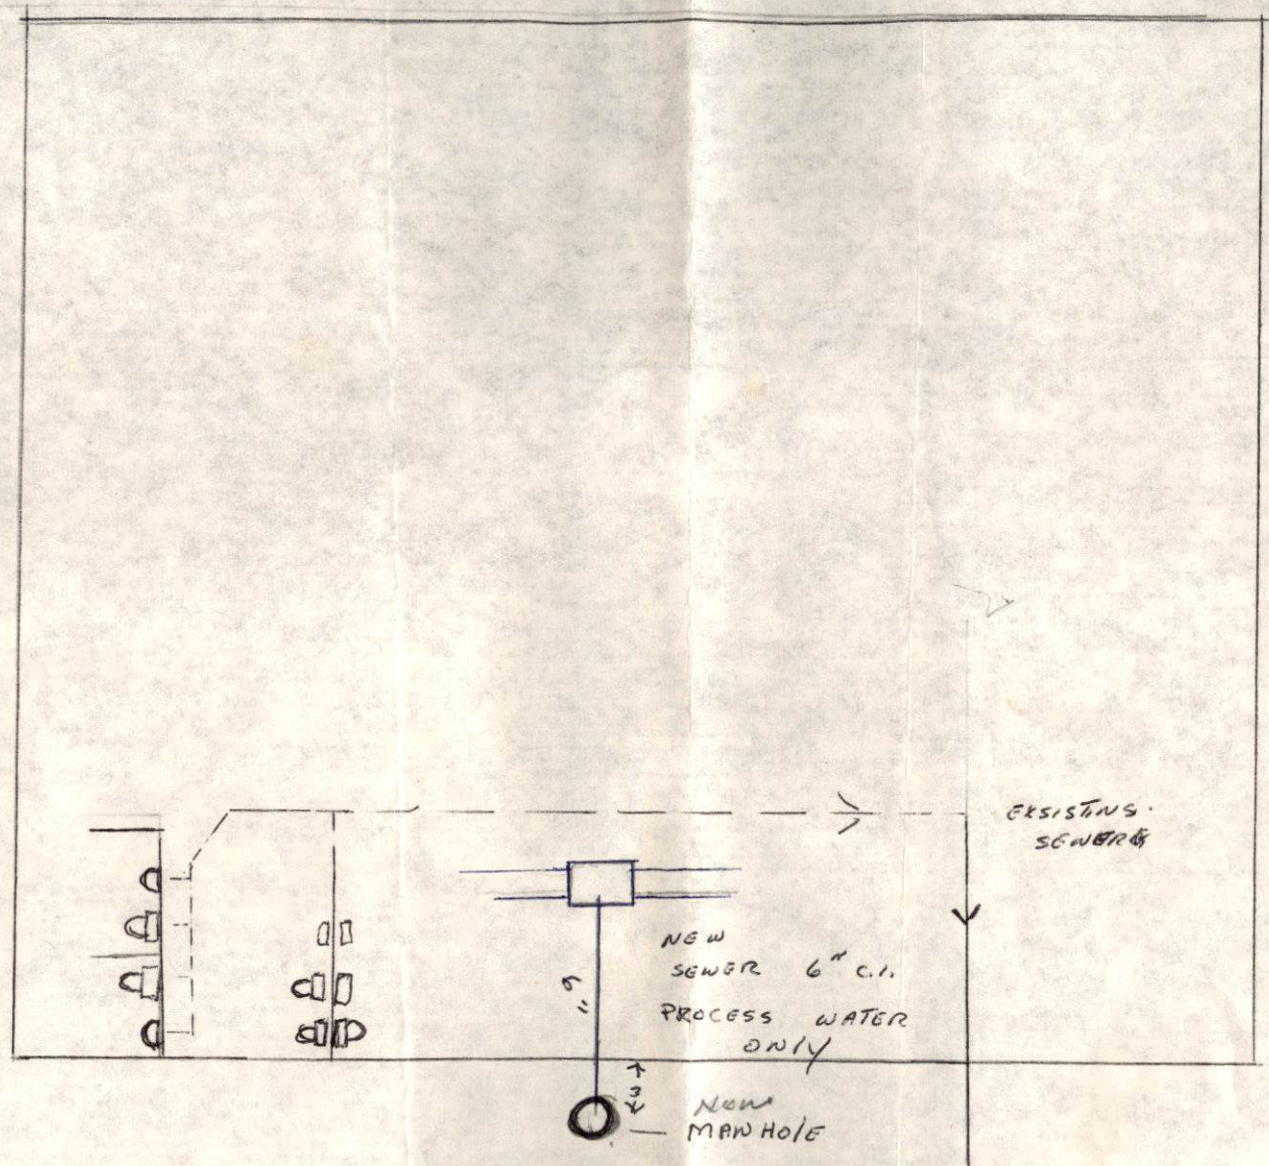

KILBURN ST.

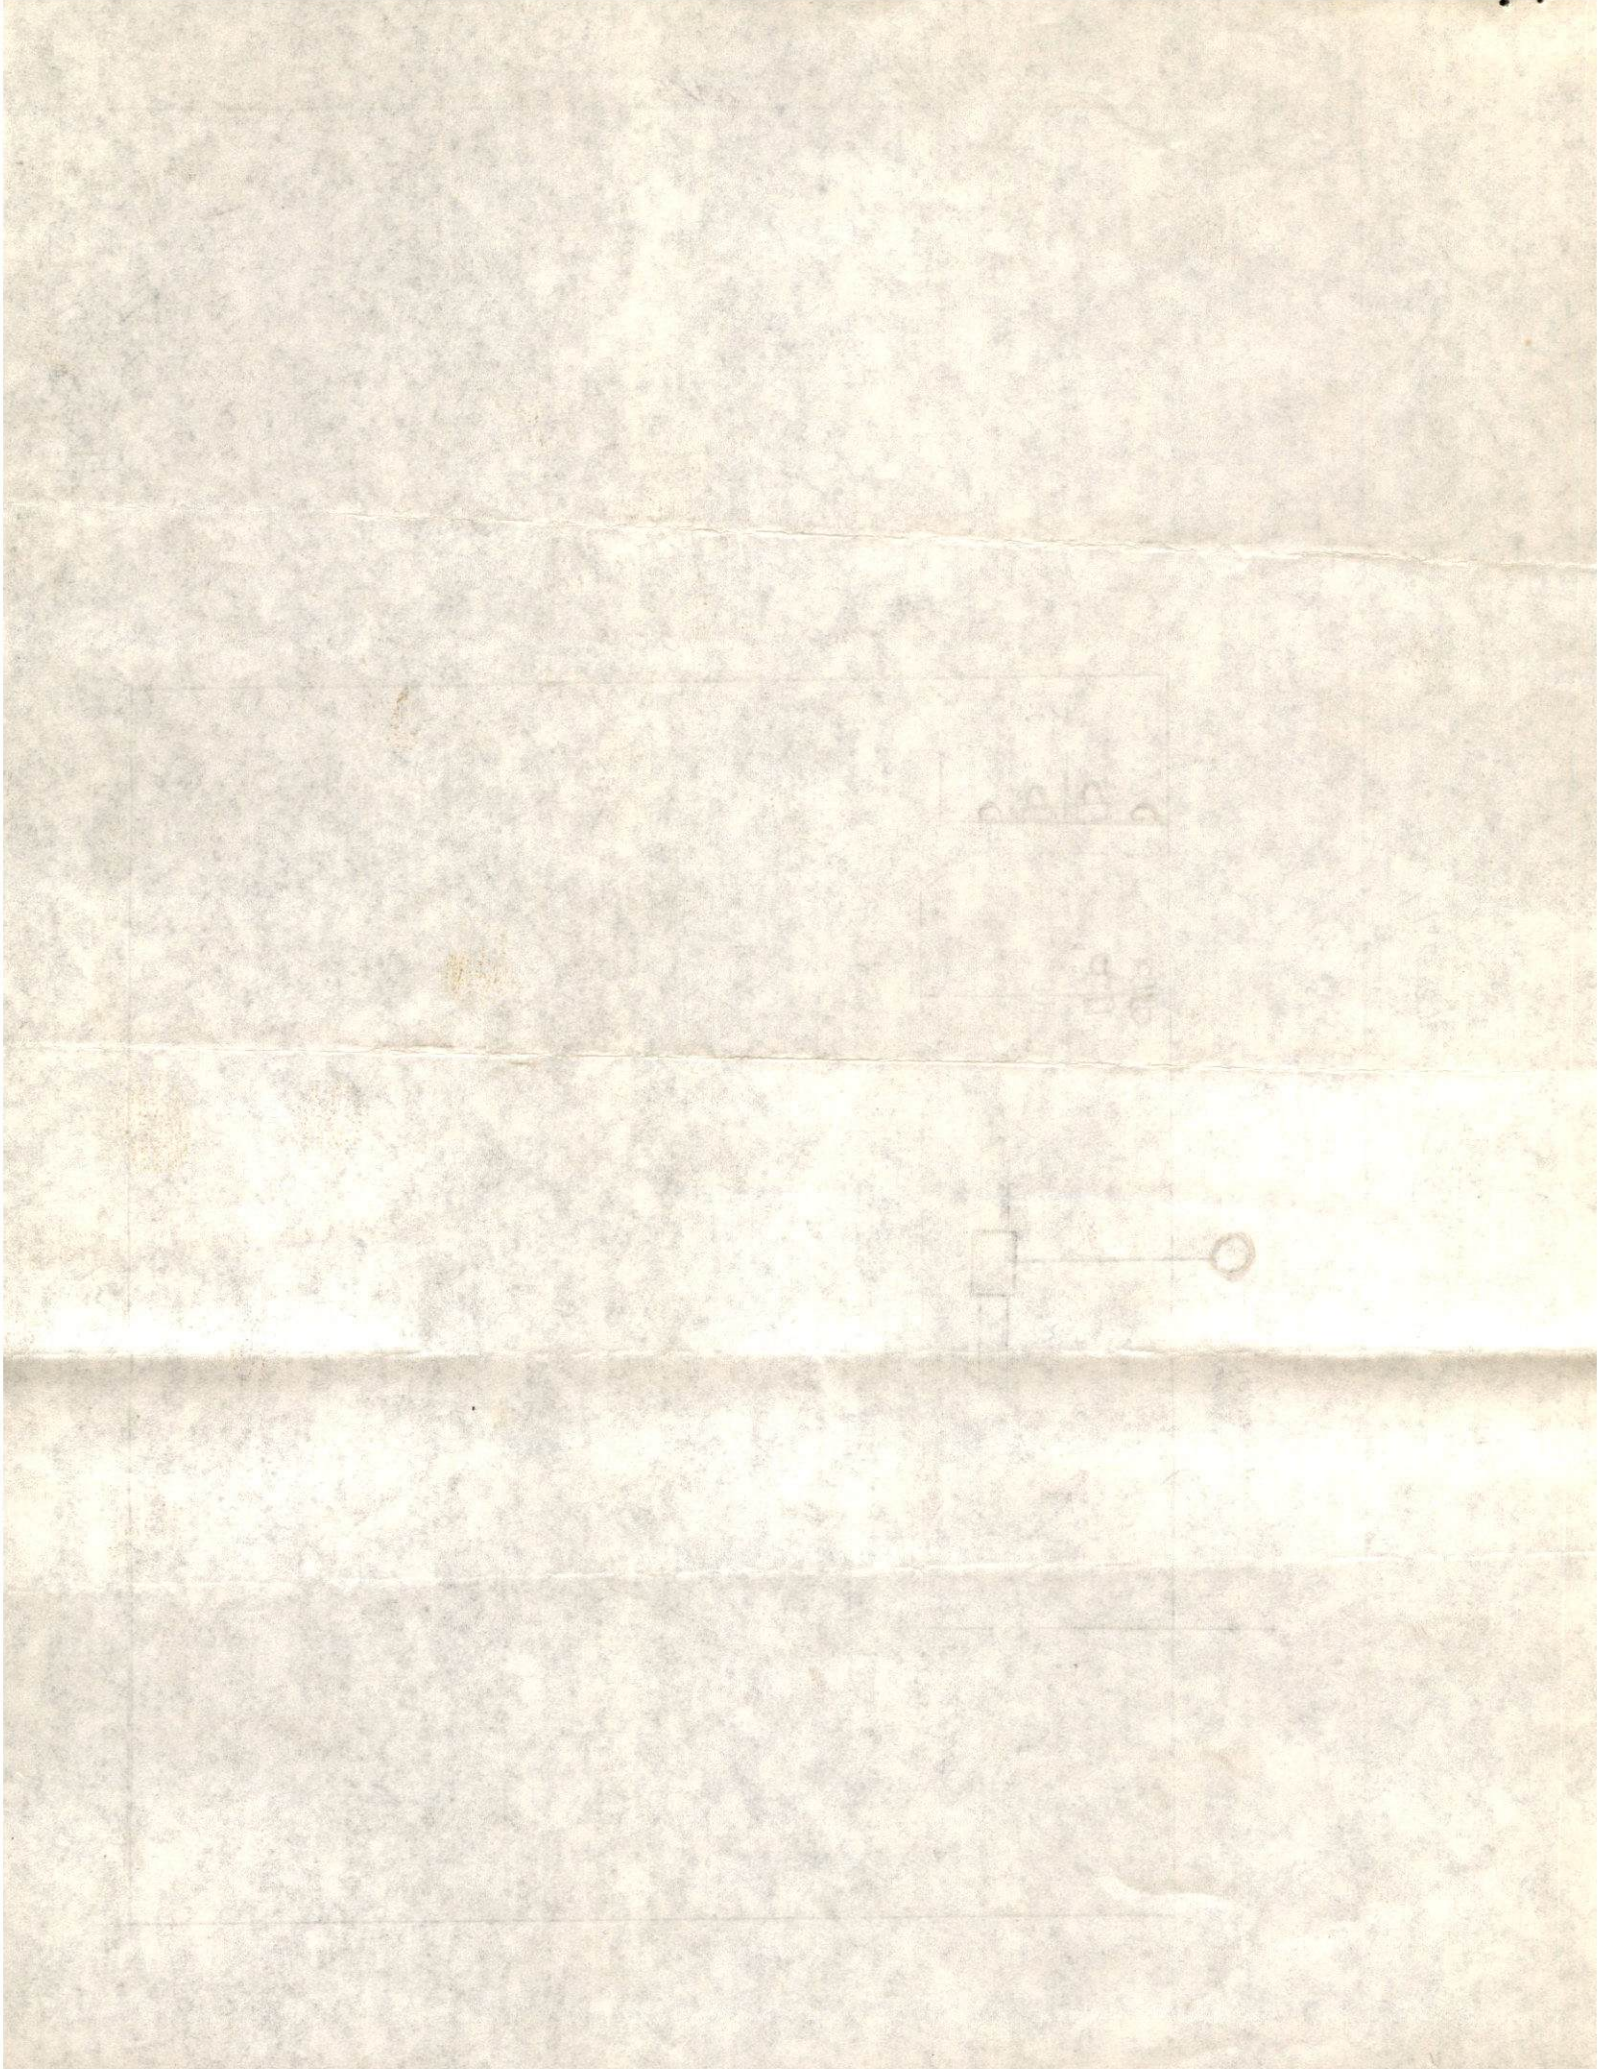

Permit No. 20450

1300
Per quarter

CITY OF NEW BEDFORD
DEPARTMENT OF PUBLIC WORKS

Supplementary Information Required from Commercial or
Industrial Firms in Addition to Issuance of Sewer Entrance Permit

- A. Architect's floor plan showing proposed connections to building drain (inside building):
B. Architect's detail drawings of any pretreatment or equalization equipment:
C. Site plan showing:

- (1) Building and location of building sewer
(2) Proposed connection to public sewer
(3) Profile of building sewer
(4) Plan and profile of storm drain
(5) Location of control manhole
(Standard type — preferably between property line and public sewer.)

D. Wastewater Information:

Date:

- (1) Name of firm: COASTAL FISHERIES INC.
(2) Address UNION WARE
(3) Name and title of person completing form. (company representative):
.....
(4) Industry type (SIC Number): Fish Processing
(5) Number of Employees: 35
(6) Principal products manufactured, produced, processed or sold: FISH
.....
(7) Sources of water supply: Municipal ☒ Well
(8) Estimated volume of water to be used per day: 24,000 gallons.
(9) Flow gauges in plant influent effluent.
(10) Water consumed in processes: %.
(11) Recycled water: %.
(12) Cooling water: %.
(13) Number of operating days per week: 5
(14) Number of shifts per day: 1
(15) Type of discharge: ☒ continuous batch.
(16) If batch per shift.
(17) Estimated volume of wastewater discharged daily gallons.
(18) Wastewater abatement practices to be used:
(a) Process changes:
.....
(b) Changes in raw materials:
.....
(c) Recycling methods:
.....
(d) Wastewater treatment equipment:
.....
(e) Monitoring devices:
.....
(f) Sampling and testing procedures:
.....
(19) Expected constituents of final wastewater discharge:
(a) pH (d) Cl Req'm't. mg/l
(b) Grease/Oil mg/l (e) S. S. mg/l
(c) C O D mg/l (f) Color mg/l

(20)

Signature of Property Owner

Date

Plumber 4-1916

Aug 21 1979

218
812
A