

CITY OF NEW BEDFORD

APPLICATION FOR LAYING BUILDING SEWER AND/OR DRAIN SERVICE

Application No 20460

9-20-79
Date

To the Mayor and City Council:

I hereby request that a building sewer and/or drain be laid for the premises at W. End of Pier 3 & 4, n. of Pedest. Overpass

to connect with the sewer/drain in Pier 3 & 4 street,
the same to be laid in the street and the surface repaired as directed by the Commissioner of Public Works.

I hereby agree to pay at the office of the City Treasurer all cost of performing the above work in the manner specified, in excess of the deposit made herewith, within 10 days after the completion of the work.

It is understood and agreed that the deposit made with this application shall be applied to the payment of the cost of performing the work done, and that any excess of deposit over the cost shall be returned to me by the City Treasurer.

Witness Doreen D. Leite Amador Bergeron
Signature of Property Owner

879 Pine Hill Dr 99-96376
Address Telephone No. 57746

Plumber's Name

Requires separate entrance
for roof water

Address

Permits to Industrial and/or Commercial Applicants:

Permits can be issued to industrial and/or commercial applicants only upon receipt by the Commissioner of Public Works of such supplemental information as may be required by him concerning the quality and quantity of the proposed wastewater discharge.

This information was submitted by Amador Bergeron
Signature of Applicant (owner)

and approved by the Commissioner of Public Works on 9/20/79
Date

George H. Brightman
Commissioner of Public Works ddl

Estimate and Deposit Requirement

Office of Commissioner of Public Works, 9/20/79

My estimate of the cost of laying the building sewer and/or drain described in the above application is

Assessed Entrance charges Total deposit required \$1500

George H. Brightman ddl
Commissioner of Public Works

Certificate of Issue

Office of City Clerk, 9/20/79

The above application, accompanied by City Treasurer's receipt presented this day; whereupon Permit No. 20460 was issued, and the Commissioner of Public Works notified of the same.

Janice A. Davidian
City Clerk ddl

Laid from main in street to property line.
Owner agrees to supply all necessary materials and transite pipe.

Insp. Only - Contractor to perform all work.

NO. 20140

RECEIVED OF THE CITY OF NEW YORK

RECEIVED

RECEIVED OF THE CITY OF NEW YORK

RECEIVED OF THE CITY OF NEW YORK


RECEIVED OF THE CITY OF NEW YORK

RECEIVED OF THE CITY OF NEW YORK

RECEIVED OF THE CITY OF NEW YORK

RECEIVED OF THE CITY OF NEW YORK

John J. Silva 99-3-0753
Builder manager,
Owner Bergeron Industries
Meeting Restaurant and Lounge

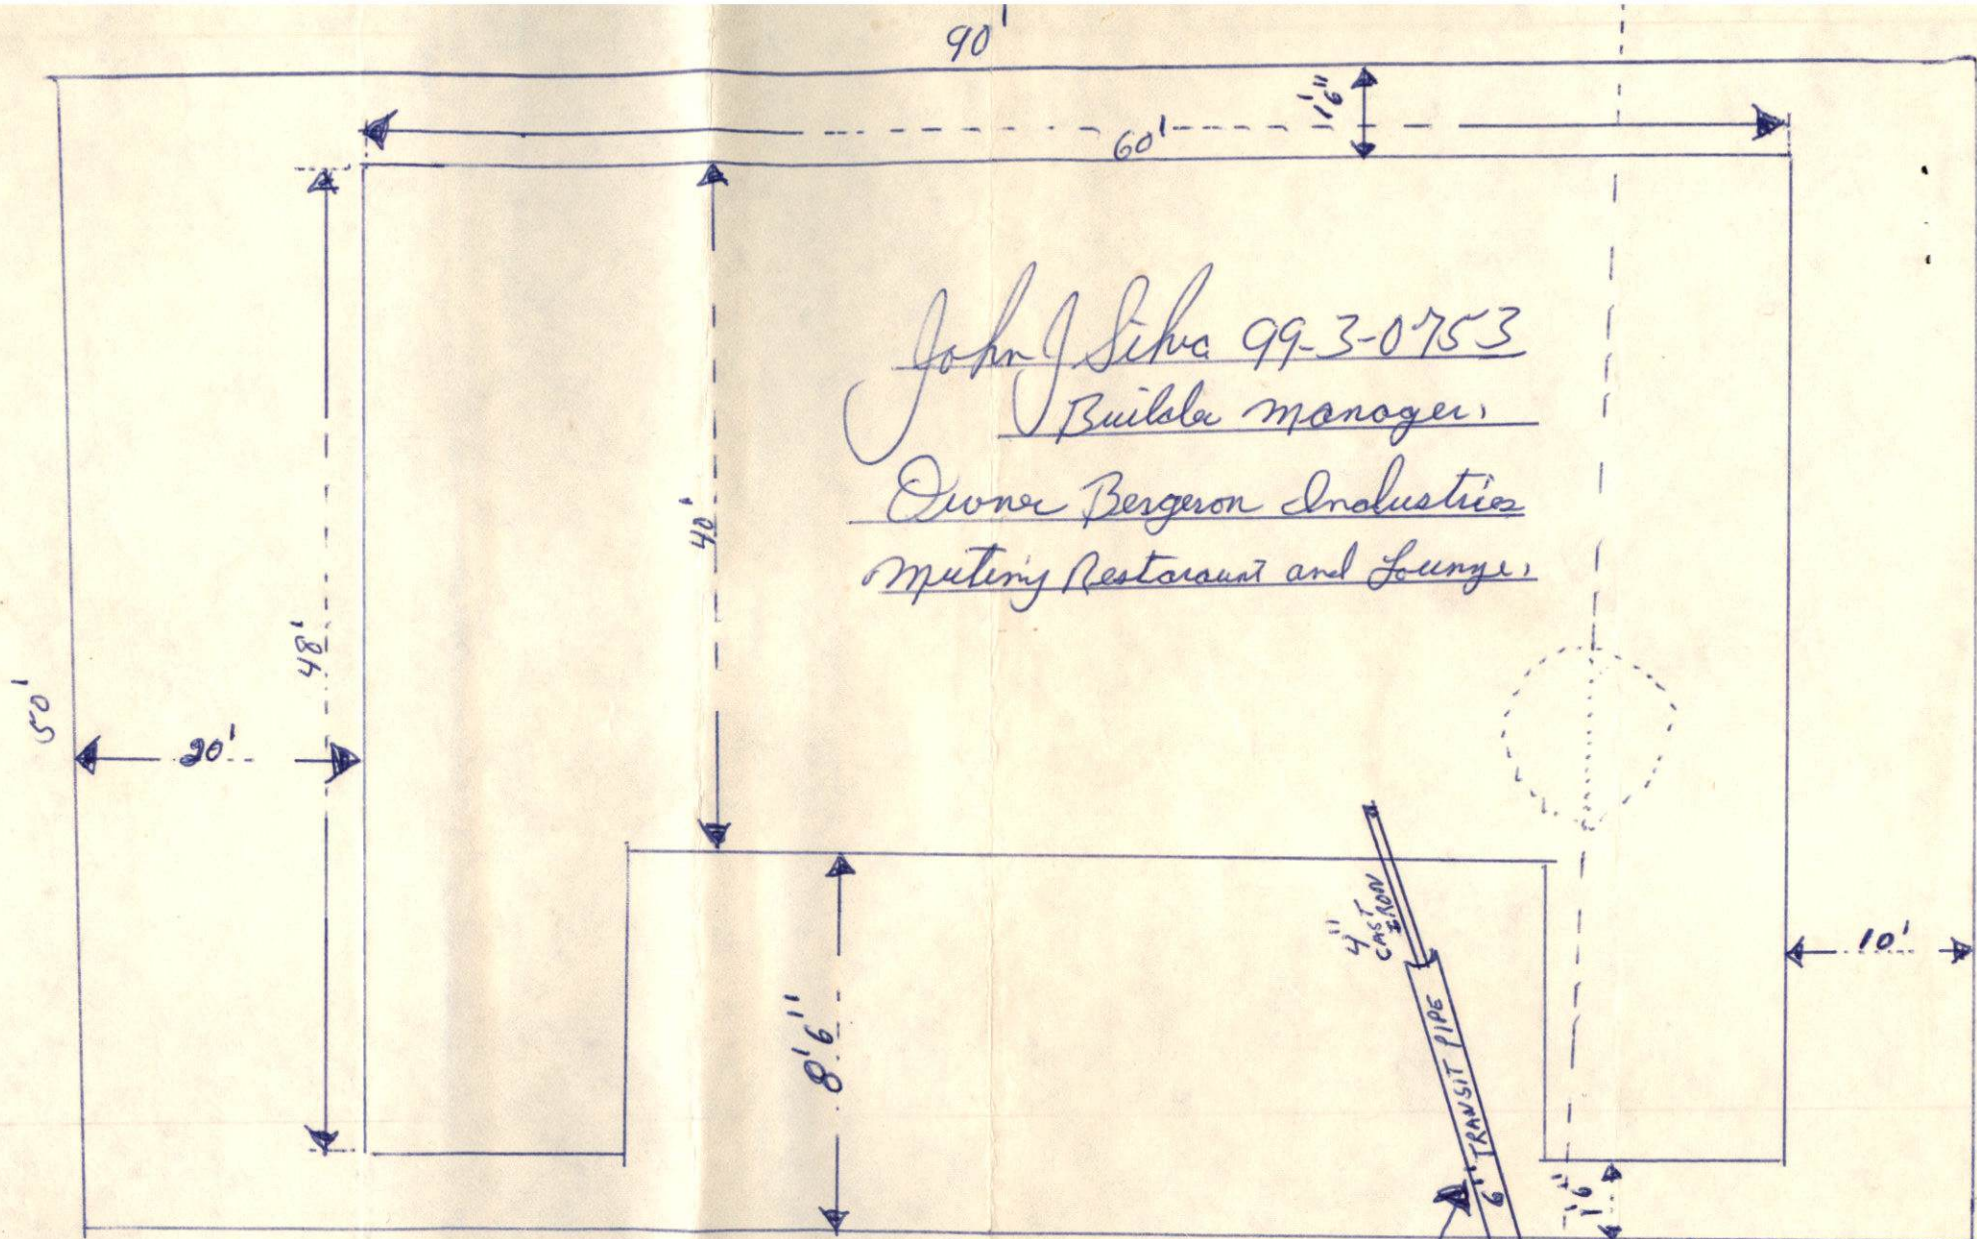

CURB or street line


NOTE



TRANSIT PIPE TIE IN
APPROX. 5' BELOW STREET GRADE

EXISTING
MAN HOLE

EXISTING
SEWER
FLOWING
SOUTH

Plot #53
LOT. 252

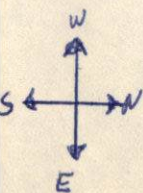

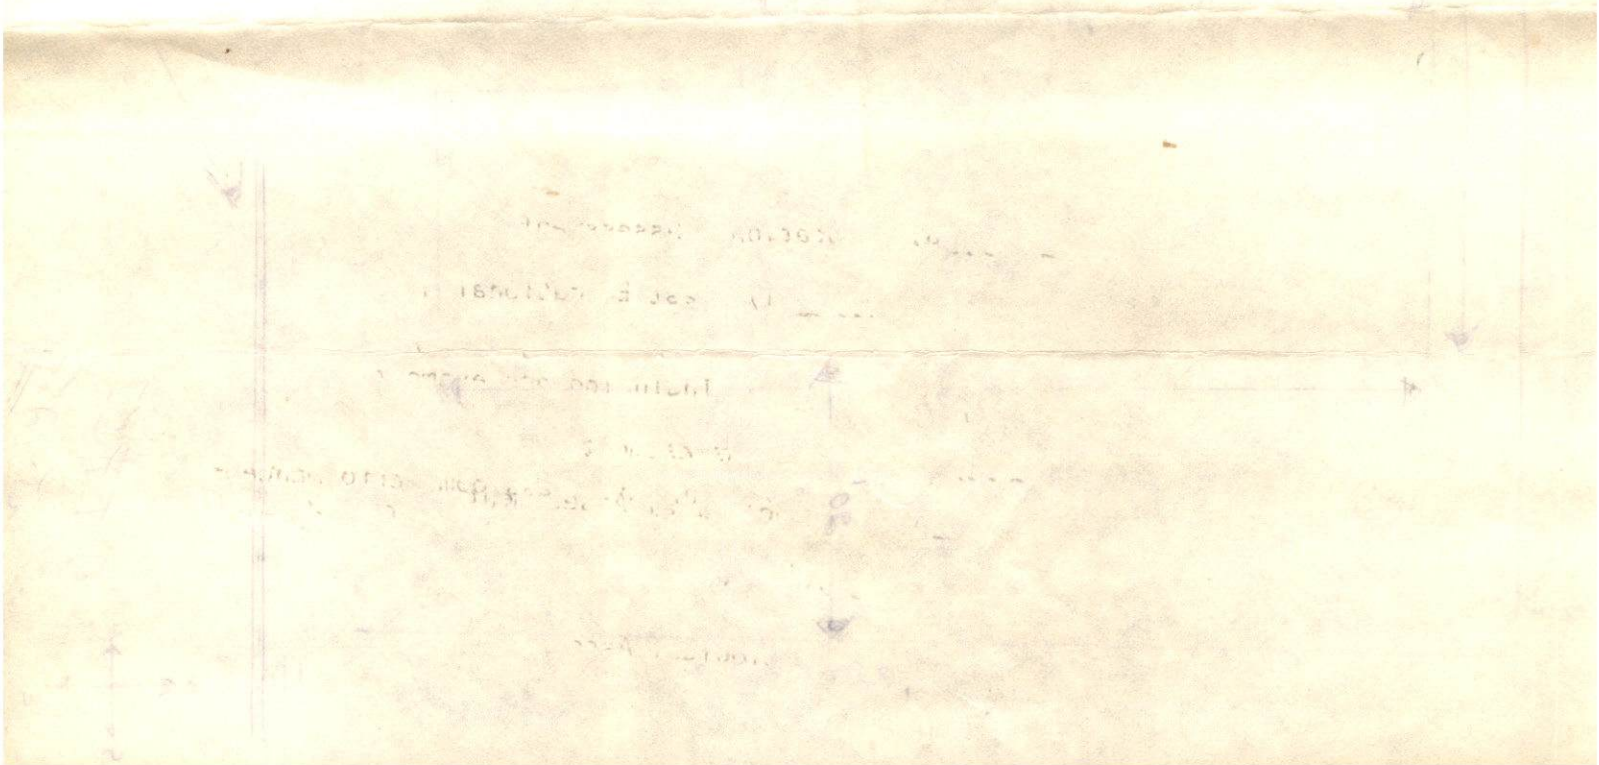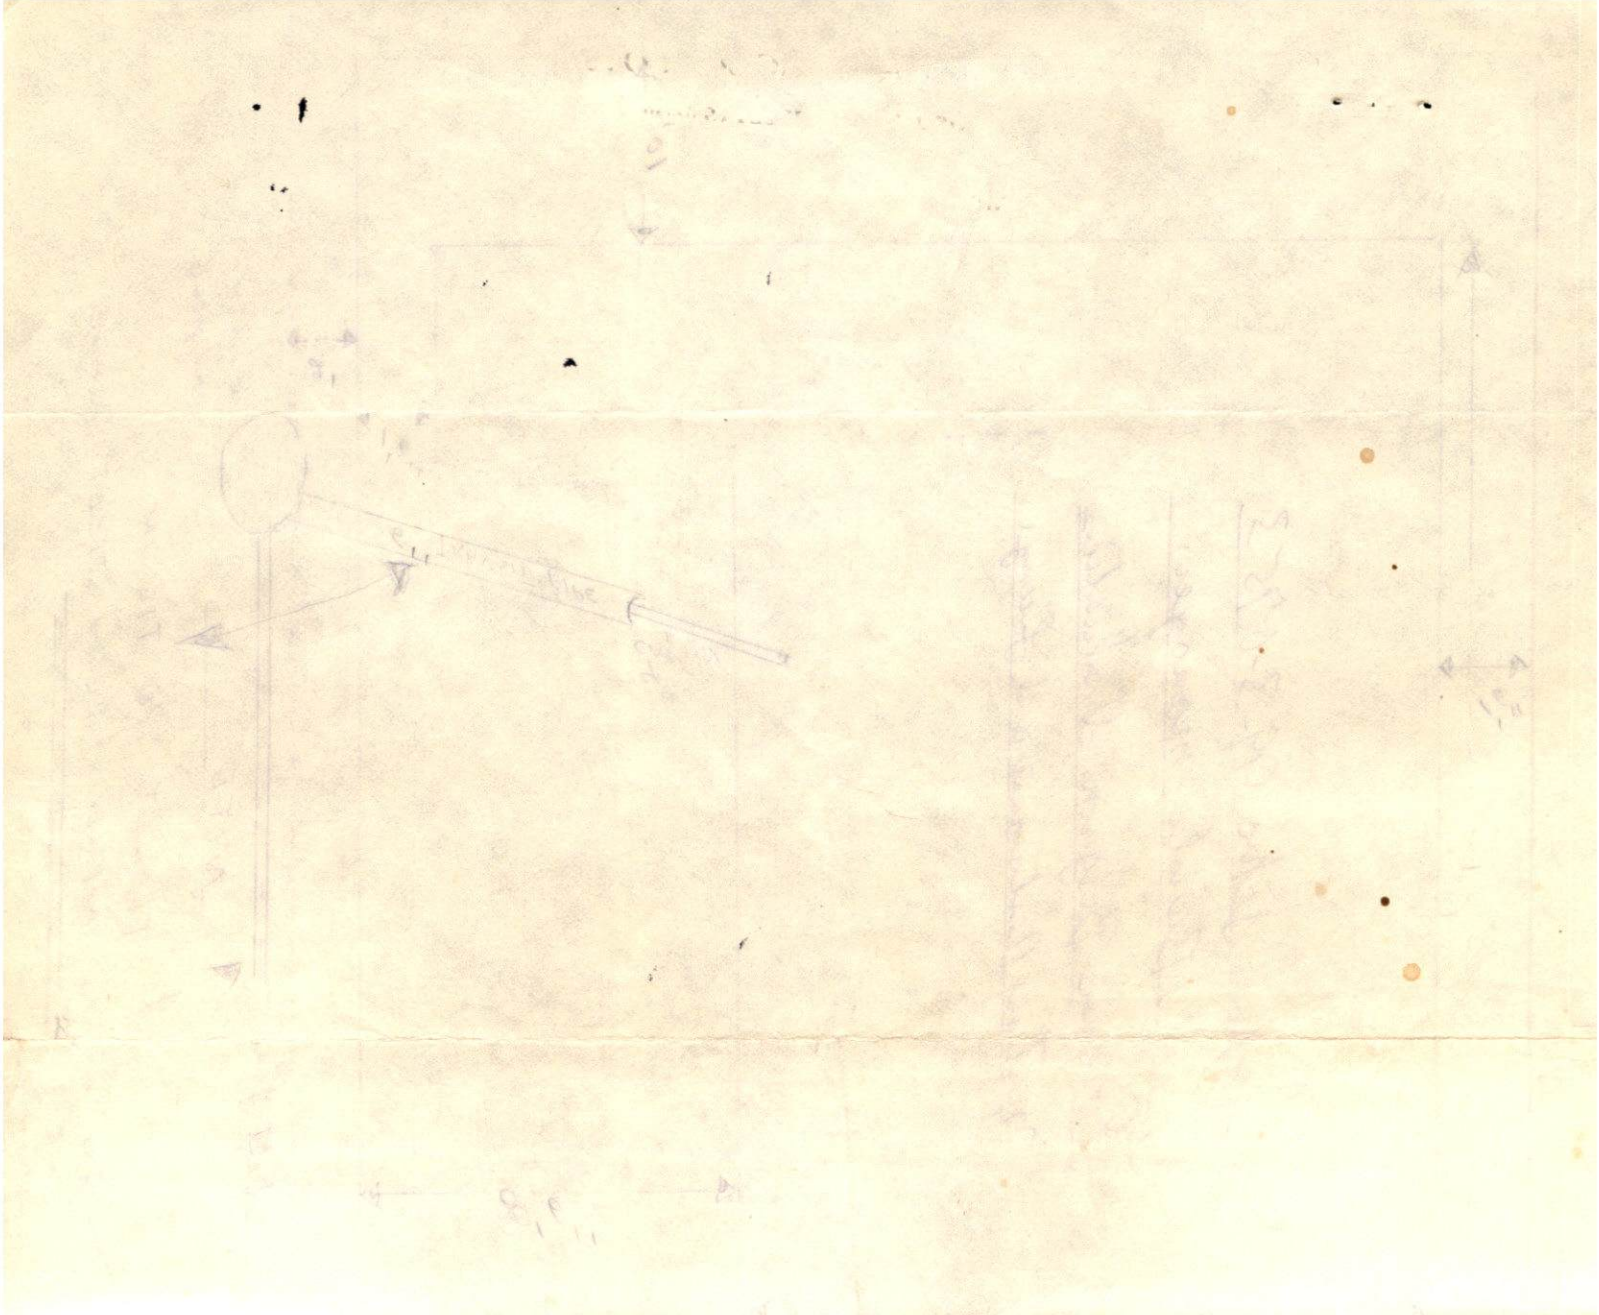

Permit No.

CITY OF NEW BEDFORD
DEPARTMENT OF PUBLIC WORKS

Supplementary Information Required from Commercial or
Industrial Firms in Addition to Issuance of Sewer Entrance Permit

- A. Architect's floor plan showing proposed connections to building drain (inside building):
B. Architect's detail drawings of any pretreatment or equalization equipment:
C. Site plan showing:

- (1) Building and location of building sewer
(2) Proposed connection to public sewer
(3) ~~Profile of building sewer~~
(4) ~~Plan and profile of storm drain~~
(5) Location of control manhole
(Standard type — preferably between property line and public sewer.)

D. Wastewater Information:

Date: 9/12/79

- (1) Name of firm: Mutiny Restaurant and Lounge
(2) Address: Rm 3+4 Rt 253. Phs 53.
(3) Name and title of person completing form. (company representative):
John J. Silva (manager) (also builder)
(4) Industry type (SIC Number):
(5) Number of Employees: 4- to 5- Per shift
(6) Principal products manufactured, produced, processed or sold: sandwiches and liquor
(7) Sources of water supply: Municipal ✓ Well
(8) Estimated volume of water to be used per day: 150-200 gallons.
(9) Flow gauges in plant influent effluent.
(10) Water consumed in processes: %.
(11) Recycled water: %.
(12) Cooling water: %.
(13) Number of operating days per week: 7 days
(14) Number of shifts per day: 3
(15) Type of discharge: continuous ✓ batch.
(16) If batch per shift.
(17) Estimated volume of wastewater discharged daily 100-150 gallons.
(18) Wastewater abatement practices to be used:

- (a) Process changes:
(b) Changes in raw materials:
(c) Recycling methods:
(d) Wastewater treatment equipment:
(e) Monitoring devices:
(f) Sampling and testing procedures:

(19) Expected constituents of final wastewater discharge:

- | | |
|---------------------|----------------------|
| (a) pH | (d) Cl Req'm't. mg/l |
| (b) Grease/Oil mg/l | (e) S. S. mg/l |
| (c) C O D mg/l | (f) Color mg/l |

(20)

Amund W. Berger
Signature of Property Owner

9-12-79
Date

RESOLUTION OF THE CITY COUNCIL

WHEREAS the City Council of the City of New Bedford

has received a petition from the undersigned

requesting that the City Council take certain action

in relation to the above described matter

the City Council do hereby resolve that

the petition be referred to the

Committee on the subject of

the petition of the undersigned

and that the City Council do hereby

authorize the City Clerk to

publish the following resolution

that the City Council do hereby

authorize the City Clerk to

publish the following resolution

that the City Council do hereby

authorize the City Clerk to

Bill .
9/13/79

IS OK AS LONG AS THEY

WILL INSTALL GREASE TRAP.

Jack T.

THIS FROM THE LIST TO



69

--	--	--

(MALE) (FEMALE) (SPAYED)
No. of Dogs

UNEMP
CODE

138 HSH BLVD

FOB LMAN