

# CITY OF NEW BEDFORD

## APPLICATION FOR LAYING BUILDING SEWER AND/OR DRAIN SERVICE

Application No 20546

Oct. 30, 1980  
Date

To the Mayor and City Council:

I hereby request that a building sewer and/or drain be laid for the premises at .....  
north side South Street, 210'± west of  
Hasey Street  
to connect with the sewer/drain in South street,  
the same to be laid in the street and the surface repaired as directed by the Commissioner of  
Public Works.

I hereby agree to pay at the office of the City Treasurer all cost of performing the above  
work in the manner specified, in excess of the deposit made herewith, within 10 days after the  
completion of the work.

It is understood and agreed that the deposit made with this application shall be applied  
to the payment of the cost of performing the work done, and that any excess of deposit over the  
cost shall be returned to me by the City Treasurer.

Witness Doreen D. Leite Vincent Rugginetta

RSY

Signature of Property Owner

Raymond Dargatzis

Address

Telephone No.

CONTR.

D & W WHITE CONS. CO.

RAY DARGATZIS

MIDDLE RD, ACUSH.

Plumber's Name

763-8364

PLMB

Requires separate entrance  
for roof water

Address

### Permits to Industrial and/or Commercial Applicants:

Permits can be issued to industrial and/or commercial applicants only upon receipt by  
the Commissioner of Public Works of such supplemental information as may be required by  
him concerning the quality and quantity of the proposed wastewater discharge.

This information was submitted by Vincent Rugginetta

Signature of Applicant (owner)

Raymond Dargatzis

and approved by the Commissioner of Public Works on

Date

George H. Brightman

Commissioner of Public Works

ddl

### Estimate and Deposit Requirement

Office of Commissioner of Public Works, 10/30/80

My estimate of the cost of laying the building sewer and/or drain described in the above  
application is .....

Assessed

Entrance charges

Total deposit required

\$15.00

George H. Brightman

Commissioner of Public Works

ddl

### Certificate of Issue


Office of City Clerk, Oct. 30, 1980

The above application, accompanied by City Treasurer's receipt presented this day;  
whereupon Permit No. 20546 was issued, and the Commissioner of Public Works  
notified of the same.

Juice A. Davidian  
City Clerk ddl

Laid from main in street to property line.  
Owner agrees to supply all necessary mater-  
ials and ..... pipe.

Insp. only. D. & W. White Cons. Corp. to perform all work.  
S.D. Conn. to S.D. in street w. of sewer location, 2nd S.D.  
Conn. to C. B. on w. side Hasey Street n. of South Street.

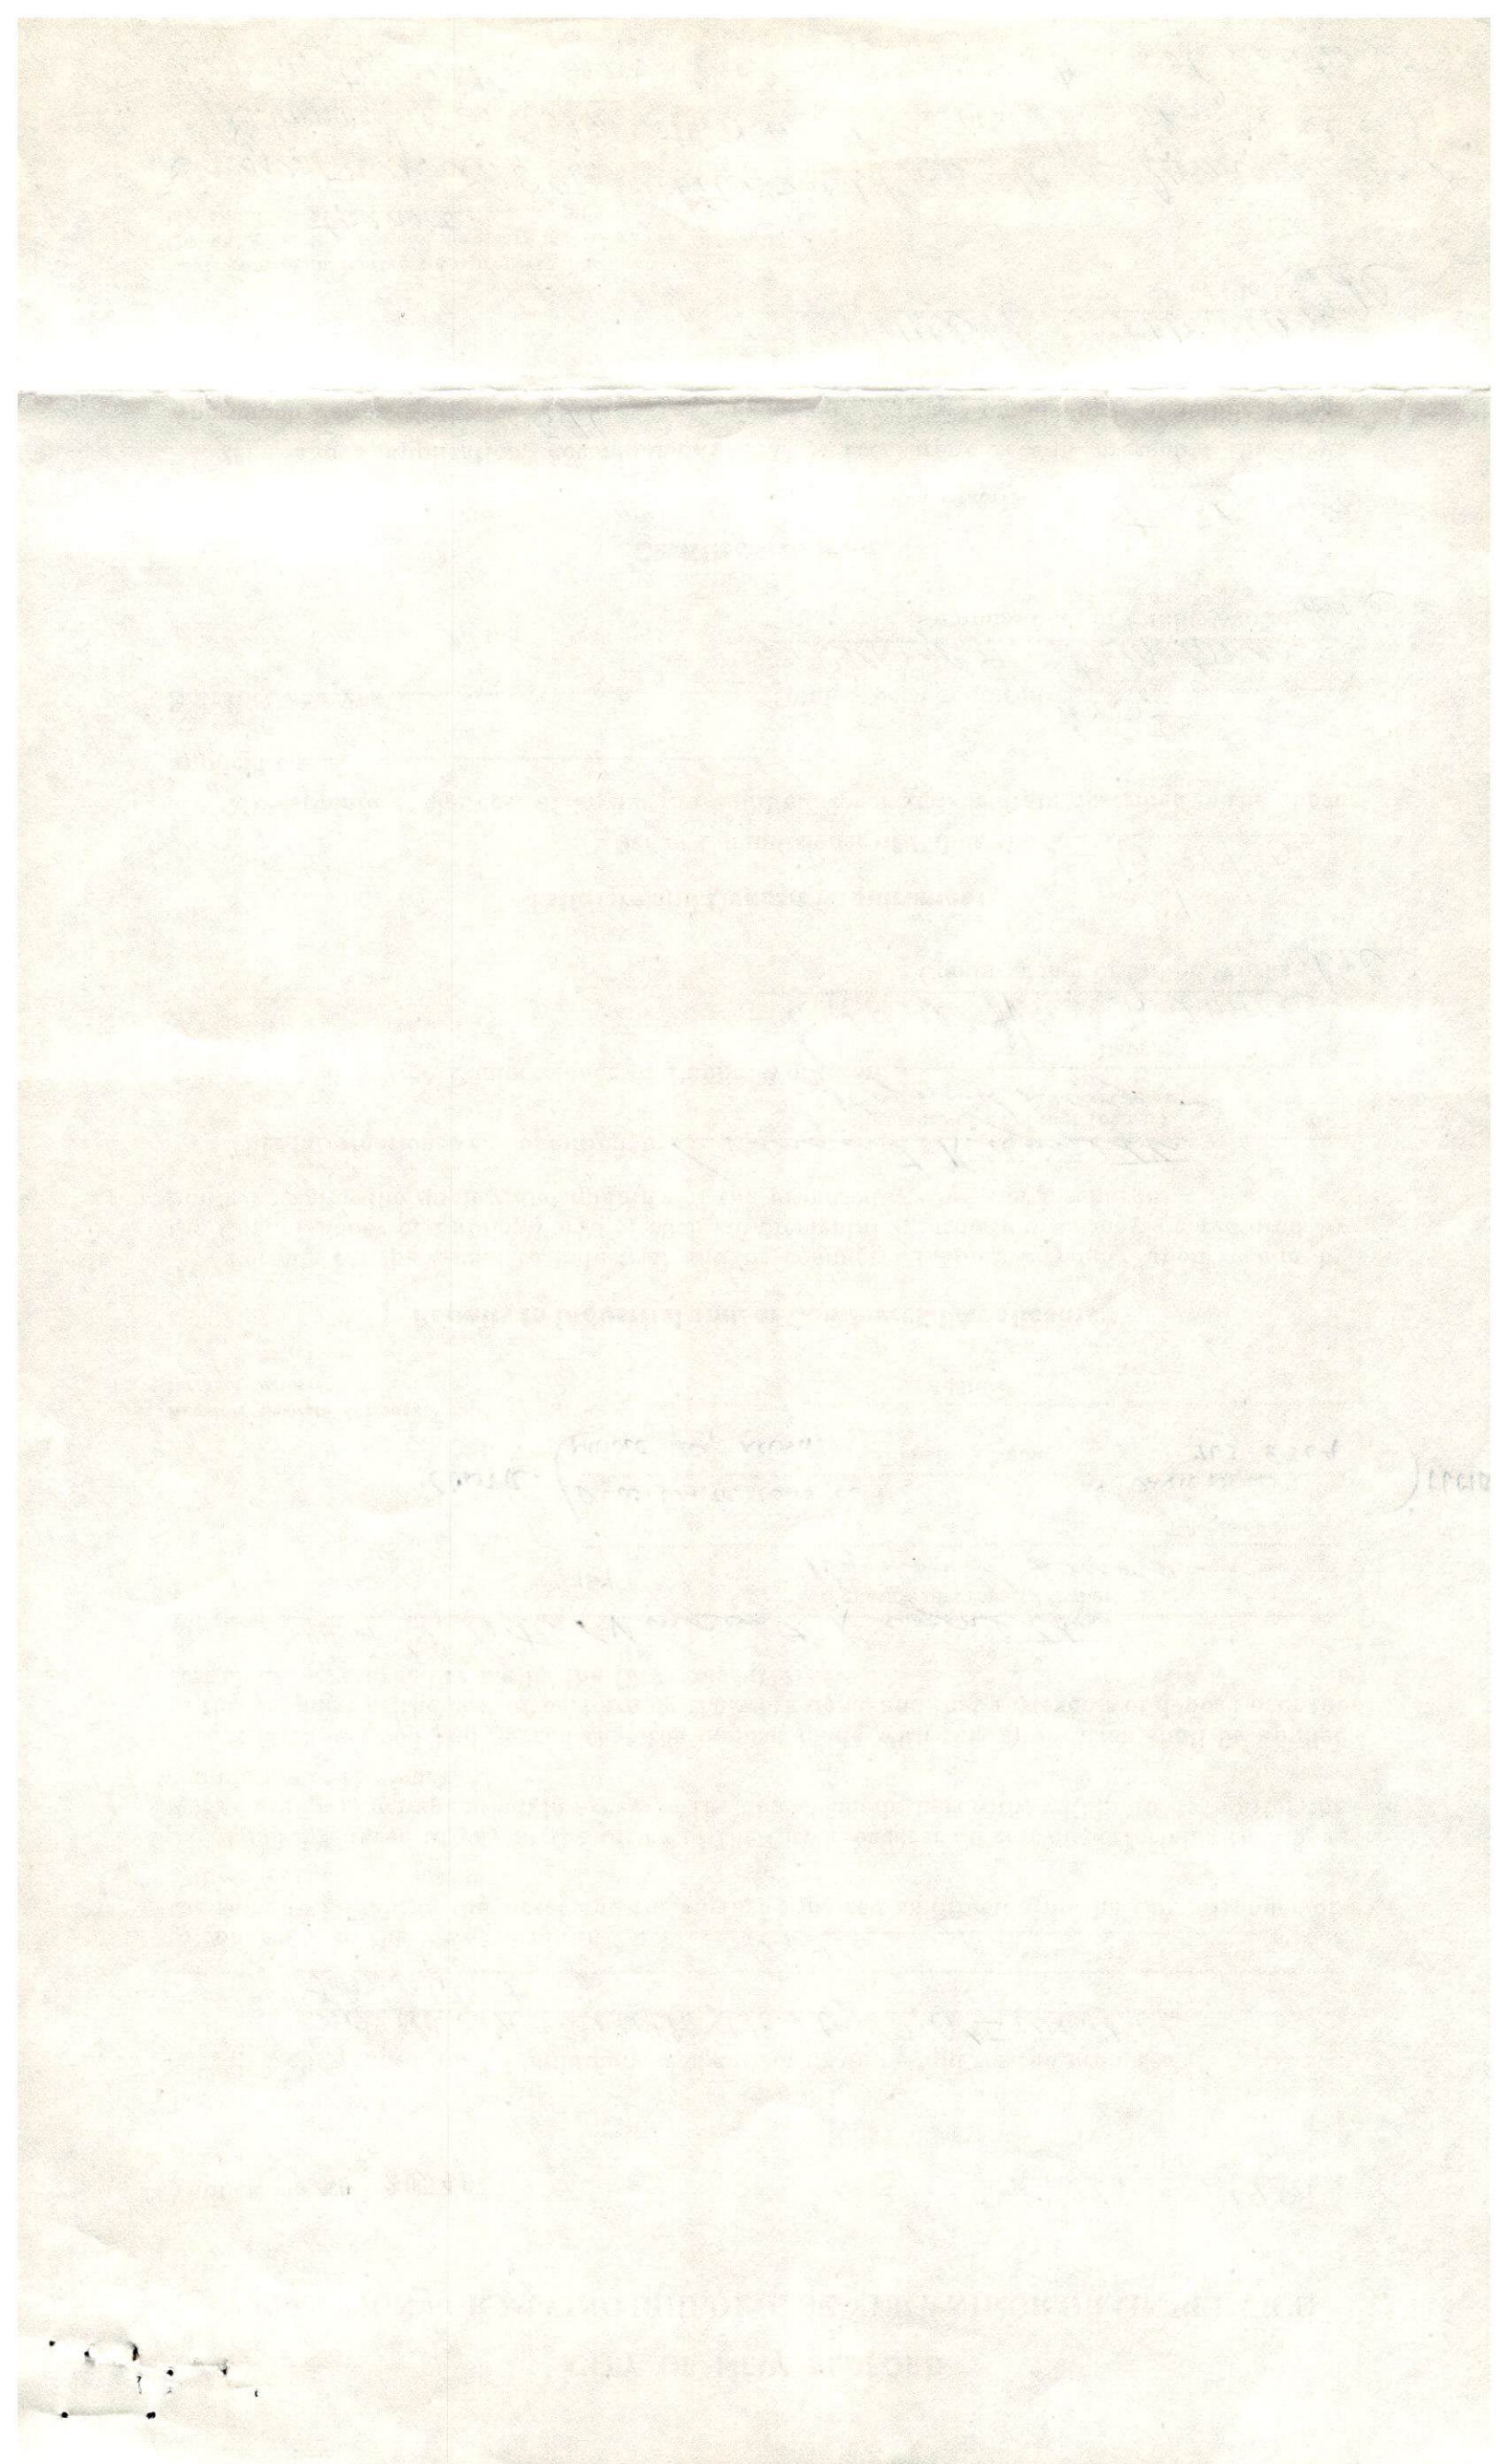



Tel. 617 / 999-2354

Telex 92-7571

# *Pilgrim Fish Corp.*

P. O. Box E-735

New Bedford, Massachusetts 02742

October 8, 1980

City of New Bedford  
Sewer Department  
New Bedford, Mass.

I hereby authorize Raymond Davignon, on  
behalf of Pilgrim Fish Corporation to sign the  
Sewer Permit for the new building located at  
South Terminal, New Bedford Parcel 4B & 4C.

VINCENT T. RUGNETTA

Treasurer

jas

100

100

100

100

Permit No. 20546

CITY OF NEW BEDFORD  
DEPARTMENT OF PUBLIC WORKS

Supplementary Information Required from Commercial or  
Industrial Firms in Addition to Issuance of Sewer Entrance Permit

- ✓ A. Architect's floor plan showing proposed connections to building drain (inside building):  
B. Architect's detail drawings of any pretreatment or equalization equipment:

C. Site plan showing:

- ✓ (1) Building and location of building sewer  
✓ (2) Proposed connection to public sewer  
? (3) ~~Profile of building sewer~~  
? (4) Plan and profile of storm drain  
✓ (5) Location of control manhole  
(Standard type — preferably between property line and public sewer.)

D. Wastewater Information:

Date: \_\_\_\_\_

- ✓ (1) Name of firm: Pelgrim Fish  
✓ (2) Address: Haver St  
✓ (3) Name and title of person completing form. (company representative):  
Raymond Davigian (Plumber)  
(4) Industry type (SIC Number): \_\_\_\_\_  
✓ (5) Number of Employees: 5  
(6) Principal products manufactured, produced, processed or sold: \_\_\_\_\_  
Ware House FOR WHAT? FISH? COLD STORAGE?  
✓ (7) Sources of water supply: Municipal ✓ Well \_\_\_\_\_  
? (8) Estimated volume of water to be used per day: 15 gallons.  
✓ (9) Flow gauges in plant meter influent \_\_\_\_\_ effluent.  
✓ (10) Water consumed in processes: none %.  
✓ (11) Recycled water: none %.  
✓ (12) Cooling water: none %.  
✓ (13) Number of operating days per week: 5  
✓ (14) Number of shifts per day: 1  
? (15) Type of discharge: \_\_\_\_\_ continuous \_\_\_\_\_ batch.  
(16) If batch \_\_\_\_\_ per shift.  
? (17) Estimated volume of wastewater discharged daily 15 gallons.  
(18) Wastewater abatement practices to be used:

(a) Process changes: \_\_\_\_\_

(b) Changes in raw materials: \_\_\_\_\_

(c) Recycling methods: \_\_\_\_\_

(d) Wastewater treatment equipment: \_\_\_\_\_

(e) Monitoring devices: \_\_\_\_\_

(f) Sampling and testing procedures: \_\_\_\_\_

(19) Expected constituents of final wastewater discharge:

- |                           |                            |
|---------------------------|----------------------------|
| (a) pH _____              | (d) Cl Req'm't. _____ mg/l |
| (b) Grease/Oil _____ mg/l | (e) S.S. _____ mg/l        |
| (c) C O D _____ mg/l      | (f) Color _____ mg/l       |

(20) Raymond Davigian  
Signature of Property Owner \_\_\_\_\_ Date \_\_\_\_\_

WASTEWATER DIVISION - D.P.W.  
FORT RODMAN  
NEW BEDFORD, MASS. 02744  
10-16-80 JT

