

CITY OF NEW BEDFORD

APPLICATION FOR LAYING BUILDING SEWER AND/OR DRAIN SERVICE

Application **Nº 20612**

Sept 4 1981
Date

To the Mayor and City Council:

I hereby request that a building sewer and/or drain be laid for the premises at

Elm Street n.s.
75' E. of Eighth Street
to connect with the sewer/drain in Elm street,
the same to be laid in the street and the surface repaired as directed by the Commissioner of
Public Works.

I hereby agree to pay at the office of the City Treasurer all cost of performing the above
work in the manner specified, in excess of the deposit made herewith, within 10 days after the
completion of the work.

It is understood and agreed that the deposit made with this application shall be applied
to the payment of the cost of performing the work done, and that any excess of deposit over the
cost shall be returned to me by the City Treasurer.

Witness D. Donaruth

(John A. Felli)

Signature of Property Owner

PO BOX 342 WEST SPRINGFIELD MA 01090

Address

Telephone No. 413 737-3307

Plumber's Name

Requires separate entrance
for roof water

Address

Permits to Industrial and/or Commercial Applicants:

Permits can be issued to industrial and/or commercial applicants only upon receipt by
the Commissioner of Public Works of such supplemental information as may be required by
him concerning the quality and quantity of the proposed wastewater discharge.

This information was submitted by see above
Signature of Applicant (owner)

and approved by the Commissioner of Public Works on
Date

Commissioner of Public Works

Estimate and Deposit Requirement

Office of Commissioner of Public Works, Sept 4 1981

My estimate of the cost of laying the building sewer and/or drain described in the above
application is

Assessed

Entrance charges Total deposit required \$ 50.00

George H. Burtman
Commissioner of Public Works

Certificate of Issue

Office of City Clerk, Sept 4 1981

The above application, accompanied by City Treasurer's receipt presented this day;
whereupon Permit No. was issued, and the Commissioner of Public Works
notified of the same.


Janice A. Davidson
City Clerk

Laid from main in street to property line.
Owner agrees to supply all necessary mater-
ials and transmits art. V pipe.

Inspection Only - Connect to existing stack at
property line.

CONNECT S.D. TO C.B. SO. SIDE MIDDLE ST. DW. WHITE TO PERFORM WORK

9-25-81

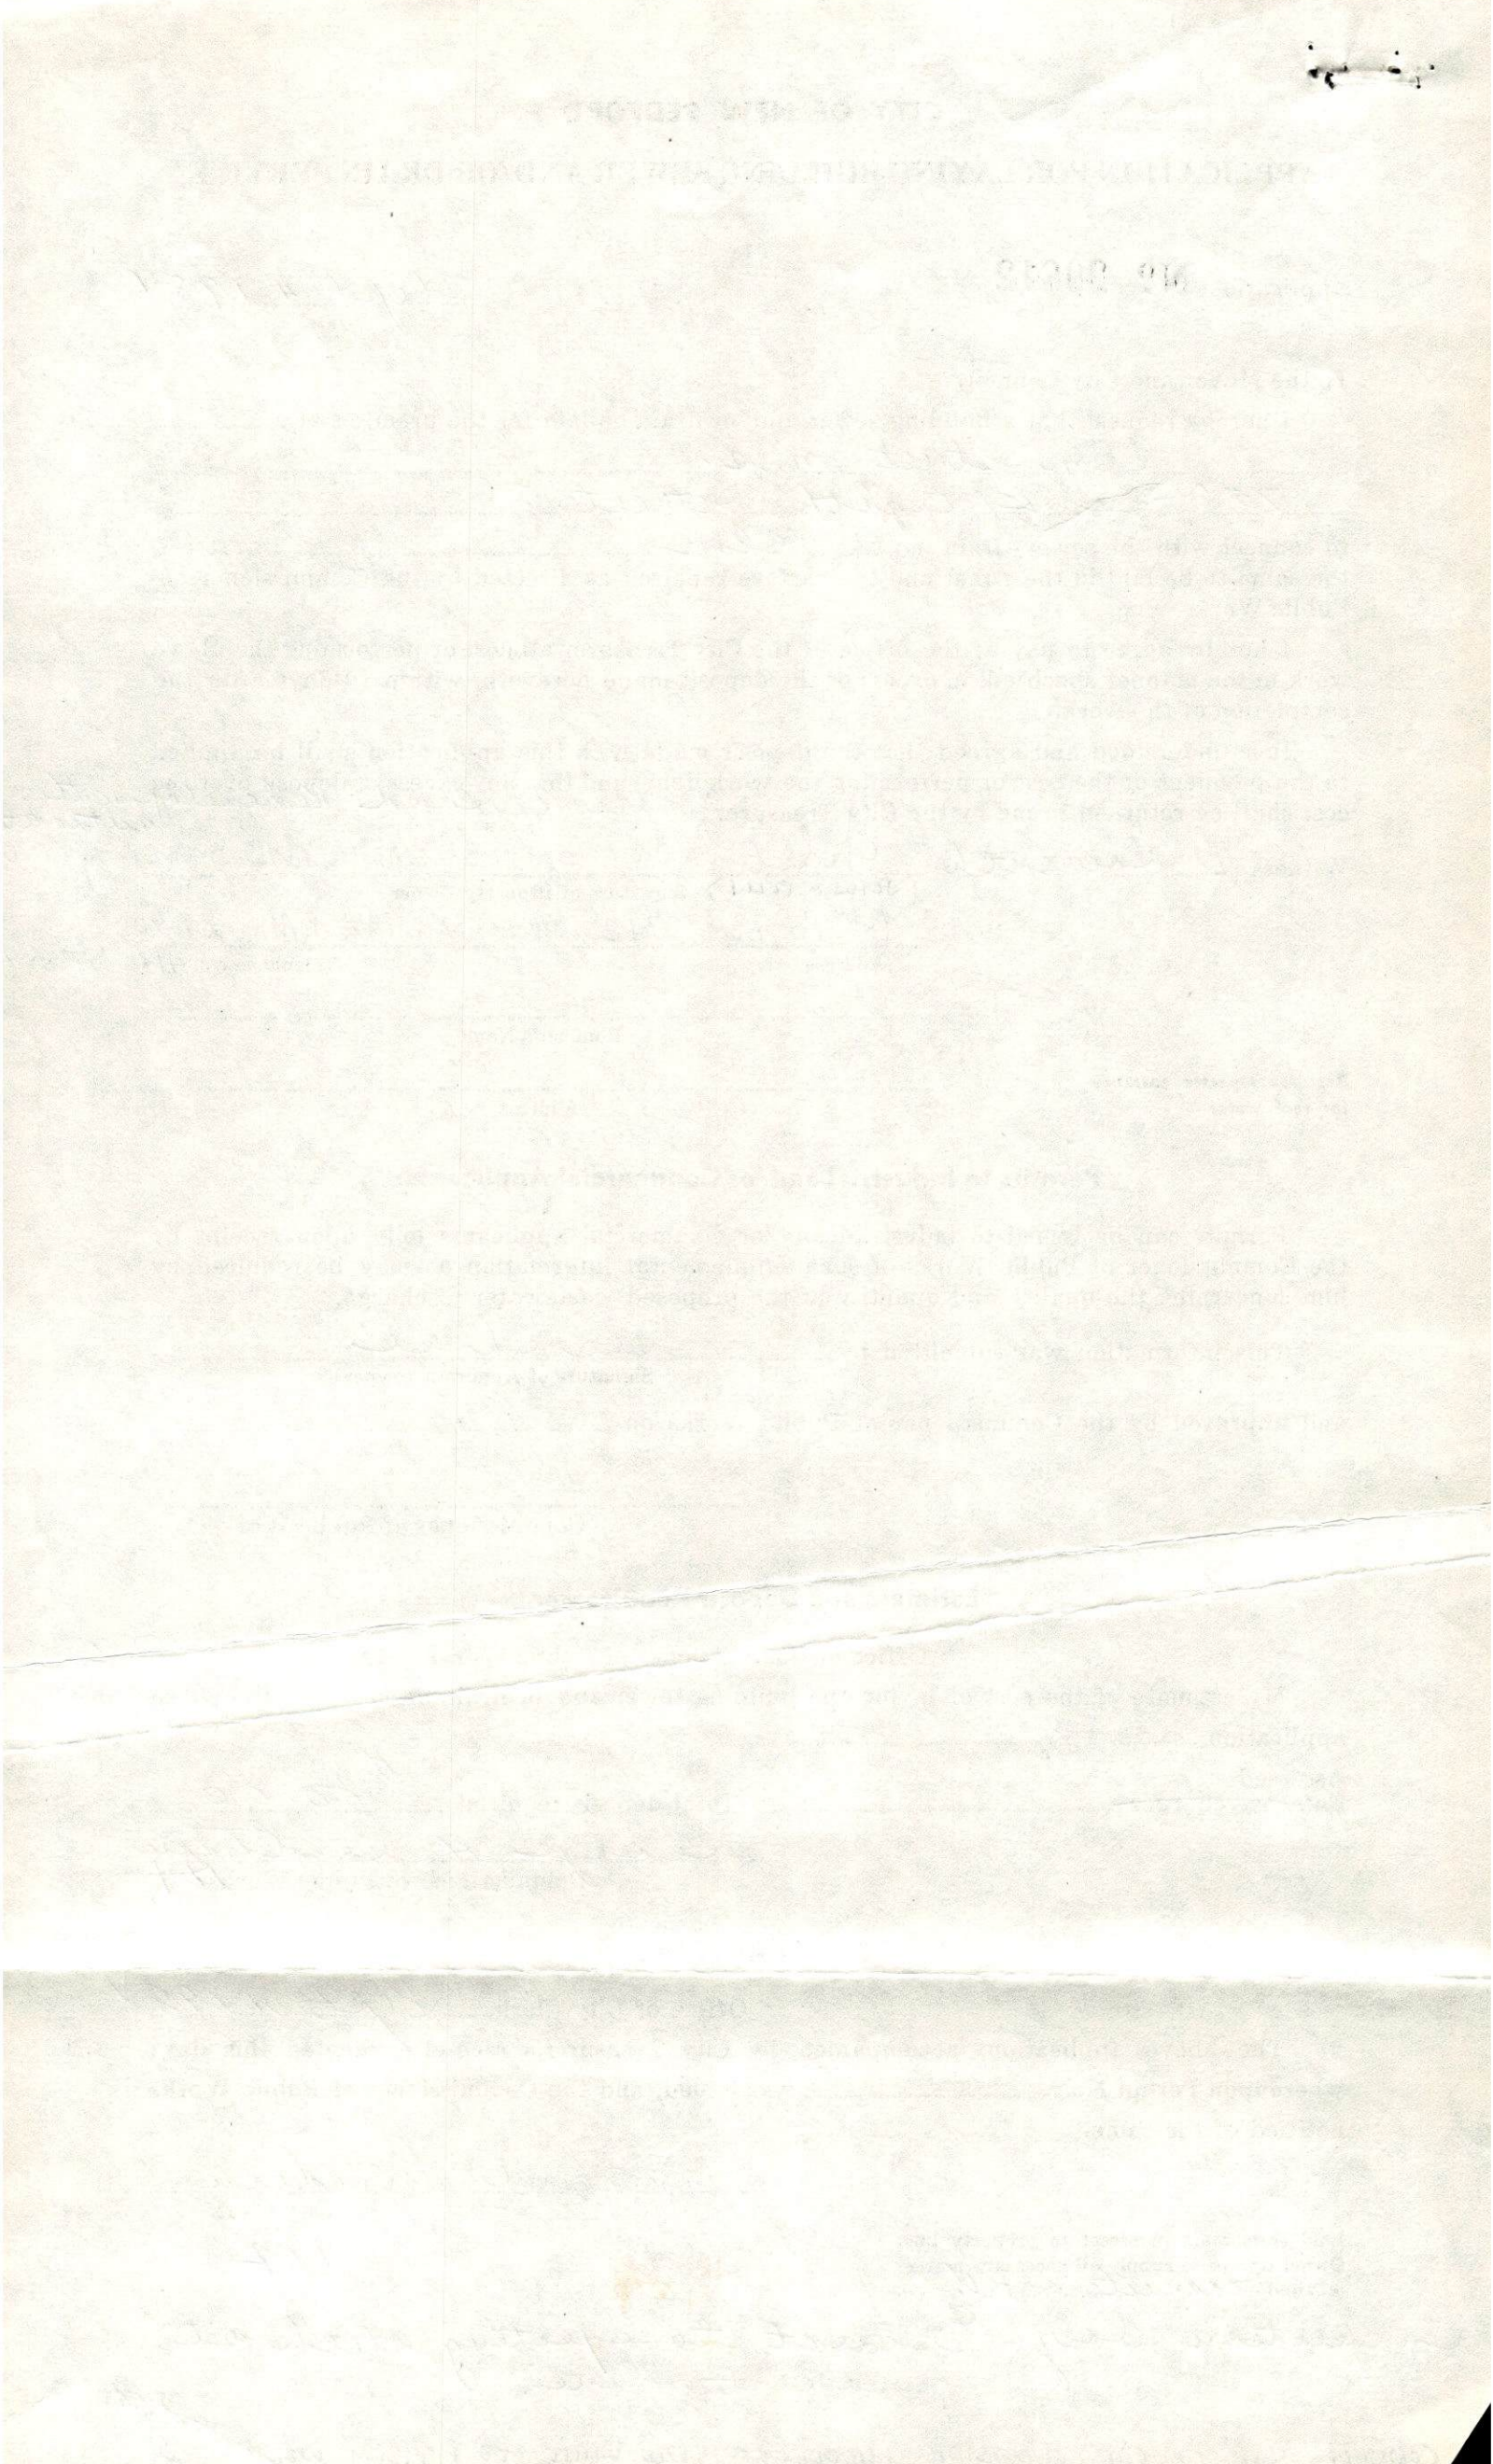

Southeastern Contracting & Engineering, Inc.

23 Summer Street

XXXXXXXXXXXXXXXXXXXX 251 Faunce Corner

Fairhaven, Massachusetts 02719

(617) 993-8596

Phil Bargioni



