### CITY OF NEW BEDFORD

# APPLICATION FOR LAYING BUILDING SEWER AND/OR DRAIN SERVICE

Application Nº 20752	7-9-83 Date
To the Mayor and City Council:	
	ding sewer and/or drain be laid for the premises at
	ASE ST S. OF CAMPBELL ST.
34.3	
to connect with the sewer drain the same to be laid in the street Public Works.	in PURCHASE ST street, and the surface repaired as directed by the Commissioner of
I hereby agree to pay at the work in the manner specified, in completion of the work.	e office of the City Treasurer all cost of performing the above excess of the deposit made herewith, within 10 days after the
to the payment of the cost of percost shall be returned to me by t	
Witness Dell Ducher	CLASER C-LASS CO.
	Signature of Froperty Owner
	1265 PURCHASE ST.
	Address Telephone No.
	Address PETER DUFF Film JOHN Telephone No. Plumber's Name
	그 모르고 있다. 그런 그 모든 프랑이를 하는 얼마나면 하면 하는 그 일반을 들어 하는 것이 없는 그 것이 없는 것이 없는 그 것이 없다는 것이 없는 것이 없는 것이 없는 것이 없는 것이 없는 것이 없다.
Requires separate entrance for roof water	135 TINUHAM ST Address
Permits to Ir	ndustrial and/or Commercial Applicants:
the Commissioner of Public Wor him concerning the quality and	dustrial and/or commercial applicants only upon receipt by the such supplemental information as may be required by quantity of the proposed wastewater discharge.
	Signature of Applicant (owner)
and approved by the Commission	oner of Public Works on
	Date
	Commissioner of Public Works
Est	imate and Deposit Requirement
	Office of Commissioner of Public Works, 7-9-93
My estimate of the cost of	laying the building sewer and/or drain described in the above
application is50	
Aggaggad	
Entrance charges	Total deposit required
	Total deposit required
	Certificate of Issue
_	Office of City Clerk, #77-83
The above application, ac	ecompanied by City Treasurer's receipt presented this day;
	was issued, and the Commissioner of Public Works
notified of the same.	( ) - h - n .
	James Dauslesin
Laid from main in street to property	City Clerk
Owner agrees to supply all necessary ma	line.
ials and	ter-

D. P. W. INSPECTOR BEFORE BACKFILLING

gringer between reducant type her med of a company here each a pollution is being being transpiración Agrapalet Cras accordos 

the Rose of Contract

The American Tenner Transfer and American Street Street Street Street Street Street Street Street Street Street

the state of the s


Permit No. 20752-83

### CITY OF NEW BEDFORD DEPARTMENT OF PUBLIC WORKS

Supplementary Information Required from Commercial or Industrial Firms in Addition to Issuance of Sewer Entrance Permit

A. Archite	ect's floor plan showing proposed connections to building drain (inside building):							
B. Archite	Architect's detail drawings of any pretreatment or equalization equipment:							
C. Site pla	an showing:							
= (1)	Building and location of building sewer							
(3)	Proposed connection to public sewer  Profile of building sewer							
<b>(4)</b>	Plan and <del>profile</del> of storm drain							
(5)	Location of control manhole							
<b>S</b> W .	(Standard type — preferably between property line and public sewer.) water Information:  Date: 12/5/83							
	water Information:  Name of firm: 6(> < C(> < C() < C(							
(1)	Address 1765 Perchase ST							
(2)								
(3)	Name and title of person completing form. (company representative):							
	Costre-ulite les Dienlite Consi							
(4)	Industry type (SIC Number):							
<b>(5)</b>	Number of Employees:							
(6)	Principal products manufactured, produced, processed or sold:							
	tusiza Elsec							
(7)	Sources of water supply: Municipal Well							
(8)	Estimated volume of water to be used per day: gallons. Rein estimated							
(9)	Flow gauges in plant influent effluent.							
(10)	Water consumed in processes: No Wote Draw Ares							
<b>(11)</b>	Desirated water. With							
(12)	Cooling water:							
(13)	Number of operating days per week:							
(14)	Number of shifts per day:							
(15)	Type of discharge: continuous batch.							
(16)	If batch per shift.							
(17)	Estimated volume of wastewater discharged daily							
(18)	Wastewater abatement practices to be used:							
(10)	(a) Process changes:							
	(h) Changes in row metarials							
	(b) Changes in raw materials:							
	( ) D = 1 = 1							
	(c) Recycling methods:							
	(d) Wastewater treatment equipment:							
	(e) Monitoring devices:							
	(f) Sampling and testing procedures:							
(19)	Expected constituents of final wastewater discharge:							
(13)	(a) pHmg/l							
	(a) phmg/l  (b) Grease/Oilmg/l  (e) S. Smg/l							
(20)	Ceuse 12/15/93							
	Signature of Property Owner (ALVIN GLASIER) Date							

Signature of Property Owner (ALVIN GLASIER)

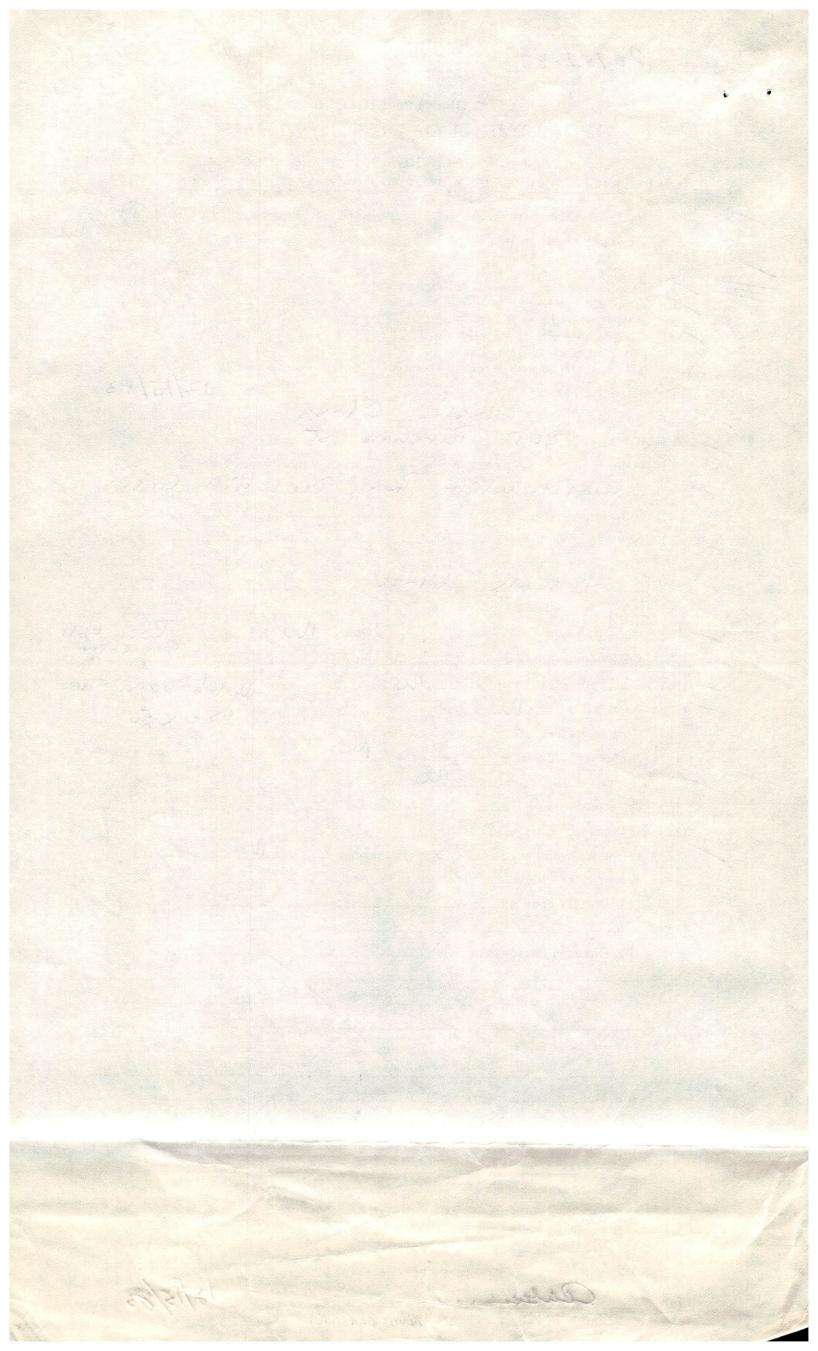

#### TELEPHONE (AREA CODE 617) 999-6497 676-0444

FALL RIVER BRANCH: 233 PRESIDENT AVE. 676-1464

## MORRIS GLASER GLASS CO.

AUTOMOTIVE GLASS DISTRIBUTORS
COMPLETE PLATE GLASS REPLACEMENT SERVICE

U 11354

1265 PURCHASE ST., NEW BEDFORD, MASS. 02740 OPPOSITE DOWNTOWN EXIT									
SOLD	ADDRES	SS					CUSTOMER N	9-83 OMBER	
0	CITY						CUSTOMER'S	ORDER NO.	
SHIP	ADDRES	SS							
0	CITY (								
SPEC	IAL INS	TRUCTIONS					WRITTEN B	CASH CHG.	
Q	JAN PRD	PART NUMBER	DESC	RIPTION	QUAN. SHIP.	LIST	NET	AMOUNT	
	t	611	8 4	BIBI	RL	DUF	F		
	fo	3RM)	5550	10	AB	Ply	)NJ		
		URE	35/-1011	Ffor	RNJ	VRI	TICE		
	L	RAIN	CON	INIBC	non	DE		61	
				20	10	ben		8/9/	
			0	41011	164	13B			
			INVENTORY CONTROL	MERCHA			AMOUNT		
RECE	RECEIVED IN GOOD CONDITION BY:								

