

CITY OF NEW BEDFORD

APPLICATION FOR LAYING BUILDING SEWER AND/OR DRAIN SERVICE

Application **Nº 20851**

10-15-84  
Date

To the Mayor and City Council:

I hereby request that a building sewer and/or drain be laid for the premises at .....

281 Herman Melville Blvd.

to connect with the sewer/drain in Herman Melville Blvd. street,  
the same to be laid in the street and the surface repaired as directed by the Commissioner of  
Public Works.

I hereby agree to pay at the office of the City Treasurer all cost of performing the above  
work in the manner specified, in excess of the deposit made herewith, within 10 days after the  
completion of the work.

It is understood and agreed that the deposit made with this application shall be applied  
to the payment of the cost of performing the work done, and that any excess of deposit over the  
cost shall be returned to me by the City Treasurer.

Witness Corine J. Machado

Signature of Property Owner

Vincent Stancu

Address

281 HERMAN MELVILLE BLVD.

Telephone No.

992-5627

Plumber's Name

Joseph August

Requires separate entrance  
for roof water

Address

**Permits to Industrial and/or Commercial Applicants:**

Permits can be issued to industrial and/or commercial applicants only upon receipt by  
the Commissioner of Public Works of such supplemental information as may be required by  
him concerning the quality and quantity of the proposed wastewater discharge.

This information was submitted by .....

Signature of Applicant (owner)

and approved by the Commissioner of Public Works on .....

Date

Commissioner of Public Works

**Estimate and Deposit Requirement**

Office of Commissioner of Public Works, 10-15-84

My estimate of the cost of laying the building sewer and/or drain described in the above  
application is .....

Assessed

Entrance charges .....

Total deposit required \$30.00

Robert J. Canto

Commissioner of Public Works

**Certificate of Issue**

Office of City Clerk, 10-15-84

The above application, accompanied by City Treasurer's receipt presented this day;  
whereupon Permit No. 20851 was issued, and the Commissioner of Public Works  
notified of the same.

Janice A. Davidian

City Clerk

Laid from main in street to property line.  
Owner agrees to supply all necessary mater-  
ials and PVC 500-35 pipe.


insp. only: Joseph August to do all work







25627  
141 ROCKDALE AVE.  
NUVO FRANKO

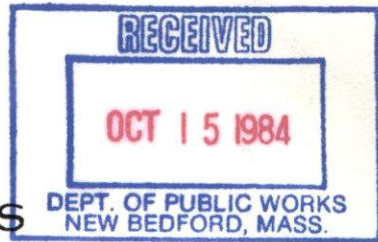

CITY OF NEW BEDFORD  
DEPARTMENT OF PUBLIC WORKS

Supplementary Information Required from Commercial or  
Industrial Firms in Addition to Issuance of Sewer Entrance Permit

A. Architect's floor plan showing proposed connections to building drain (inside building):

B. Architect's detail drawings of any pretreatment or equalization equipment:

C. Site plan showing:

- ☒ (1) Building and location of building sewer
- ☒ (2) Proposed connection to public sewer
- ☒ (3) Profile of building sewer
- ☒ (4) Plan ~~and profile~~ of storm drain
- ☒ (5) Location of control manhole  
(Standard type — preferably between property line and public sewer.)

D. Wastewater Information:

Date: 10/2/84

- ☒ (1) Name of firm: FRANCO & SONS
- ☒ (2) Address: 281 HERMAN MELVILLE BLVD., N.B., MA.
- ☒ (3) Name and title of person completing form. (company representative):  
NUVO FRANCO
- (4) Industry type (SIC Number): \_\_\_\_\_
- ☒ (5) Number of Employees: 3
- ☒ (6) Principal products manufactured, produced, processed or sold: REPAIRS TO MARINE ENGINES & STOCK PARTS FOR SAME
- ☒ (7) Sources of water supply: Municipal ☒ Well \_\_\_\_\_
- ☒ (8) Estimated volume of water to be used per day: 60 gallons.
- (9) Flow gauges in plant \_\_\_\_\_ influent \_\_\_\_\_ effluent.
- ☒ (10) Water consumed in processes: 0 %.
- (11) Recycled water: \_\_\_\_\_ %.
- (12) Cooling water: \_\_\_\_\_ %.
- ☒ (13) Number of operating days per week: 5
- ☒ (14) Number of shifts per day: 1
- ☒ (15) Type of discharge: \_\_\_\_\_ continuous \_\_\_\_\_ batch.
- (16) If batch \_\_\_\_\_ per shift.
- ☒ (17) Estimated volume of wastewater discharged daily 60 gallons.
- (18) Wastewater abatement practices to be used:
  - (a) Process changes: \_\_\_\_\_
  - (b) Changes in raw materials: \_\_\_\_\_
  - (c) Recycling methods: \_\_\_\_\_
  - (d) Wastewater treatment equipment: \_\_\_\_\_
  - (e) Monitoring devices: \_\_\_\_\_
  - (f) Sampling and testing procedures: \_\_\_\_\_
- (19) Expected constituents of final wastewater discharge:
  - (a) pH \_\_\_\_\_
  - (b) Grease/Oil \_\_\_\_\_ mg/l
  - (c) COD \_\_\_\_\_ mg/l
  - (d) Cl Req'm't. \_\_\_\_\_ mg/l
  - (e) S. S. \_\_\_\_\_ mg/l
  - (f) Color \_\_\_\_\_ mg/l

(20) Nuvo Franco  
Signature of Property Owner

10-2-84  
Date

SANITARY SEWAGE ONLY - NO FLOOR DRAINS, NO GREASING TANKS OR  
OTHER CHEMICAL DISCHARGE CONNECTIONS. 10-15-84 O.K.

