

CITY OF NEW BEDFORD

APPLICATION FOR LAYING BUILDING SEWER AND/OR DRAIN SERVICE

Application N^o 20860

11-2-84
Date

To the Mayor and City Council:

I hereby request that a building sewer and/or drain be laid for the premises at
north side of Westland Street, west of # 975
to connect with the sewer/drain in Westland street,
the same to be laid in the street and the surface repaired as directed by the Commissioner of
Public Works.

I hereby agree to pay at the office of the City Treasurer all cost of performing the above
work in the manner specified, in excess of the deposit made herewith, within 10 days after the
completion of the work.

It is understood and agreed that the deposit made with this application shall be applied
to the payment of the cost of performing the work done, and that any excess of deposit over the
cost shall be returned to me by the City Treasurer.

Witness
Signature of Property Owner
Address 981 Darling St, New Bedford, Ma. 998-1306
Telephone No.
Plumber's Name Ed Reynolds

Requires separate entrance
for roof water

Address

Permits to Industrial and/or Commercial Applicants:

Permits can be issued to industrial and/or commercial applicants only upon receipt by
the Commissioner of Public Works of such supplemental information as may be required by
him concerning the quality and quantity of the proposed wastewater discharge.

This information was submitted by
Signature of Applicant (owner)
and approved by the Commissioner of Public Works on
Date

Commissioner of Public Works

Estimate and Deposit Requirement

Office of Commissioner of Public Works, 11-2-84

My estimate of the cost of laying the building sewer and/or drain described in the above
application is

Assessed
Entrance charges Total deposit required
Commissioner of Public Works

Certificate of Issue

Office of City Clerk,

The above application, accompanied by City Treasurer's receipt presented this day;
whereupon Permit No. was issued, and the Commissioner of Public Works
notified of the same.

Laid from main in street to property line.
Owner agrees to supply all necessary mater-
ials and pipe.

City Clerk

Inspection Only. - contractor to perform all work
NO S.D. - enter M.H. east of flat in question

7

1000

1000

1000

112 S.I.I.

7.5' Top of Footing To
Top of Foundation

5.14 Rim Sewer M.H.
5.20 Rim Storm Drain M.H.
MANNY

9-13-84

43.5' E to face of fldn.
110.5 to SMH
6' BTW. MH.

6.12 SD INV
4.90 SD SHEET

CAN SURVEY CHECK FOR FEASIBILITY OF NEW
SEWER CONNECTION FOR:

N.S. WESTLAND ST. 230-240' ± E. OF
ACUSH. AVE., TO ENTER M.H. IN WESTLAND
ST., OPP. EASEMENT W. OF MORRIS ST.


#996 Westland St.
Menden
DW White Contr.
Oct 1983
S.S.D. Patch CO. MIX

Plot 127-E

NORWOOD

?

ACUSHNET AVE.

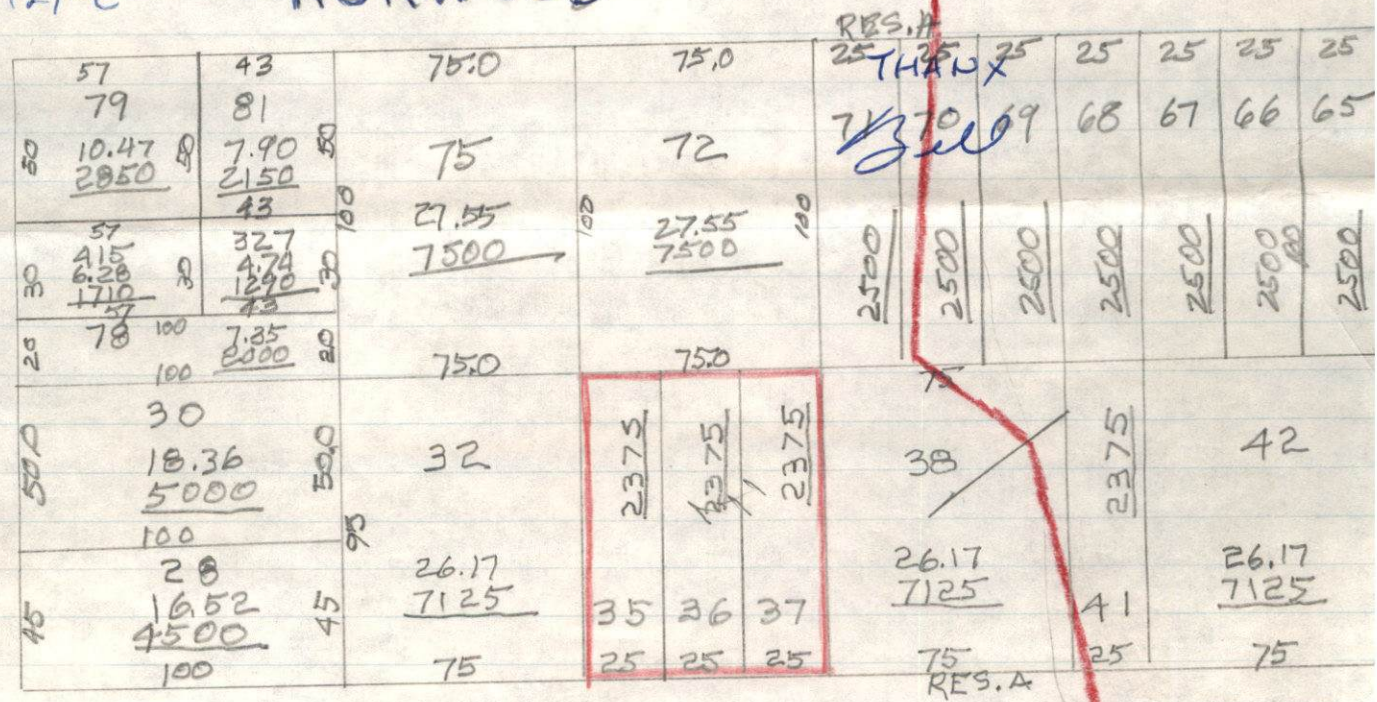

WESTLAND ST.

9-15-9

MAINE

(AND SURVEY CHECK THE FEASIBILITY OF NEW)

NEW CONSTRUCTION FOR

M. J. WESTLAND ST. 620-5401 E. OF
NORTH. 400' TO NORTH. 14.11 IN WESTLAND ST.
ST. 699. 0.000000 10.01. 0.000000

NORWICH

WESTLAND