



CITY OF NEW BEDFORD

APPLICATION FOR CONNECTION TO
PUBLIC SANITARY SEWER AND/OR STORM DRAINApplication No. N^o 21391

Date 6-29-87

The undersigned hereby requests permission to connect a building sanitary and/or storm sewer from the premises located at 342 Hathaway Potter St S.S. At Hathaway Blvd....., Assessors' Plot 82.....
Lot 104....., to the public sanitary/storm sewer(s) in Potter St.....
Street
the same to be installed in accordance with the terms and conditions set forth herein, and the ordinances of the City of New Bedford.

Name of Property Owner: Hathaway-Potter Realty Trust Tel. 697-8044 or 8078
Please Print

Owner's Mailing Address: 30 Fox Hill Dr Bridgewater, MA 02324

If application is being submitted by other than actual property owner, indicate that person's

Name: Tel.

Mailing Address:

and attach Letter of Authorization from Property Owner hereto.

BONDED CONTRACTOR OR DRAIN LAYER MAKING INSTALLATION

Name: Reis Asphalt MARCELLO CONS. Tel. 295-6201
44 CUMWOOD Rd NEW BEDFORD, MA 02740
Address: P.O. Box 205, Bourne, MA 02532

JOINT MAINTENANCE AGREEMENT REQUIRED

If this connection is to be part of a private service shared jointly with other building owners, attach copy of Recorded Joint Maintenance Agreement hereto.

PERMITS TO INDUSTRIAL AND/OR COMMERCIAL APPLICANTS

Permits can be issued to Industrial and/or Commercial Applicants only upon receipt and approval by the Commissioner of Public Works of such supplemental information, including drawings, composition and quantity data, and other pertinent information as he may require.

In addition, a valid Industrial User Discharge Permit issued by the City, and a valid Permit for Sewer System Extension or Connection issued by the Commonwealth of Massachusetts, Division of Water Pollution Control, shall be required for applicants wishing to discharge industrial wastes to the City's sewer system.

Industrial User Discharge Permit No. Date

Comm. Mass. Sewer Conn./Ext. Permit No. Date

TERMS

- a) Type of Pipe Required: PVC SDR-35
- b) Separate Sanitary and Storm connections are required where a 2 - pipe system exists in the street.
- c) All work must be inspected and approved by a D.P.W. Inspector, both in the street and on private property, before backfilling.
- d) A Filing and Inspection Fee of \$ 50.00 , plus an Entrance Fee of \$ where applicable, must accompany this application.
- e) Other requirements: INSP ONLY - Reis Asphalt TO DO ALL WORK
Storm Drain TO Connect TO EXIST S.D. ON HATH BLVD
@ SO. END OF PROPERTY

Applicant agrees to abide by the above terms, as well as all pertinent ordinances of the City of New Bedford, and such other special rules as the Commissioner of Public Works may deem necessary.

Kathleen J. Buena
Commissioner of Public Works

James J. Thustee
Signature of Property Owner

By: Susan Harris

By:
Signature of Owner's Representative

PROBLEMS AT SINTRA HGTS.

- ① RAISE SMH'S AT NW CORNER AND SOUTH END OF BUILDING TO GRADE.
- ② BUILD INVERTS IN THE TWO SMH'S.
- ③ INSTALL REGULATION TOP CONE SECTION IN SMH AT SOUTH END OF BUILDING. NON STD. M.H. NOW. NO ROOM FOR CONE SECTION.
- ④ CLEAN ALL CATCH BASINS.
- ⑤ CORRUGATED PIPE USED FOR ROOF DRAINS ON WEST SIDE APPEARS TO BE CONNECTED INTO C.B. AT SOUTH END OF BUILDING. THE CORRUGATED PIPE HAS BEEN CRUSHED AT THE C.B., THIS CONNECTION IS TO BE TIED IN SO THAT THE CORRUGATED PIPE IS NOT CRUSHED.

8/23/89

JM

→ WATER TESTED 8-23-89, WATER DOES NOT REACH BASIN, COMES UP THRU GROUND 100'± N. OF BASIN!!

MTG. 8-22-89

SINTRA HTS.

TONY MATOS

TONY SOUZA

GLEN PAULSEN

BILL BOUCHER

PAUL LANDREVILLE

ART CABRAL

TIM NELSON

CONVENED 1:25 P.M.

① QUESTIONS/DISCUSSION FROM BLDG. DEPT. RE; HANDICAP RAMPS, BASEMENT FLOODING, ROOF LEAKS, HEATING/AIR CONDITIONING, SITE FLOODING/STORM DRAINAGE.

② DPLW. ALSO QUESTIONED SITE/ROOF DRAINAGE
TONY MATOS: ALL ROOF DRAINS ON WEST SIDE OF PHASE I BLDG. TIED INTO "PERFORATED PIPE DRAIN" LEADING TO S.D.M.H. AT SOUTHERLY DRIVEWAY ENTRANCE. (FURTHER QUESTIONING SUGGESTS SO-CALLED PERF. PIPE MAY IN FACT BE "CORRUGATED," NOT PERFORATED). ALL EAST SIDE ROOF LEADERS DUMP ON GROUND, DRAIN S'LY. THRU PARKING AREA-DRIVEWAY TO EYE-HOLE IN SO. DRIVEWAY.

ALLEGATIONS OF WATER PONDING IN REAR (EASTERNLY) AREAWAYS DENIED.

GLEN PAULSEN: IS NOT NOW, NOR HAS THERE BEEN ANY PUDDLING OF WATER IN REAR ENTRANCE ALCOVES.

TONY MATOS: WATER DID POND OUT IN PARKING AREA(S) DURING CONS., BUT NOT SINCE FINAL GRADING AND BASE-COAT PAVING WERE COMPLETED. THIS COULD HAVE BEEN WHAT THE GUY WAS REFERRING TO.

BOTH: ALCOVES AT PRESENT ARE GRASS WITH FLAT STONE WALKS. WALKS WILL BE ASPHALTED AND RAISED

SLIGHTLY TO ELIMINATE ANY POSSIBILITY OF PONDING IN WALKWAYS.

D.P.W. WE WANT OFFICIAL AS-BUILT PLAN OF WHAT STORM PIPING EXISTS AS PREREQUISITE FOR C.O.'s.

GLEN PAULSEN: WE HAVE C.O.'s! SIGNED BY MR. HORROCKS!

BLOG DEPT.: TEMPORARY C.O.'s ONLY, DO NOT HAVE DEPARTMENTAL SIGNATURES.

D.P.W.: WE MUST HAVE AS-BUILTS TO SIGN C.O.'s.

FURTHER DISCUSSION, RESULT THAT MATOS & PAULSEN UNDERSTAND THAT IT IS THEIR RESPONSIBILITY TO SECURE AS-BUILT (D.P.W. WILL NOT CHASE VARIOUS CONTRACTORS FOR SAME) FROM AN ENGINEER. WILL CHECK WITH LARRY WORDEN/JOE MARTIN FOR ANY OTHER ITEMS NOT YET ADDRESSED, RESULTS TO BE GIVEN TO MATOS/PAULSEN.

MEETING THEN WENT ON TO FINANCES - I LEFT.

Bill Boucher

— What about buried Sewer M.H. in Phase I?

AS-BUILTS STILL NOT REC'D AS OF JAN. 26, 1990. TONY MATOS INFORMED PERSONALLY BY ME (WITNESS SUE HARRIS) "NO MORE C.O.'s 'TIL WE HAVE AS-BUILTS FOR SEWER & STORM DRAINAGE IN HAND! 1-26-90 Bill Boucher



CITY OF NEW BEDFORD

APPLICATION FOR CONNECTION TO
PUBLIC SANITARY SEWER AND/OR STORM DRAIN

Application No. N^o 21392

Date 6-29-87

The undersigned hereby requests permission to connect a building sanitary and/or storm sewer from the premises located at ^{342 Hathaway} ~~Potter St~~ ^{90' E of Hathaway Blvd} Assessors' Plot ~~82~~ Lot ~~9~~, to the public sanitary/storm sewer(s) in ~~Potter St~~ Street; the same to be installed in accordance with the terms and conditions set forth herein, and the ordinances of the City of New Bedford.

Name of Property Owner: ~~Hathaway-Potter Realty Trust~~ Tel. ~~697-8044~~ ^{OK 8078}
Please Print

Owner's Mailing Address: ~~30 Fox Hill Dr~~ ^{Bridgewater, MA 02324}

If application is being submitted by other than actual property owner, indicate that person's Name: Tel.

Mailing Address:

and attach Letter of Authorization from Property Owner hereto.

508-238-0177

JPT CONS. P.O. BOX 205, SO. EASTON, MA. 02375

BONDED CONTRACTOR OR DRAIN LAYER MAKING INSTALLATION

Name: ~~PAIS ASPHALT MARCHELLO CONS.~~ Tel. ~~295-6201~~ ⁹⁹⁶⁻⁰⁹³⁵

Address: ~~44 CUMWOOD Rd N.B. MA 02740~~
~~P.O. BOX 205 Bourne, MA. 02532~~

JOINT MAINTENANCE AGREEMENT REQUIRED

If this connection is to be part of a private service shared jointly with other building owners, attach copy of Recorded Joint Maintenance Agreement hereto.

PERMITS TO INDUSTRIAL AND/OR COMMERCIAL APPLICANTS

Permits can be issued to Industrial and/or Commercial Applicants only upon receipt and approval by the Commissioner of Public Works of such supplemental information, including drawings, composition and quantity data, and other pertinent information as he may require.

In addition, a valid Industrial User Discharge Permit issued by the City, and a valid Permit for Sewer System Extension or Connection issued by the Commonwealth of Massachusetts, Division of Water Pollution Control, shall be required for applicants wishing to discharge industrial wastes to the City's sewer system.

Industrial User Discharge Permit No. Date

Comm. Mass. Sewer Conn./Ext. Permit No. Date

TERMS

- a) Type of Pipe Required: ~~PVC~~ ^{SDR-35}
- b) Separate Sanitary and Storm connections are required where a 2 - pipe system exists in the street.
- c) All work must be inspected and approved by a D.P.W. Inspector, both in the street and on private property, before backfilling.
- d) A Filing and Inspection Fee of \$ ^{50.00}, plus an Entrance Fee of \$ where applicable, must accompany this application.

e) Other requirements: ^{INSP ONLY - PAIS TO DO ALL WORK - S.D. TO}
^{Connect to exist S.D. IN DUFEY ST & TO INTERIOR S.D}
^{Permit 21391}


Applicant agrees to abide by the above terms, as well as all pertinent ordinances of the City of New Bedford, and such other special rules as the Commissioner of Public Works may deem necessary.

Kathleen A. Buono
Commissioner of Public Works

^{Trustee}
Signature of Property Owner

By: ^{Susan Harris}

By: Signature of Owner's Rep

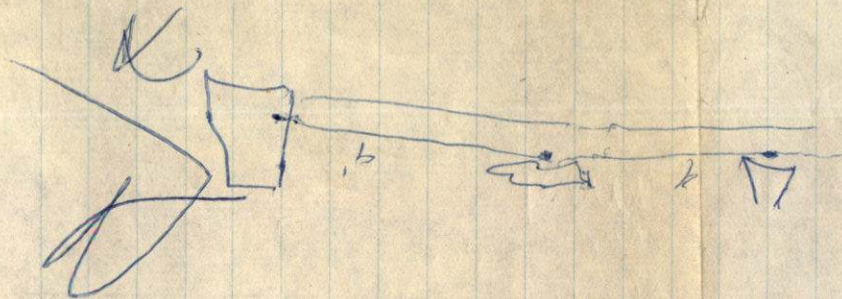


14.

By S side of Isotronics

100 WEST



Bad h

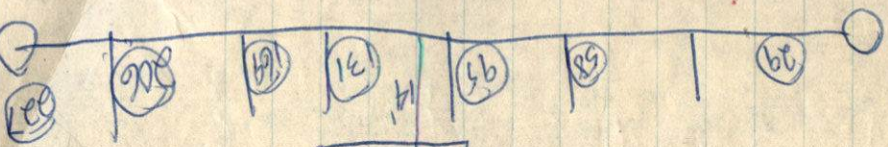


Sintra




Rock ledge
10 y
32.0
END OF PIPE Laid
8/7/80

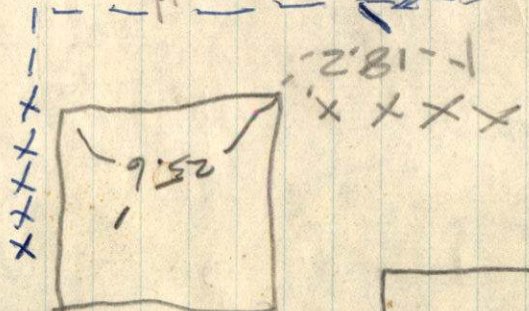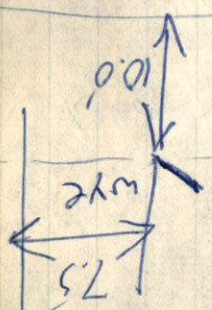

Prop.

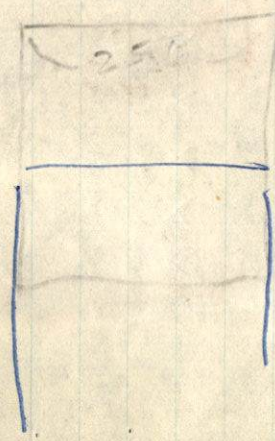

8/4/86
RRA

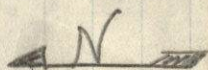

Mt. PLEASANT St.

9.00' $\pm$ TO TOP OF NEW PIPE

