



CITY OF NEW BEDFORD

APPLICATION FOR CONNECTION TO
PUBLIC SANITARY SEWER AND/OR STORM DRAIN

Application No. N^o 21478

Date 10-29-87

The undersigned hereby requests permission to connect a building sanitary and/or storm sewer from the premises located at Sassaquin Ave #1070 Street, Assessors' Plot 13619 Lot 663, to the public sanitary/storm sewer(s) in Sassaquin Ave Street; the same to be installed in accordance with the terms and conditions set forth herein, and the ordinances of the City of New Bedford.

Name of Property Owner: Humberto Amaral Tel. 9951147
Please Print

Owner's Mailing Address: 1070 Sassaquin Ave N.B. MA

If application is being submitted by other than actual property owner, indicate that person's Name: Tel.

Mailing Address:

and attach Letter of Authorization from Property Owner hereto.

~~BONDED~~ CONTRACTOR OR DRAIN LAYER MAKING INSTALLATION

Name: Joseph Mello Tel. 993-3958
Address: 118 Centre St Falmouth MA 02719

JOINT MAINTENANCE AGREEMENT REQUIRED

If this connection is to be part of a private service shared jointly with other building owners, attach copy of Recorded Joint Maintenance Agreement hereto.

PERMITS TO INDUSTRIAL AND/OR COMMERCIAL APPLICANTS

Permits can be issued to Industrial and/or Commercial Applicants only upon receipt and approval by the Commissioner of Public Works of such supplemental information, including drawings, composition and quantity data, and other pertinent information as he may require.

In addition, a valid Industrial User Discharge Permit issued by the City, and a valid Permit for Sewer System Extension or Connection issued by the Commonwealth of Massachusetts, Division of Water Pollution Control, shall be required for applicants wishing to discharge industrial wastes to the City's sewer system.

Industrial User Discharge Permit No. Date

Comm. Mass. Sewer Conn./Ext. Permit No. Date

TERMS

- a) Type of Pipe Required: PVC SDR-35
- b) Separate Sanitary and Storm connections are required where a 2 - pipe system exists in the street.
- c) All work must be inspected and approved by a D.P.W. Inspector, both in the street and on private property, before backfilling.
- d) A Filing and Inspection Fee of \$ 150.00, plus an Entrance Fee of \$ where applicable, must accompany this application.
- e) Other requirements: INSP ONLY - connect to exist stub in property - Joseph Mello to do all work

Applicant agrees to abide by the above terms, as well as all pertinent ordinances of the City of New Bedford, and such other special rules as the Commissioner of Public Works may deem necessary.

Kathleen J. Burns
Commissioner of Public Works


Humberto Amaral
Signature of Property Owner

By: Susan L. Harris

By: Signature of Owner's Representative

DRAIN NO. _____ OWNER _____

- ① MEASURE FRONT OF HOUSE, DISTANCE TO LOT LINE.
- ② MEASURE FROM COR. OF HOUSE TO DRAIN, DISTANCE WHERE DRAIN CROSSES PROPERTY LINE, ENTERS SEWER
- ③ LENGTH OF DRAIN FROM FRONT PROP. LINE TO HOUSE
- ④ SHOW NORTH ARROW.

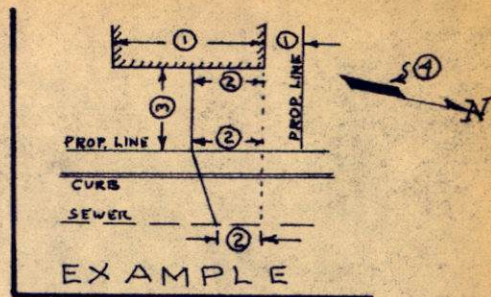


permit 21478

16/1/75

1070 A. Sass. Ave.

1070 Sass. Ave.

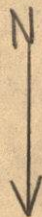

PROP. LINE

CURB LINE (IF ANY)

SEWER

21.3'

39.8'

9.5'

T.P.

17'

10'

5'

2'