



CITY OF NEW BEDFORD

APPLICATION FOR CONNECTION TO
PUBLIC SANITARY SEWER AND/OR STORM DRAIN

Application No. No 21612

181 SAMUEL BARNET BLVD

N.E. MIRROR

Date 5-20-88

The undersigned hereby requests permission to connect a building sanitary and/or storm sewer from the premises located at P. 135 / L. 32 #181 Samuel Barnett Blvd. N.B. Indust Park Assessors' Plot 135 Lot 32, to the public sanitary/storm sewer(s) in Samuel Barnett Blvd. Street; the same to be installed in accordance with the terms and conditions set forth herein, and the ordinances of the City of New Bedford.

Name of Property Owner: New England Mirror Inc. Tel. 996-8210
Please Print

Owner's Mailing Address: Samuel Barnett Blvd. N.B. Indust Park

If application is being submitted by other than actual property owner, indicate that person's Name: Tel.

Mailing Address:

and attach Letter of Authorization from Property Owner hereto.

BONDED CONTRACTOR OR DRAIN LAYER MAKING INSTALLATION

Name: Frank Corp Tel. 993-6500

Address: 4385 Acushnet Ave. N.B. MA 02745

JOINT MAINTENANCE AGREEMENT REQUIRED

If this connection is to be part of a private service shared jointly with other building owners, attach copy of Recorded Joint Maintenance Agreement hereto.

PERMITS TO INDUSTRIAL AND/OR COMMERCIAL APPLICANTS

Permits can be issued to Industrial and/or Commercial Applicants only upon receipt and approval by the Commissioner of Public Works of such supplemental information, including drawings, composition and quantity data, and other pertinent information as he may require.

In addition, a valid Industrial User Discharge Permit issued by the City, and a valid Permit for Sewer System Extension or Connection issued by the Commonwealth of Massachusetts, Division of Water Pollution Control, shall be required for applicants wishing to discharge industrial wastes to the City's sewer system.

Industrial User Discharge Permit No. Date

Comm. Mass. Sewer Conn./Ext. Permit No. Date

TERMS

- a) Type of Pipe Required: PVC SDR-35
- b) Separate Sanitary and Storm connections are required where a 2 - pipe system exists in the street.
- c) All work must be inspected and approved by a D.P.W. Inspector, both in the street and on private property, before backfilling.
- d) A Filing and Inspection Fee of \$ 50.00, plus an Entrance Fee of \$ where applicable, must accompany this application.
- e) Other requirements: Contract to assist M.H.E. in Barnett Blvd. Frank Corp. to do all work

Applicant agrees to abide by the above terms, as well as all pertinent ordinances of the City of New Bedford, and such other special rules as the Commissioner of Public Works may deem necessary.

By: Susan Harris
Commissioner of Public Works

By: Arthur Leland
Signature of Property Owner
Signature of Owner's Rep

CITY OF NEW BEDFORD

DEPARTMENT OF PUBLIC WORKS

Supplementary Information Required from Commercial or Industrial Firms in Addition to Issuance of Sewer Entrance Permit

A. Architect's floor plan showing proposed connections to building drain (inside building):

B. Architect's detail drawings of any pretreatment or equalization equipment:

C. Site plan showing:

- (1) Building and location of building sewer
- (2) Proposed connection to public sewer
- (3) Profile of building sewer
- (4) Plan and profile of storm drain
- (5) Location of control manhole

(Standard type — preferably between property line and public sewer.)

D. Wastewater Information:

Date: MAY 18, 1988

(1) Name of firm: NEW ENGLAND MIRROR INC.

(2) Address: SAMUEL BARNET BLDG. NEW BEDFORD INDUSTRIAL PARK

(3) Name and title of person completing form. (company representative):

ARTHUR CABRAL - SITE ENGINEER

(4) Industry type (SIC Number): 496

(5) Number of Employees: 6

(6) Principal products manufactured, produced, processed or sold:

GLASS MIRROR MFG.

(7) Sources of water supply: Municipal ✓ Well _____

(8) Estimated volume of water to be used per day: 16,000 MIN AVER. gallons.

(9) Flow gauges in plant METERED influent NONE effluent.

(10) Water consumed in processes: _____ %.

(11) Recycled water: 6 %.

(12) Cooling water: 0 %.

(13) Number of operating days per week: 5

(14) Number of shifts per day: 1

(15) Type of discharge: ✓ continuous _____ batch.

(16) If batch NA per shift.

(17) Estimated volume of wastewater discharged daily 16,000 Av. gallons.

(18) Wastewater abatement practices to be used:

(a) Process changes: NONE - (NEW OPERATION)

(b) Changes in raw materials: NONE - (NEW OPERATION)

(c) Recycling methods: NONE - (NEW OPERATION)

(d) Wastewater treatment equipment: COPPER, SILVER RECLAIM
pH ADJUSTMENT

(e) Monitoring devices: SAMPLING & TEST SUMP

(f) Sampling and testing procedures: IN HOUSE MONITORING &
PROVISION FOR MUNICIPAL CERTIFICATION

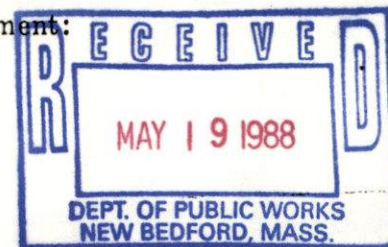
(19) Expected constituents of final wastewater discharge:

(a) pH 7.0 (d) Cl Req'm't. 0 mg/l

(b) Grease/Oil 0 mg/l (e) S. S. _____ mg/l

(c) COD — mg/l (f) Color clear mg/l

(20) Charles H. Franklin Jr.
Signature of Property Owner

5/18/88
Date

O.K. VINNIE PURTADO 5-20-88
" Bill Pancher

5/17/88

To Sea Coast Const -

Charles H. Franklin Jr.
Proc of James Benet Blue Corp
give to Arthur Cabral and
Robert Martin to sign for the
water & sewer entrance permits.

Charles H. Franklin Jr.
Proc.
James Benet Blue Corp
Permits are 78

R/H CONTROL M.H. 94.25
 INV. SEWER M.H. (WHICH STUB ENTRIES)
 92.74

DIFF. IN EL. 1.51

DISTANCE FROM CONTROL M.H. TO
 END OF EXIST. STUB 190' ±

CANNOT CONNECT TO EXIST. STUB (STUB
 AT HIGH END OF LOT 211)

CANNOT CONNECT TO NEXT EXIST. M.H. IS IN
 BARRETT BLVD.



O.K. TO ISSUE SEWER PERMIT
 SUBJECT TO ABOVE CONDITION.