



CITY OF NEW BEDFORD

APPLICATION FOR CONNECTION TO
PUBLIC SANITARY SEWER AND/OR STORM DRAIN

Application No. N^o 21623

Date 5/31/88

The undersigned hereby requests permission to connect a building sanitary and/or storm sewer from the premises located at Hassey St. (W.S.) 150 ± 5 of Connery, Assessors' Plot 37, Lot 328, to the public sanitary/storm sewer(s) in Hassey St.; the same to be installed in accordance with the terms and conditions set forth herein, and the ordinances of the City of New Bedford.

Name of Property Owner: 49 Hassey St. Inc. Tel. 441-8805
Please Print

Owner's Mailing Address: 56 Keaneey Rd. Needham, MA 02194

If application is being submitted by other than actual property owner, indicate that person's

Name: _____ Tel. _____

Mailing Address: _____

and attach Letter of Authorization from Property Owner hereto.

BONDED CONTRACTOR OR DRAIN LAYER MAKING INSTALLATION

Name: B.T.B. Excavating, Yemassee, S.C. Tel. 703-8577

Address: 26 Quanaoag Rd. E. Freetown, MA 02717

JOINT MAINTENANCE AGREEMENT REQUIRED

If this connection is to be part of a private service shared jointly with other building owners, attach copy of Recorded Joint Maintenance Agreement hereto.

PERMITS TO INDUSTRIAL AND/OR COMMERCIAL APPLICANTS

Permits can be issued to Industrial and/or Commercial Applicants only upon receipt and approval by the Commissioner of Public Works of such supplemental information, including drawings, composition and quantity data, and other pertinent information as he may require.

In addition, a valid Industrial User Discharge Permit issued by the City, and a valid Permit for Sewer System Extension or Connection issued by the Commonwealth of Massachusetts, Division of Water Pollution Control, shall be required for applicants wishing to discharge industrial wastes to the City's sewer system.

Industrial User Discharge Permit No. _____ Date _____

Comm. Mass. Sewer Conn./Ext. Permit No. _____ Date _____

TERMS

a) Type of Pipe Required: PVC SDR-35

b) Separate Sanitary and Storm connections are required where a 2 - pipe system exists in the street.

c) All work must be inspected and approved by a D.P.W. Inspector, both in the street and on private property, before backfilling.

d) A Filing and Inspection Fee of \$ 50.00, plus an Entrance Fee of \$ _____ where applicable, must accompany this application.

e) Other requirements: unsp only - B.T.B. to do all work inc -
including 5 C.B.'s 12" x 15" S.D. & 10" sewer Temp
Patch within 48 hrs. Perm. Patch in 30 days.

Applicant agrees to abide by the above terms, as well as all pertinent ordinances of the City of New Bedford, and such other special rules as the Commissioner of Public Works may deem necessary.

Kathleen J. Buongiorno
Commissioner of Public Works

49 Hassey St. Inc.
Prop.
Signature of Property Owner

By: Susan Harris

By: [Signature]
Signature of Owner's Representative

Permit No. 21623

CITY OF NEW BEDFORD
DEPARTMENT OF PUBLIC WORKS

Supplementary Information Required from Commercial or
Industrial Firms in Addition to Issuance of Sewer Entrance Permit

- ✓ A. Architect's floor plan showing proposed connections to building drain (inside building):
- B. Architect's detail drawings of any pretreatment or equalization equipment:
- C. Site plan showing:
- ✓ (1) Building and location of building sewer
 - ✓ (2) Proposed connection to public sewer
 - ✓ (3) ~~Profile of building sewer~~
 - ✓ (4) Plan and ~~profile~~ of storm drain
 - ✓ (5) Location of control manhole
(Standard type — preferably between property line and public sewer.)

Date: May 24, 1988


D. Wastewater Information:

- (1) Name of firm: 49 Hassey Street, Inc.
- (2) Address: 49 Hassey Street, New Bedford, MA
- (3) Name and title of person completing form. (company representative):
Manuel B. Garcia, P.E., Garcia & Carey Engineering, Inc.
- (4) Industry type (SIC Number): Fish Processing Plant 25,080 Sq. Ft.
- (5) Number of Employees: 50 (1 employ./500 Sq. Ft.)
- (6) Principal products manufactured, produced, processed or sold: Speculative Building For Fish Processing
- (7) Sources of water supply: Municipal X Well _____
- (8) Estimated volume of water to be used per day: 27,580 gallons.
- (9) Flow gauges in plant meter influent _____ effluent.
- (10) Water consumed in processes: 97 %.
- (11) Recycled water: 0 %.
- (12) Cooling water: 0 %.
- (13) Number of operating days per week: 5
- (14) Number of shifts per day: 1
- (15) Type of discharge: X continuous _____ batch.
- (16) If batch (N. A.) per shift.
- (17) Estimated volume of wastewater discharged daily 25,080 gallons.
- (18) Wastewater abatement practices to be used:
 - (a) Process changes: none
 - (b) Changes in raw materials: none
 - (c) Recycling methods: none
 - (d) Wastewater treatment equipment: none
 - (e) Monitoring devices: City of New Bedford Standard Control Manhole
 - (f) Sampling and testing procedures: none
- (19) Expected constituents of final wastewater discharge:
 - (a) pH _____
 - (b) Grease/Oil _____ mg/l
 - (c) C O D _____ mg/l
 - (d) Cl Req'm't. _____ mg/l
 - (e) S. S. _____ mg/l
 - (f) Color _____ mg/l

(20)

Signature of Property Owner

Date

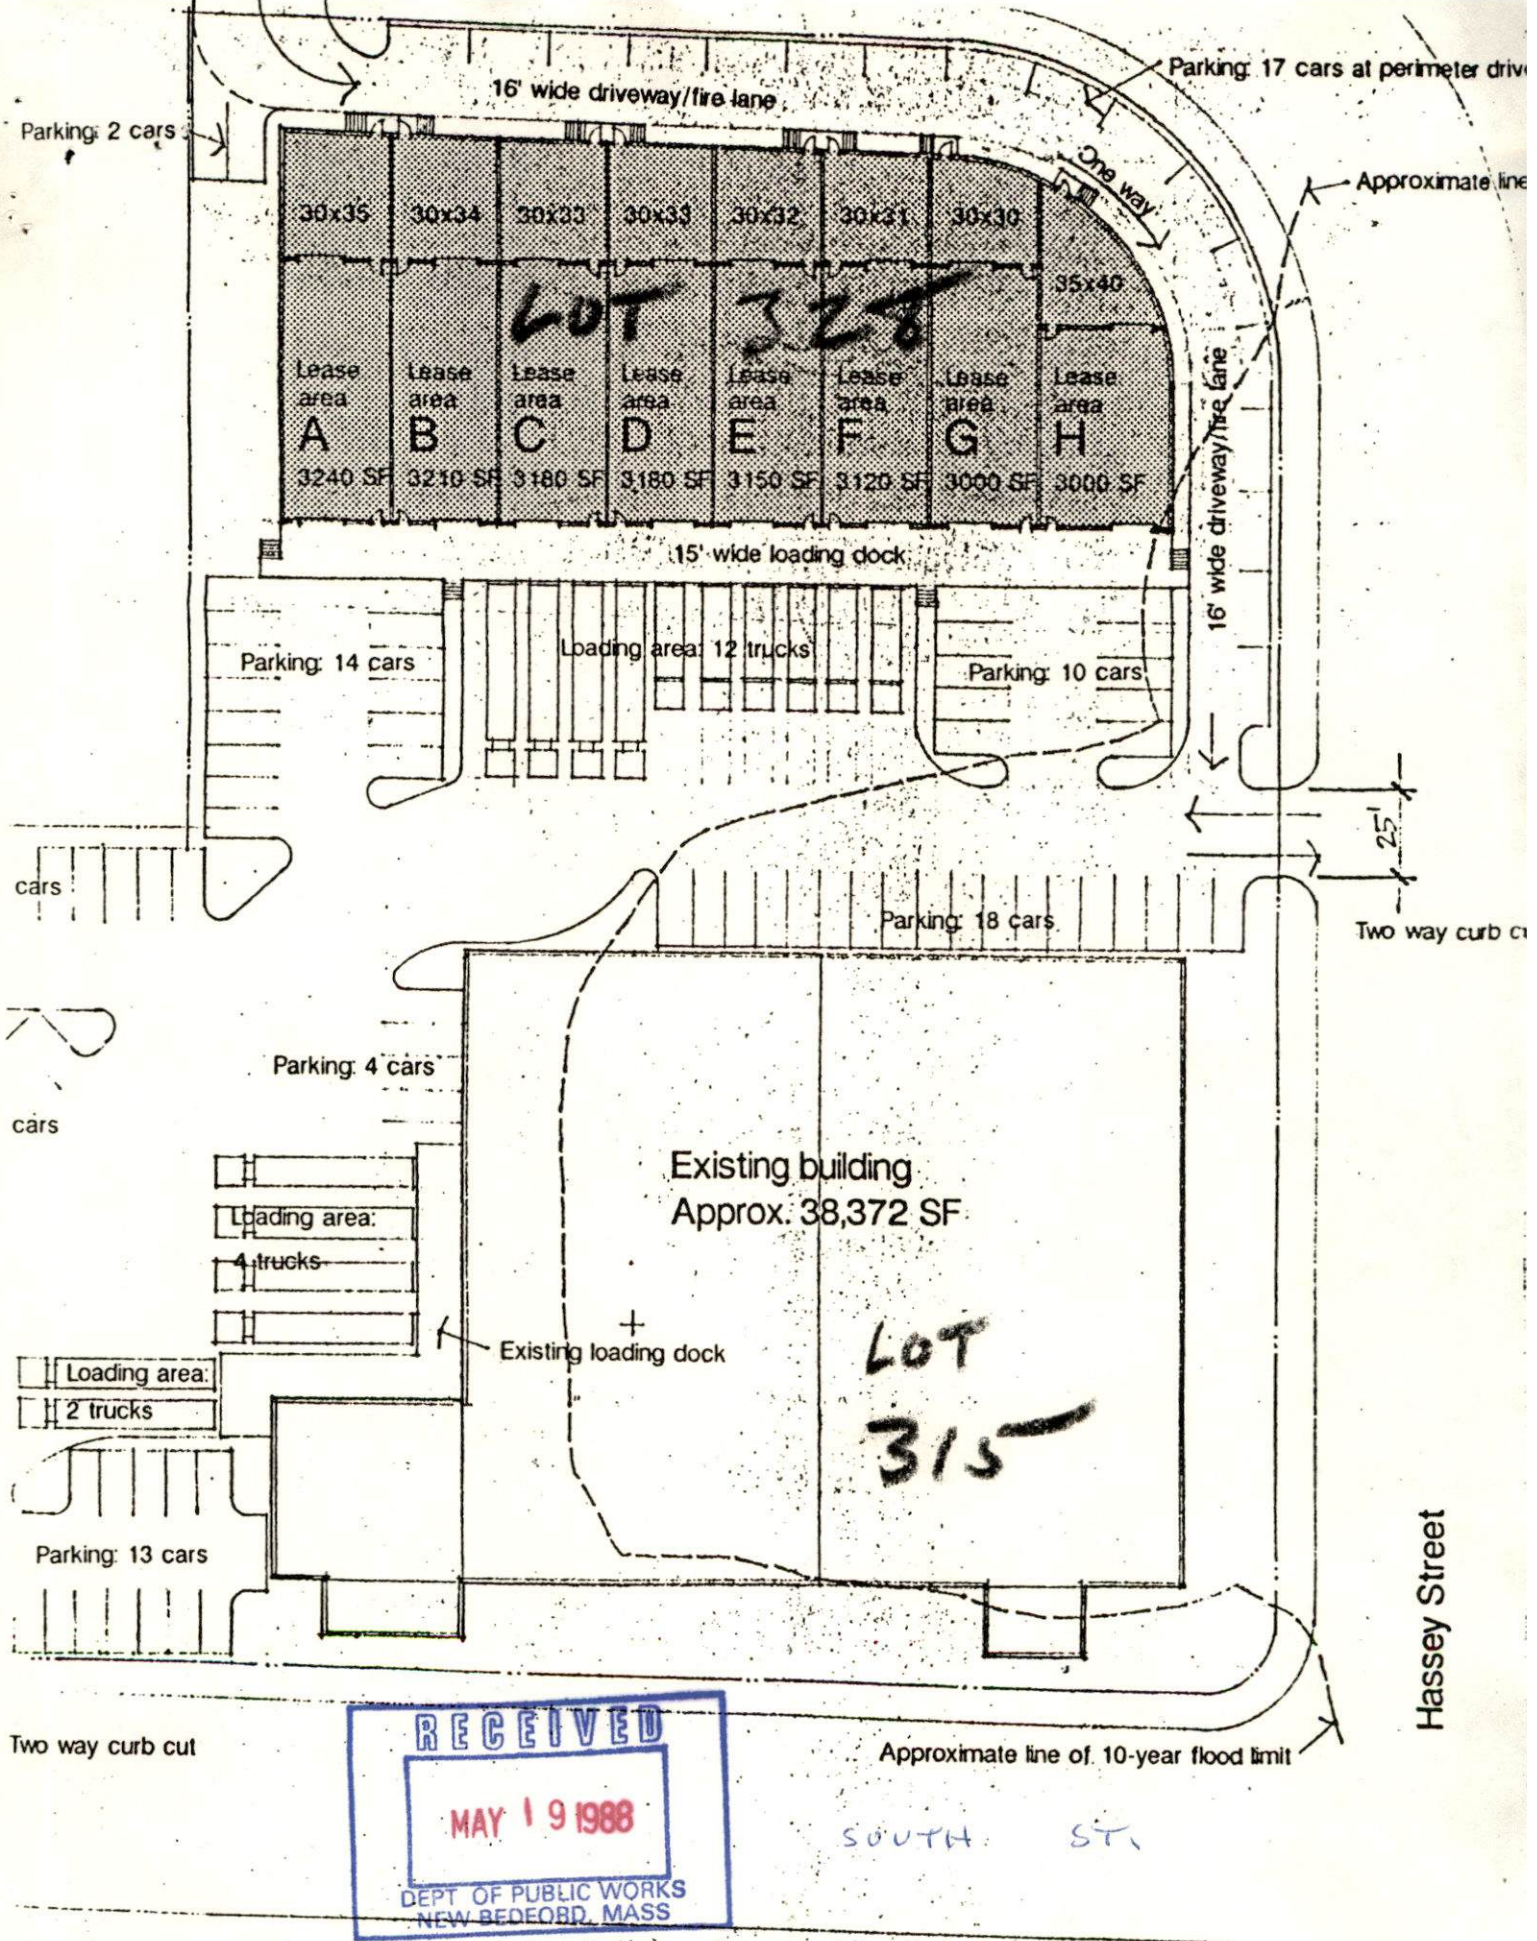

on to an Existing Fish Processing Facility
v Bedford, MA