



CITY OF NEW BEDFORD

APPLICATION FOR CONNECTION TO
PUBLIC SANITARY SEWER AND/OR STORM DRAIN

Application No. No 21667

Date 8/23/88

The undersigned hereby requests permission to connect a building sanitary and/or storm sewer from the premises located at ~~504 Beverly St.~~ ^{N.W.C. - BARNARD ST. #507} ~~605~~ ^{BARNARD ST. #507} Assessors' Plot 134A Lot 17, to the public sanitary/storm sewer(s) in 507 Barnard St. Street; the same to be installed in accordance with the terms and conditions set forth herein, and the ordinances of the City of New Bedford.

Name of Property Owner: Gilbert Mello Please Print Tel. 995-6284X

Owner's Mailing Address: 507 Barnard St. (W.S.)

If application is being submitted by other than actual property owner, indicate that person's Name: Tel. Mailing Address: and attach Letter of Authorization from Property Owner hereto.

BONDED CONTRACTOR OR DRAIN LAYER MAKING INSTALLATION

Name: Capeway (Dennis Borges Septic Tank) Tel. 993-4197 Address: PINE GROVE ST. PHUN.

JOINT MAINTENANCE AGREEMENT REQUIRED

If this connection is to be part of a private service shared jointly with other building owners, attach copy of Recorded Joint Maintenance Agreement hereto.

PERMITS TO INDUSTRIAL AND/OR COMMERCIAL APPLICANTS

Permits can be issued to Industrial and/or Commercial Applicants only upon receipt and approval by the Commissioner of Public Works of such supplemental information, including drawings, composition and quantity data, and other pertinent information as he may require.

In addition, a valid Industrial User Discharge Permit issued by the City, and a valid Permit for Sewer System Extension or Connection issued by the Commonwealth of Massachusetts, Division of Water Pollution Control, shall be required for applicants wishing to discharge industrial wastes to the City's sewer system.

Industrial User Discharge Permit No. Date Comm. Mass. Sewer Conn./Ext. Permit No. Date

TERMS

- a) Type of Pipe Required: PVC SD 35
b) Separate Sanitary and Storm connections are required where a 2 - pipe system exists in the street.
c) All work must be inspected and approved by a D.P.W. Inspector, both in the street and on private property, before backfilling.
d) A Filing and Inspection Fee of \$ 207.18, plus an Entrance Fee of \$ where applicable, must accompany this application.
e) Other requirements: unsp. only - connect to exist - stub Capeway will do all the work.

Applicant agrees to abide by the above terms, as well as all pertinent ordinances of the City of New Bedford, and such other special rules as the Commissioner of Public Works may deem necessary.

By: Kathleen J. Buenz Commissioner of Public Works By: Gilbert Mello Signature of Property Owner By: Susan Harris Signature of Owner's Representative

Aug. 16 1974

HRS.

Man
 Jose M. Novas 5 @ 4.38 — 21.90
 Norbert St. Pierre 5 @ 3.79 — 18.95
 Joseph T. Pina 5 @ 3.79 — 18.95
 Jim Lemos 5 @ 3.16 — 15.80
 Barry D. Mello 5 @ 3.91 — 19.55
 Tom Banker 5 @ 3.73 — 18.65
 113.80

Materials

1/2 bag Cement @ 2.45 — 1.23
 100 lbs Sand (cut) @ .10 — 2.45
 1-6" Trans. to Cap @ 3.40 — 1.10
 3-10 ft 6" Trans. to pipe (30 ft) @ 1.35 — 4.05
 " " 4" " " (30 ft) @ .85 — 2.55

Curb cut - 6 1/2 FT.
 Sewer cut - 7 FT.

Pieces To curb (2) - 1-10 ft 1-5 ft
 " " house - 1-8 ft 1 piece

#49 - 3 hr. — 19.65
 #116 - 1 hr — 3.00



207.18

For more info - Anne M. Novas

L. P. M.

File 14 DRAIN NO 607 BARNARD OWNER (Gilbert Melillo)

- ① MEASURE FRONT OF HOUSE, DISTANCE TO LOT LINE.
- ② MEASURE FROM COR. OF HOUSE TO DRAIN, DISTANCE WHERE DRAIN CROSSES PROPERTY LINE, ENTERS SEWER.
- ③ LENGTH OF DRAIN FROM FRONT PROP. LINE TO HOUSE.
- ④ SHOW NORTH ARROW.

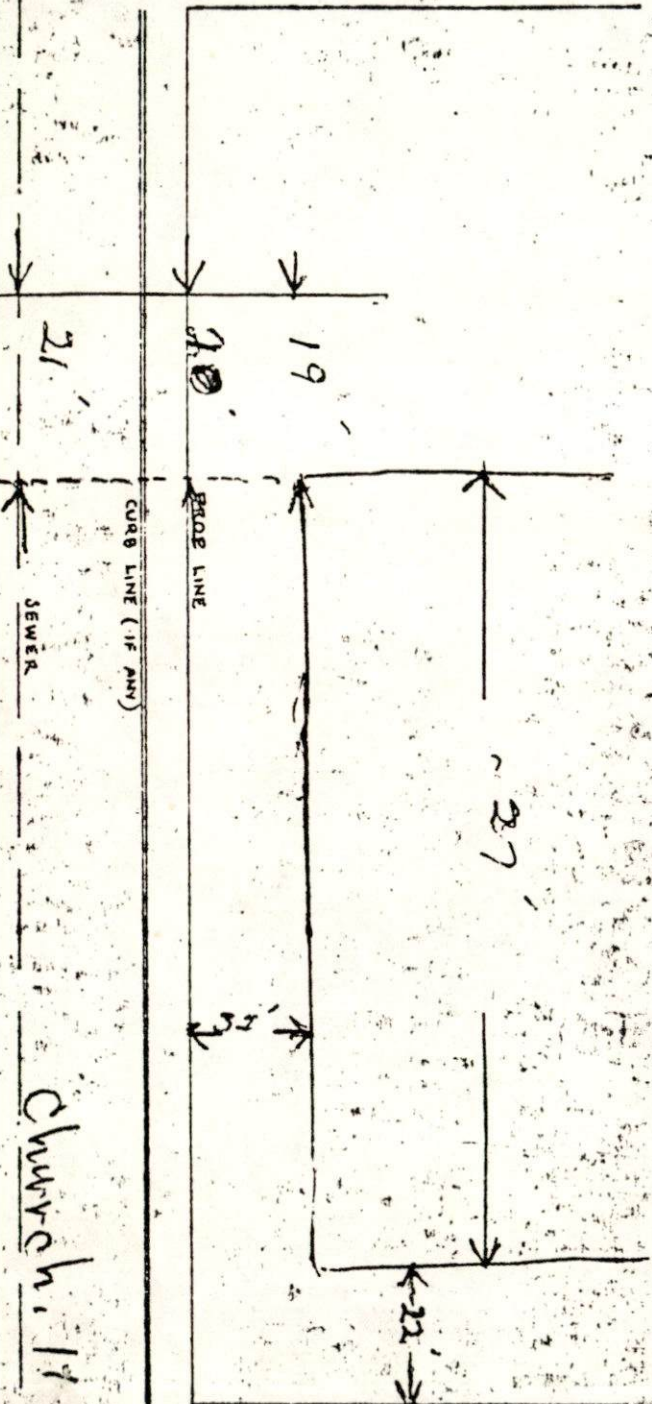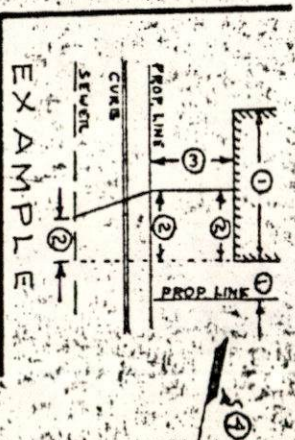

Church, 11