



CITY OF NEW BEDFORD

APPLICATION FOR CONNECTION TO
PUBLIC SANITARY SEWER AND/OR STORM DRAIN

Application No. 22221

Date 7/13/93

The undersigned hereby requests permission to connect a building sanitary and/or storm sewer from the premises located at Whitman St. S.S. 320 w/ Hope St., Assessors' Plot 105. Lot 37.38, to the public sanitary/storm sewer(s) in Whitman St. Street; the same to be installed in accordance with the terms and conditions set forth herein, and the ordinances of the City of New Bedford.

Name of Property Owner: Flavio Duarte Tel. 990-2483
Please Print

Owner's Mailing Address: 208 Eugenia St. U.B. 02745

If application is being submitted by other than actual property owner, indicate that person's

Name: Tel.

Mailing Address:

and attach Letter of Authorization from Property Owner hereto.

BONDED CONTRACTOR OR DRAIN LAYER MAKING INSTALLATION

Name: Medeiros Construction Cardoso Cont. Tel. 636-8784

Address: P.O. Box 54 Dartmouth, MA.

JOINT MAINTENANCE AGREEMENT REQUIRED

If this connection is to be part of a private service shared jointly with other building owners, attach copy of Recorded Joint Maintenance Agreement hereto.


PERMITS TO INDUS

Permits can be issued to Industrial a the Commissioner of Public Works of s and quantity data, and other pertinent in

In addition, a valid Industrial User Di System Extension or Connection issued tion Control, shall be required for appl system.

Industrial User Discharge Permit No.

Comm. Mass. Sewer Conn./Ext. Pern

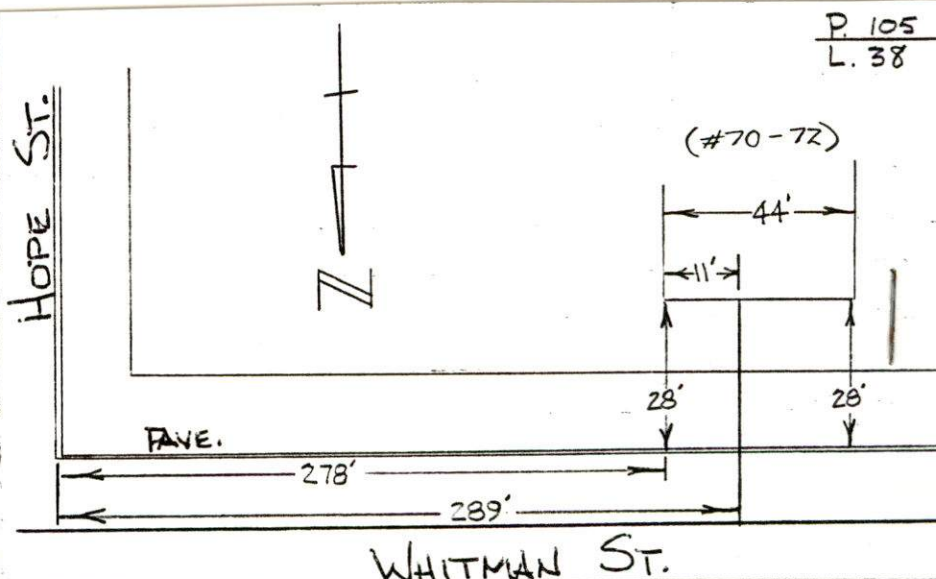

a) Type of Pipe Required: P.V.C.

b) Separate Sanitary and Storm connections are required where a 2 - pipe system exists in the street.

c) All work must be inspected and approved by a D.P.W. Inspector, both in the street and on private property, before backfilling.

d) A Filing and Inspection Fee of \$ 150.00, plus an Entrance Fee of \$ where applicable, must accompany this application.

e) Other requirements: 660 G.P.U.

Applicant agrees to abide by the above terms, as well as all pertinent ordinances of the City of New Bedford, and such other special rules as the Commissioner of Public Works may deem necessary.

Lawrence D. Worden
Commissioner of Public Works

Flavio S. Duarte
Signature of Property Owner

By: Lynne A. Day

By: Signature of Owner's Representative