



CITY OF NEW BEDFORD

APPLICATION FOR CONNECTION TO
PUBLIC SANITARY SEWER AND/OR STORM DRAIN

Application No. 22223

Date 7-13-93

The undersigned hereby requests permission to connect a building sanitary and/or storm sewer from the premises located at Foley Drive, S.S., 260'± W/ Acush-Ave Assessors' Plot (#30) 152-E Lot 77, to the public sanitary/storm sewer(s) in Foley Drive Street; the same to be installed in accordance with the terms and conditions set forth herein, and the ordinances of the City of New Bedford.

Name of Property Owner: Long Realty, Inc. Tel. 999-7067
Please Print

Owner's Mailing Address: 658 Rockdale Ave, N.B., MA

If application is being submitted by other than actual property owner, indicate that person's
Name: _____ Tel. _____
Mailing Address: _____
and attach Letter of Authorization from Property Owner hereto.

BONDED CONTRACTOR OR DRAIN LAYER MAKING INSTALLATION

Name: Dr. Porter Cons. Co., Inc. Tel. 824-4852
Address: 287 Tremont St., Taunton, MA 02780


JOINT MAINTENANCE AGREEMENT REQUIRED

If this connection is to be part of a private service shared jointly with other building owners, attach copy of Recorded Joint Maintenance Agreement hereto.

PERMITS TO INDUSTRIAL

Permits can be issued to Industrial and the Commissioner of Public Works of and quantity data, and other pertinent information. In addition, a valid Industrial User I System Extension or Connection issued tion Control, shall be required for app system.

Industrial User Discharge Permit No _____
Comm. Mass. Sewer Conn./Ext. Per _____

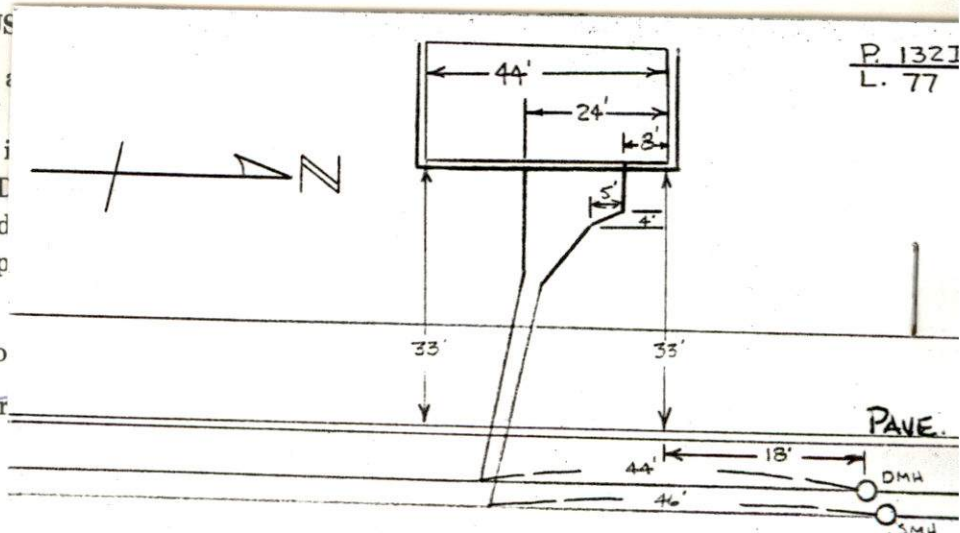

- a) Type of Pipe Required: PVC
- b) Separate Sanitary and Storm connections are required where a 2-pipe system exists in the street.
- c) All work must be inspected and approved by a D.P.W. Inspector, both in the street and on private property, before backfilling.
- d) A Filing and Inspection Fee of \$ 150.00, plus an Entrance Fee of \$ _____ where applicable, must accompany this application.
- e) Other requirements: CONNECT TO STUB AT PROP. LINE.

Applicant agrees to abide by the above terms, as well as all pertinent ordinances of the City of New Bedford, and such other special rules as the Commissioner of Public Works may deem necessary.

Lawrence D. Worden
Commissioner of Public Works

Long Realty Inc
Signature of Property Owner

By: Bill Boucher

By: _____
Signature of Owner's Representative