



CITY OF NEW BEDFORD

APPLICATION FOR CONNECTION TO PUBLIC SANITARY SEWER AND/OR STORM DRAIN

Application No. 22290			Date 3 / 22/94.
The undersigned hereby requests permission to connect a building sanitary and/or storm sewer from the			
premises located at AMARIA. Lot .38, to the public sanital	AVE_(SS) 420 ± WOX	rof CHURCH ST-	, Assessors' Plot 1.30 H-
Lot .38, to the public sanitar	ry storm sewer(s) in	AMANDA A	vE;
the same to be installed in acco			
of the City of New Bedford.			
Name of Property Owner:	B. HOWN AUTHO		Tel. 997-4824
Owner's Mailing Address: 13	4 SO. SECOND	ST. NB-MA-	02740 -
If application is being submitted by other than actual property owner, indicate that person's Name: ELWARD KONETCHY			
Name: EAWARD	RONETCHY	~ *00 1.	Tel. 9.9/.48.4
Mailing Address:134.	SO SECONS	ST- 10.5.14.6	F 02740
and attach Letter of Authorization	on from Property Owner	r hereto.	
A TOTAL CONTROL OF THE PARTY OF	TRACTOR OR DRAIN		
Name: WC SMITH.	E CON		Tel
Address: Sl. BRINGE	wood Rs. NB	, MA. 02/45	
JÓIN	T MAINTENANCE AC	REEMENT-RÊQUIRE	D
If this connection is to be part	of a private service sha	red jointly with other h	ouilding owners, attach copy
of Recorded Joint Maintenance	Agreement hereto.		
PERMITS TO	INDUSTRIAL AND/O	R COMMERCIAL API	PLICANTS
Permits can be issued to Industrial and/or Commercial Applicants only upon receipt and approval by the Commissioner of Public Works of such supplemental information, including drawings, composition and quantity data, and other pertinant information as he may require. In addition, a valid Industrial User Discharge Permit issued by the City, and a valid Permit for Sewer System Extension or Connection issued by the Commonwealth of Massachusetts, Division of Water Pollution Control, shall be required for applicants wishing to discharge industrial wastes to the City's sewer system.			
Industrial User Discharge Per	rmit No		Date
Comm. Mass. Sewer Conn./I			
a) Type of Pipe Required:		35-	
b) Separate Sanitary and Storm			
c) All work must be inspected as	nd approved by a D.P.V	V. Inspector, both in th	e street and on private prop-
erty, before backfilling. d) A Filing and Inspection Fee	SEMMINE Sill	B-	
		s an Entrance Fee of \$	where appli-
e) Other requirements: INSP. ONLY _ WC SMITH TO DO ALL WORK. (SURF. DRAW ONLY _			
e) Other requirements: MS/	ONLY - WESMIN	H VO DO HEL WOR	CK SURF- ORAIN ONLY _
TO BE CONNECTED	WEST OF SEWER	LINE BYWN DMH	AND CD - (See SKETCH.)
Applicant agrees to abide by			
ford, and such other special rules as the Commissioner of Public Works may deem necessary.			
Commissioner of Publi	0	당 그런	ture of Property Owner
By: Mario J.	one	By: Zwo.d. Signature of	Owner's Representative

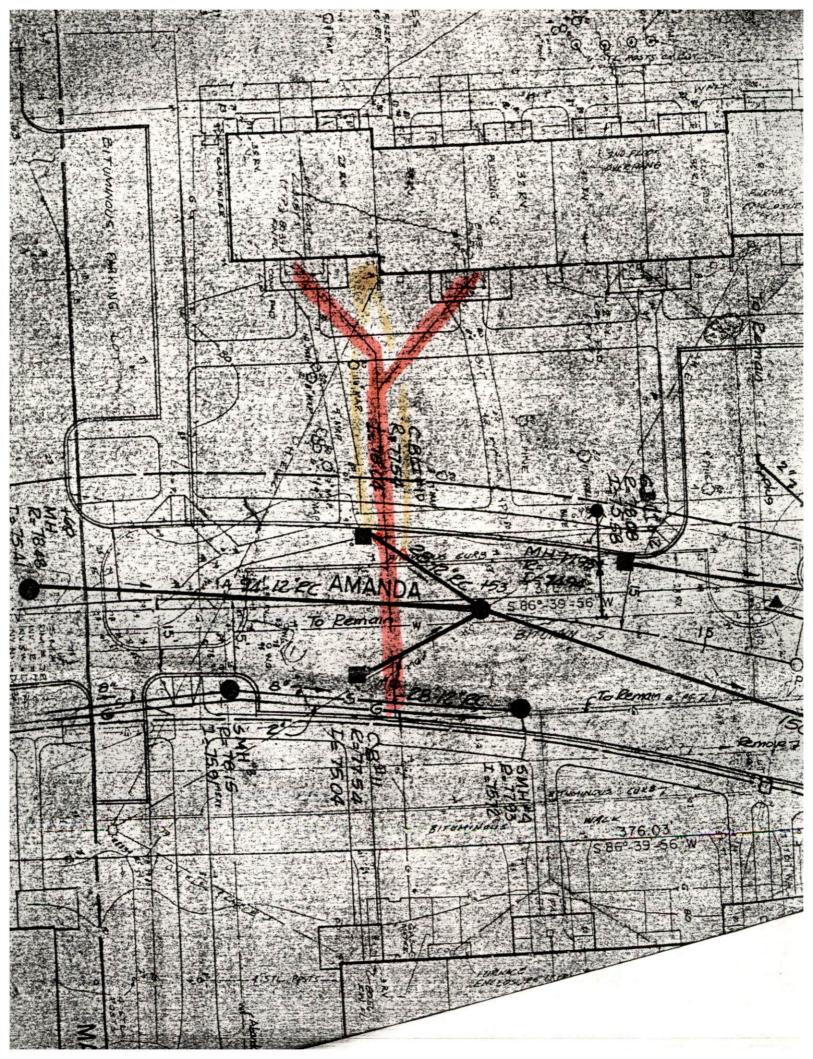

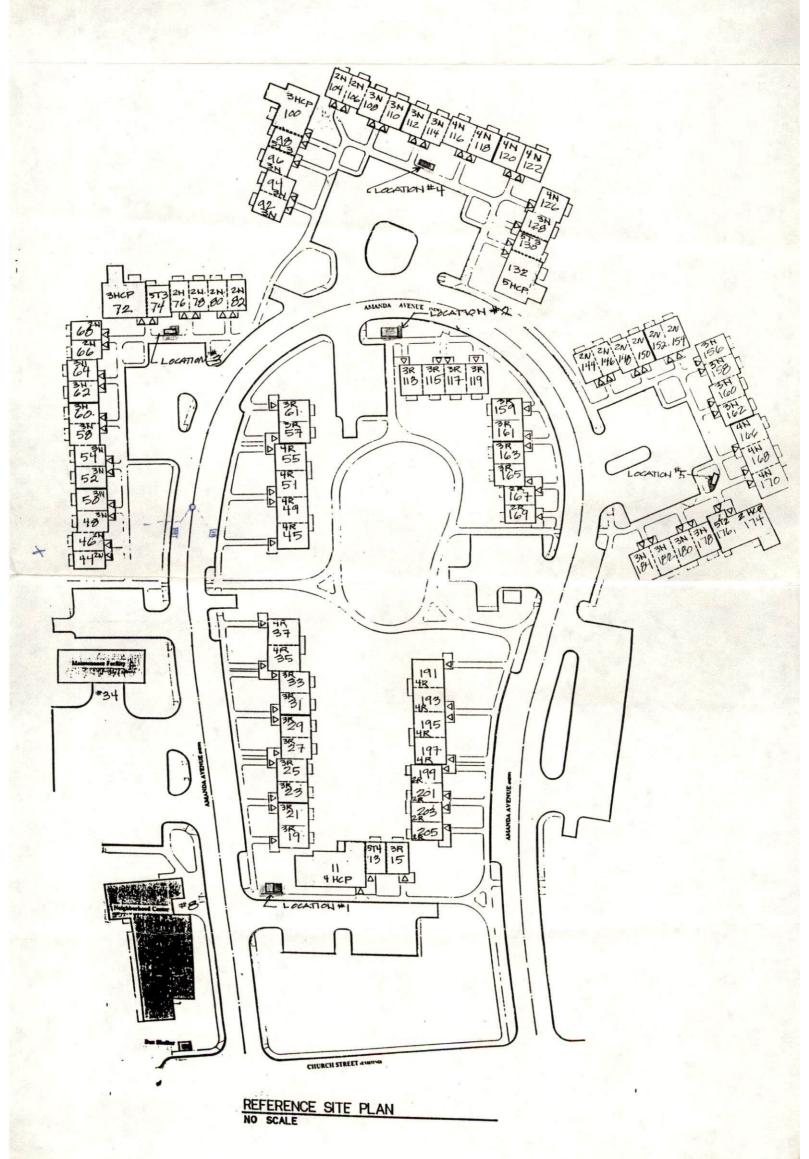

UNIT ADDRESS HUMBERS