


CITY OF NEW BEDFORD

APPLICATION FOR CONNECTION TO PUBLIC SANITARY SEWER AND/OR STORM DRAIN

Application No. 22353	Date 6/13/25
The undersigned hereby requests permission to connect a building sanitary and/or storm sewer from the	
premises located at HATHHWAY ST. (SS) 45't E BELLEVILLE AVE., Assessors' Plot 100. Street Lot 1., to the public sanitary/storm sewer(s) in HATHAWAY ST.	
Lot . 4, to the public sanitary/storm sewer(s) in	HATHAWAY ST.
the same to be installed in accordance with the terms	Street
of the City of New Bedford.	
Name of Property Owner: CODY & TOBIN Please P	Tel. 999-67//
Owner's Mailing Address: 516 BELLEVILLE AVE NB-02746	
If application is being submitted by other than actual	property owner, indicate that person's
Name:	Tel.
Mailing Address:	
and attach Letter of Authorization from Property Owne	r hereto.
BONDED CONTRACTOR OR DRAIN	LAYER MAKING INSTALLATION
Name: NORMAN'S ENTERPRISES	Tel. 999-6355
Address: 194-NASH RD - 1	1B-MA-02746
JOINT MAINTENANCE AC	GREEMENT RÉQUIRED
If this connection is to be part of a private service sha	ared jointly with other building owners, attach copy
of Recorded Joint Maintenance Agreement hereto.	
DEDDMING TO INDUSTRIAL AND (O	AD COMMEDICAL ADDITIONAL ADDITION
PERMITS TO INDUSTRIAL AND/O	
Permits can be issued to Industrial and/or Commercial Applicants only upon receipt and approval by the Commissioner of Public Works of such supplemental information, including drawings, composition and quantity data, and other pertinant information as he may require. In addition, a valid Industrial User Discharge Permit issued by the City, and a valid Permit for Sewer System Extension or Connection issued by the Commonwealth of Massachusetts, Division of Water Pollution Control, shall be required for applicants wishing to discharge industrial wastes to the City's sewer system.	
Industrial User Discharge Permit No	Date
Comm. Mass. Sewer Conn./Ext. Permit No. NO INDUSTRIAL DISCHARGE & NO MECHANICAL MAINTENANCE WITHOUT DEP. PERMIT. W.W.D. TO BECIDE IF NEEDED AN IND. PRETREATMENT PROGRAM. BY RICK RONDO. DEP. IV. TERMS OF PING PROVINGE.	
a) Type of Fipe Required:	
b) Separate Sanitary and Storm connections are required where a 2 - pipe system exists in the street.	
c) All work must be inspected and approved by a D.P.V	V. Inspector, both in the street and on private prop-
erty, before backfilling.	
d) A Filing and Inspection Fee of \$, plu	s an Entrance Fee of \$ where appli-
cable, must accompany this application.	
e) Other requirements: INSP. ONLY - NORMAN TO SO ALL WORK. 3306PD. TO BE CONNECT- TO: 36" Sewer & 60" STORM DRAIN: IN ST.	
Applicant agrees to abide by the above terms, as well as all pertinent ordinances of the City of New Bed-	
ford, and such other special rules as the Commissioner of Public Works may deem necessary. Autoreuce L. Wickey M	
By: Mario A- Jours	By: Signature of Owner's Representative
31 - 144	

PROPOSED SEWER + WOTER SERU, FOR CODY + TOEW INC AS SUBMITTED RY NORMAN'S ENTERPRISES 10/25/95

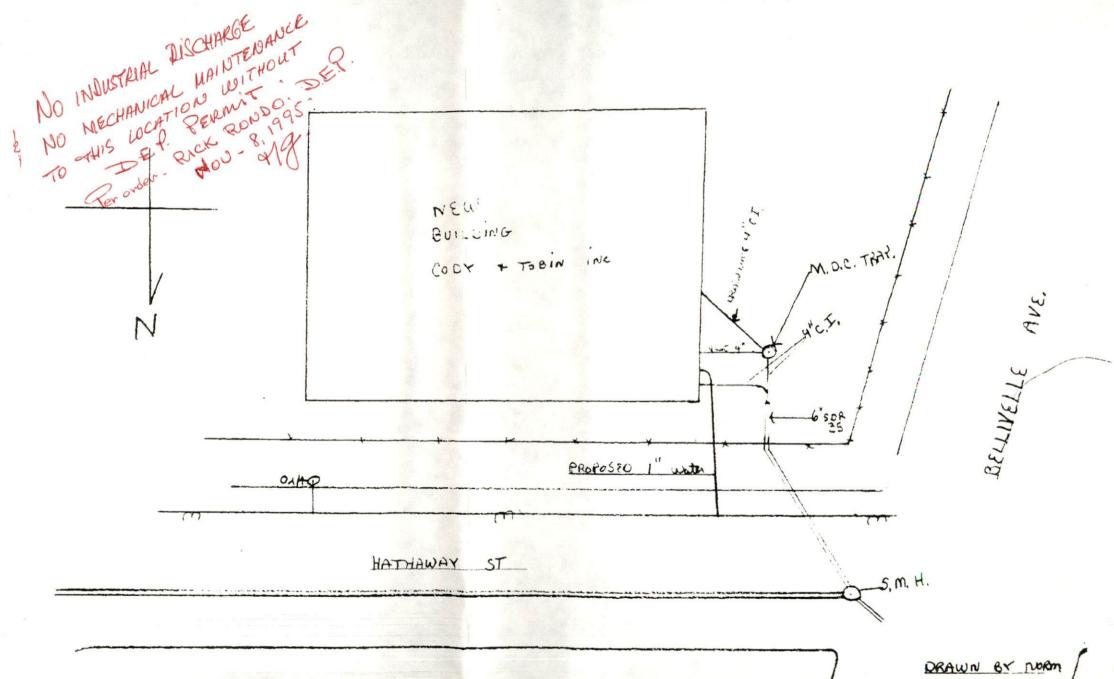

SCALE 1"= 20'