



CITY OF NEW BEDFORD

APPLICATION FOR CONNECTION TO
PUBLIC SANITARY SEWER AND/OR STORM DRAIN

Application No. 22363

Date 8/18/95

The undersigned hereby requests permission to connect a building sanitary and/or storm sewer from the premises located at 1793 Acushnet Ave, Assessors' Plot 108, Lot 81, to the public sanitary (storm sewer(s)) in Acushnet Ave; the same to be installed in accordance with the terms and conditions set forth herein, and the ordinances of the City of New Bedford.

Name of Property Owner: Mait. Oil Corp. 1148 Main St. Tel. 610-527-7900
Please Print Worcester, Ma.

Owner's Mailing Address: see attached permission slip

If application is being submitted by other than actual property owner, indicate that person's

Name: Franklin Bros. Inc. Tel. 9988270

Mailing Address: 4393 Acushnet Ave.

and attach Letter of Authorization from Property Owner hereto.

BONDED CONTRACTOR OR DRAIN LAYER MAKING INSTALLATION

Name: Franklin Bros. Inc. Tel. 9988270

Address: 4393 Acushnet Ave.

JOINT MAINTENANCE AGREEMENT REQUIRED

If this connection is to be part of a private service shared jointly with other building owners, attach copy of Recorded Joint Maintenance Agreement hereto.

PERMITS TO INDUSTRIAL AND/OR COMMERCIAL APPLICANTS

Permits can be issued to Industrial and/or Commercial Applicants only upon receipt and approval by the Commissioner of Public Works of such supplemental information, including drawings, composition and quantity data, and other pertinent information as he may require.

In addition, a valid Industrial User Discharge Permit issued by the City, and a valid Permit for Sewer System Extension or Connection issued by the Commonwealth of Massachusetts, Division of Water Pollution Control, shall be required for applicants wishing to discharge industrial wastes to the City's sewer system.

Industrial User Discharge Permit No. Date

Comm. Mass. Sewer Conn./Ext. Permit No. Date

TERMS

- a) Type of Pipe Required: pvc sdr-35
- b) Separate Sanitary and Storm connections are required where a 2 - pipe system exists in the street.
- c) All work must be inspected and approved by a D.P.W. Inspector, both in the street and on private property, before backfilling.
- d) A Filing and Inspection Fee of \$ 150.00, plus an Entrance Fee of \$ where applicable, must accompany this application.
- e) Other requirements: inspection only


Applicant agrees to abide by the above terms, as well as all pertinent ordinances of the City of New Bedford, and such other special rules as the Commissioner of Public Works may deem necessary.

Lawrence D. Warden
Commissioner of Public Works


Signature of Property Owner

By: Mary Rivers

By: Sean H. Bingham Tyrell
Signature of Owner's Representative

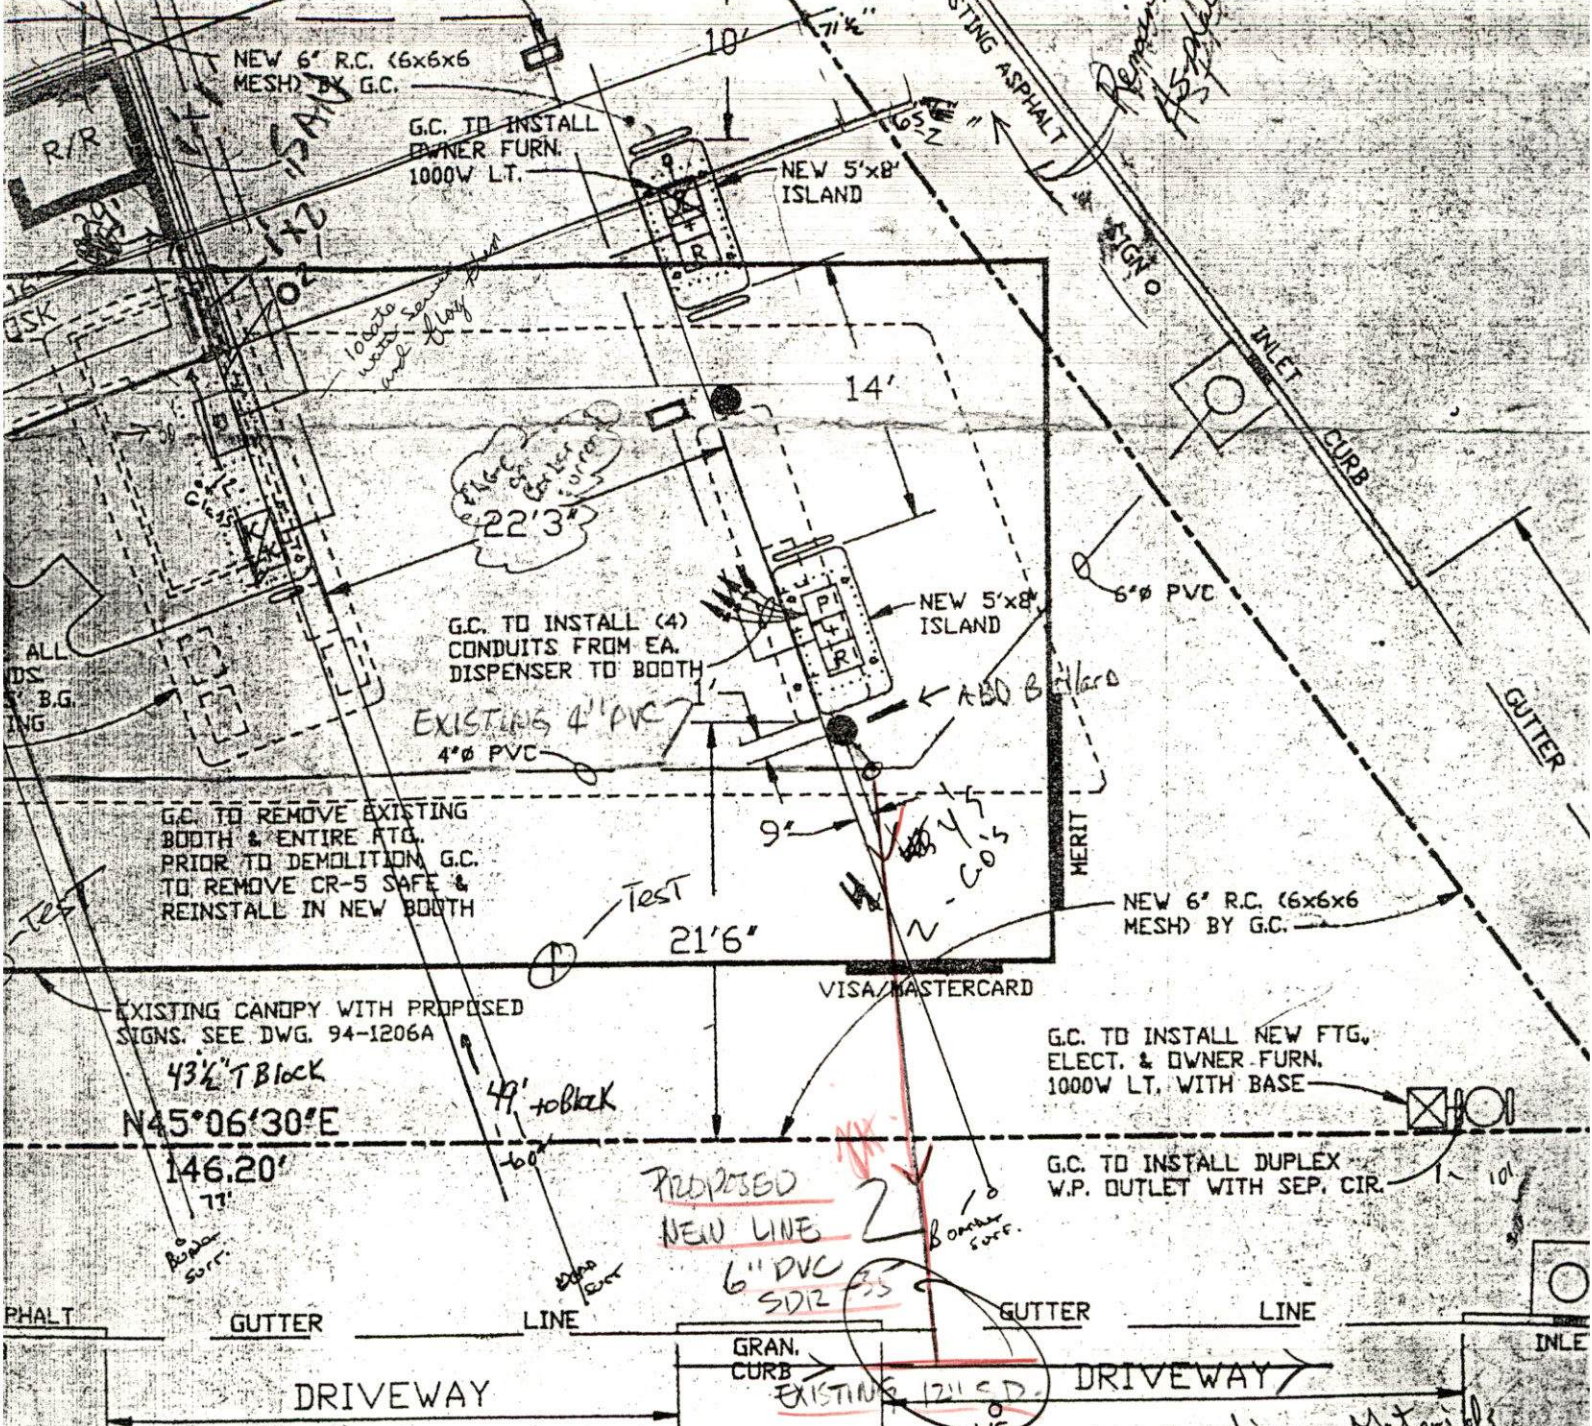

H N E T A V E
(TWO WAY TRAFFIC)

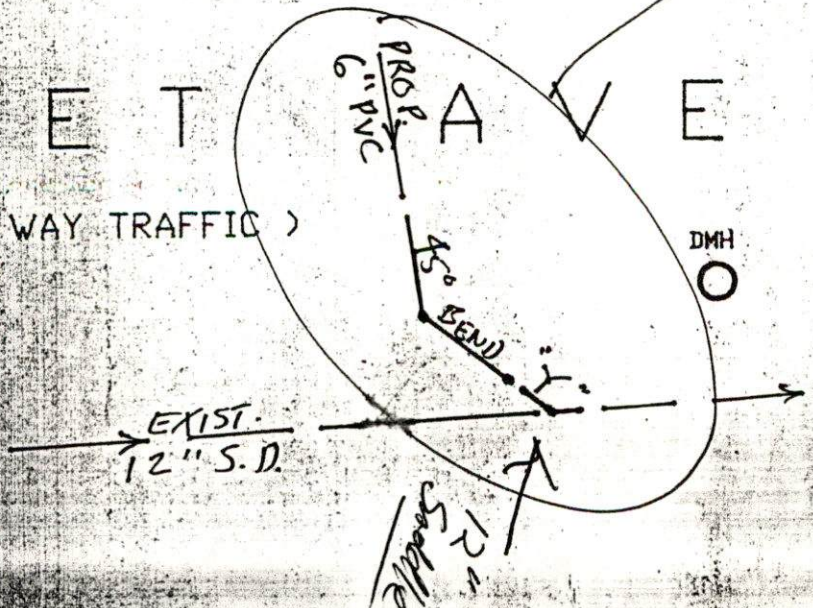

- Construction Materials West Part Gravel

Condi Can

Warwick

Remo