



CITY OF NEW BEDFORD

APPLICATION FOR CONNECTION TO
PUBLIC SANITARY SEWER AND/OR STORM DRAIN

Application No. 22380

Date 9/29/95

The undersigned hereby requests permission to connect a building sanitary and/or storm sewer from the premises located at Street 376 Nash Rd., Assessors' Plot 10.2... Lot 124., to the public sanitary/storm sewer(s) in Nash Rd. Street; the same to be installed in accordance with the terms and conditions set forth herein, and the ordinances of the City of New Bedford.

Name of Property Owner: Carl Ribeiro Please Print Tel. 993-9976

Owner's Mailing Address: 80 Old Knoll Rd. Marion 02738

If application is being submitted by other than actual property owner, indicate that person's

Name: James Corveia Tel. 990-4406

Mailing Address: 830 Haverhill Rd. N.D.

and attach Letter of Authorization from Property Owner hereto.

BONDED CONTRACTOR OR DRAIN LAYER MAKING INSTALLATION

Name: LaBonne Brothers, Inc. Tel. 478-1274

Address: P.O. Box 314 Mendon, Ma.

JOINT MAINTENANCE AGREEMENT REQUIRED

If this connection is to be part of a private service shared jointly with other building owners, attach copy of Recorded Joint Maintenance Agreement hereto.

PERMITS TO INDUSTRIAL AND/OR COMMERCIAL APPLICANTS

Permits can be issued to Industrial and/or Commercial Applicants only upon receipt and approval by the Commissioner of Public Works of such supplemental information, including drawings, composition and quantity data, and other pertinent information as he may require.

In addition, a valid Industrial User Discharge Permit issued by the City, and a valid Permit for Sewer System Extension or Connection issued by the Commonwealth of Massachusetts, Division of Water Pollution Control, shall be required for applicants wishing to discharge industrial wastes to the City's sewer system.

Industrial User Discharge Permit No. Date

Comm. Mass. Sewer Conn./Ext. Permit No. Date

TERMS

a) Type of Pipe Required: sdr-35 or duct tile

b) Separate Sanitary and Storm connections are required where a 2 - pipe system exists in the street.

c) All work must be inspected and approved by a D.P.W. Inspector, both in the street and on private property, before backfilling.

d) A Filing and Inspection Fee of \$ 150.00, plus an Entrance Fee of \$ where applicable, must accompany this application.

e) Other requirements:

Applicant agrees to abide by the above terms, as well as all pertinent ordinances of the City of New Bedford, and such other special rules as the Commissioner of Public Works may deem necessary.


Lawrence D. Worden
Commissioner of Public Works

Signature of Property Owner

By:

By: James R. Corveia

Signature of Owner's Representative

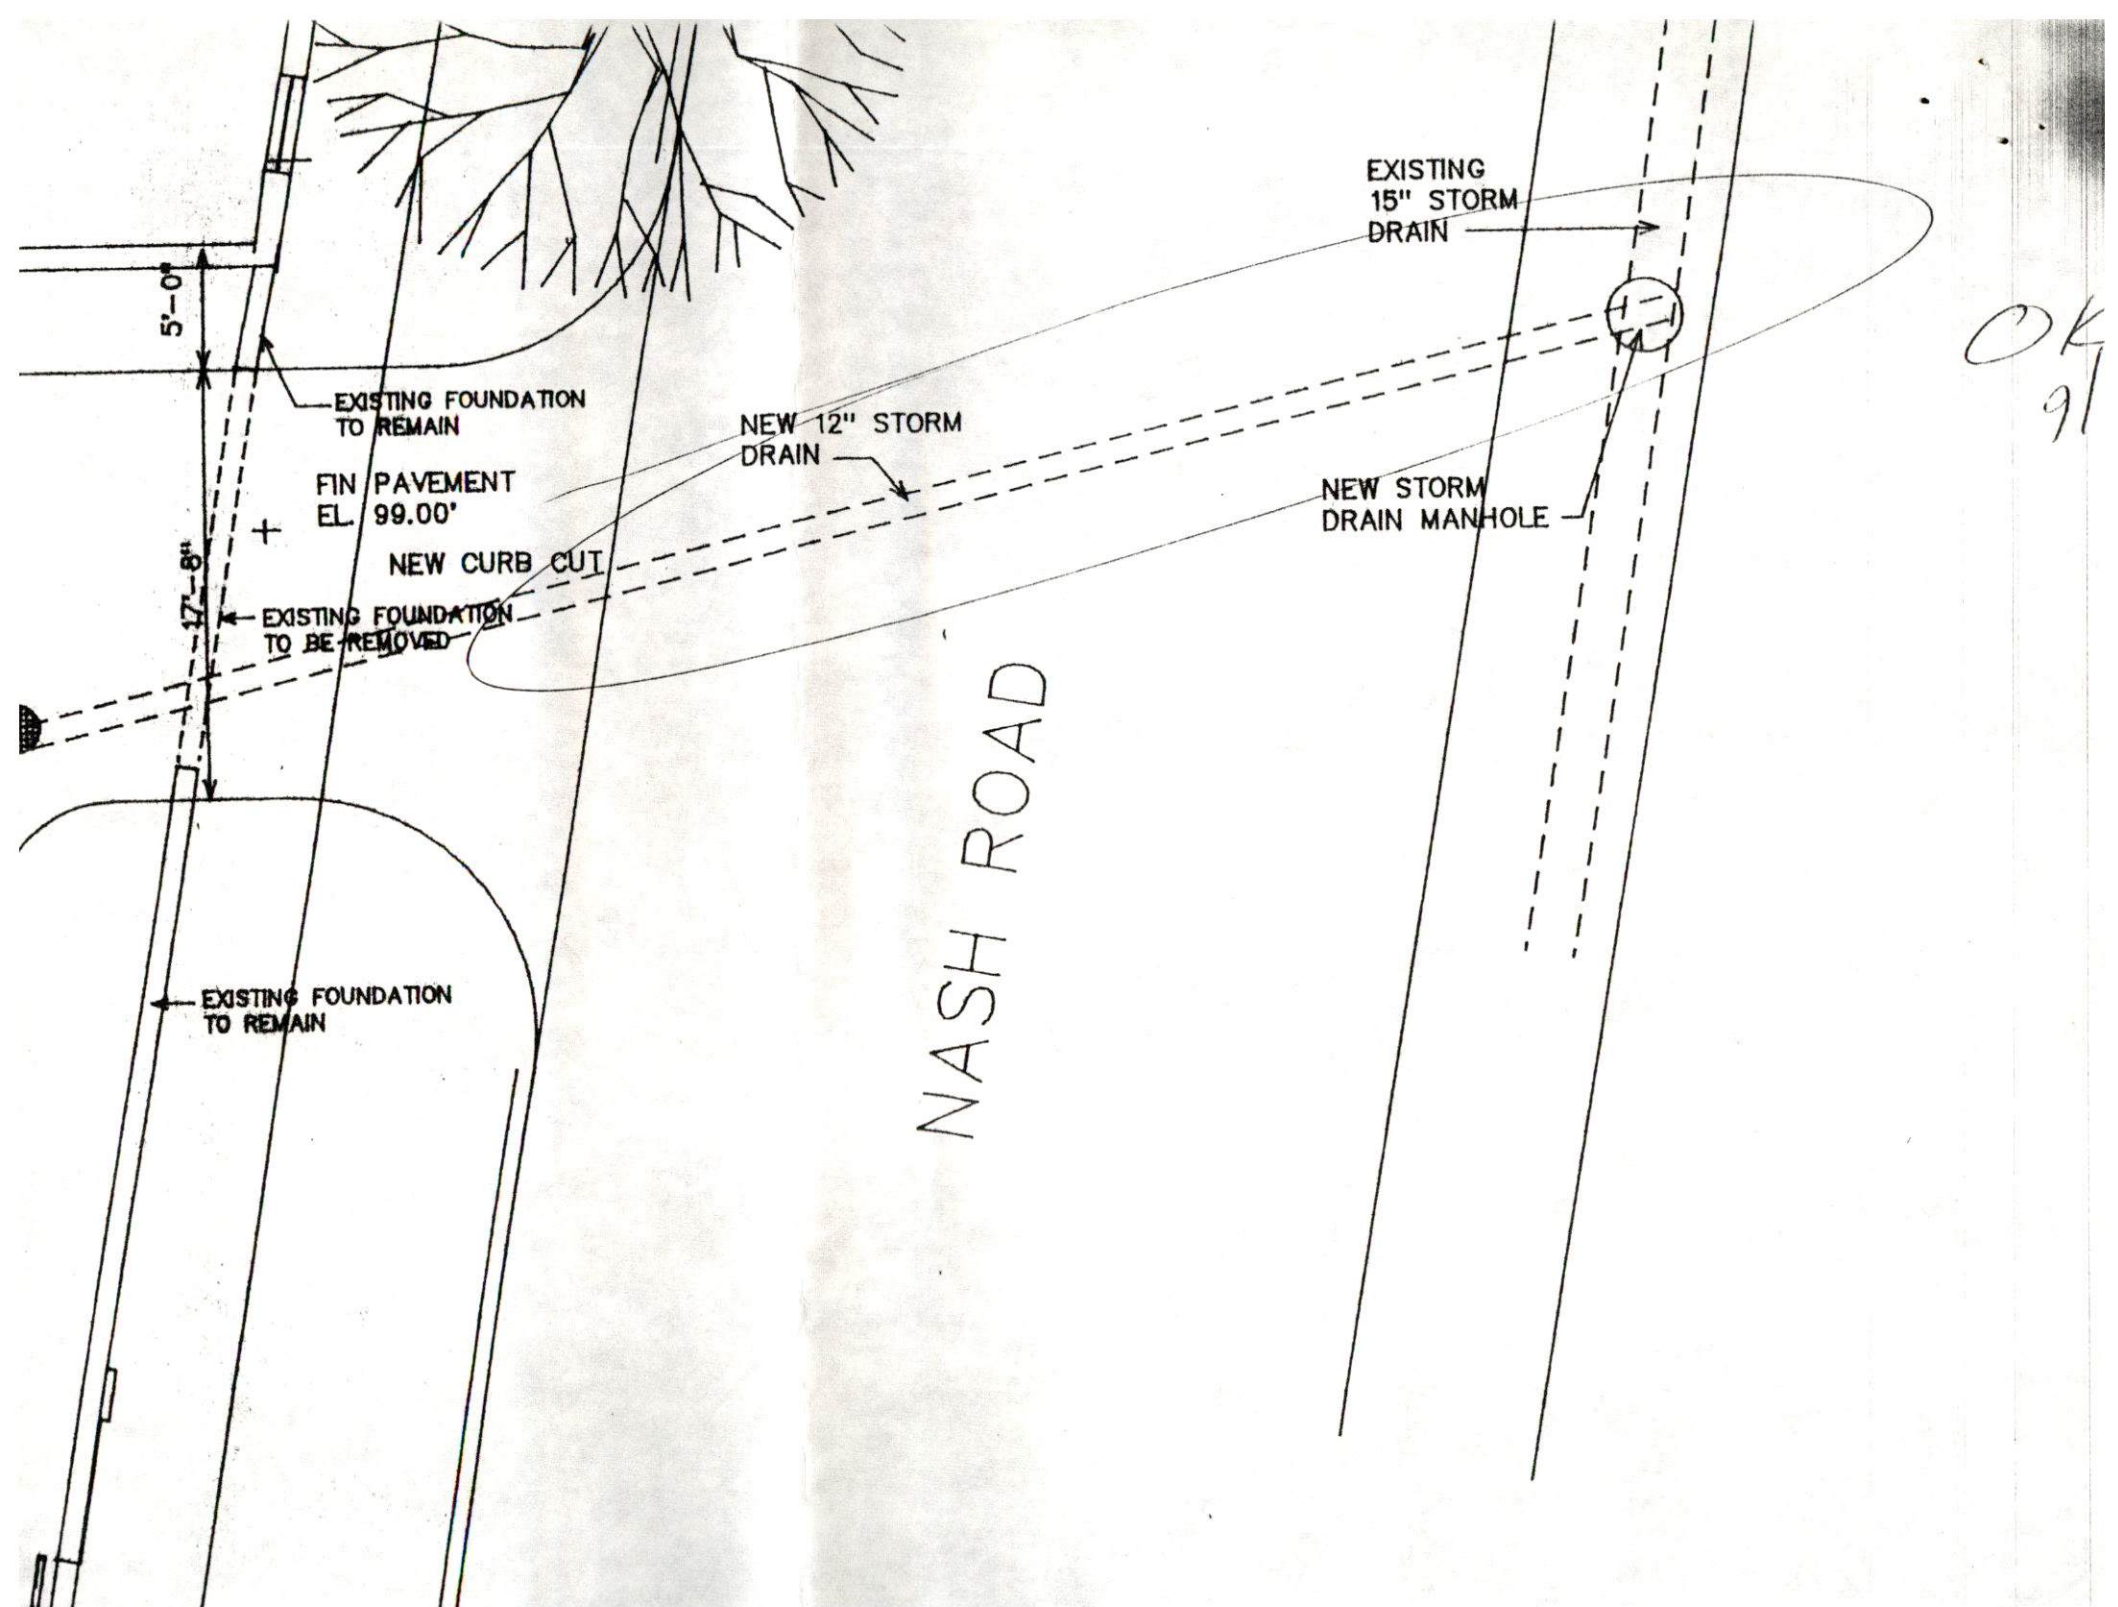




September 29, 1995

To Whom It May concern:

I, Carl Ribeiro, Owner of the property located at 376 Nash Road and 105-115 Church Street, New Bedford, designate James R. Correia, Constuction Manager, to be my agent in applying for permits or licenses regarding the renovation and constuction project under way at the above location.

Respectfully,

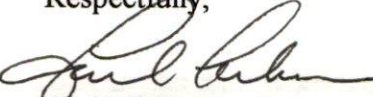

Carl Ribeiro

LUZO MAXI-MARKET

384 Nash Road (Rear)
New Bedford, Massachusetts 02746
(508) 999-1771



LUZO FOODSERVICE CORPORATION

376 Nash Road, P.O. Box 50370
New Bedford, Massachusetts 02745
(508) 993-9976 FAX (508) 997-8357



LUZO MAXI-MARKET

147 Plymouth Avenue
Fall River, Massachusetts 02721
(508) 675-8580